PARENT PARCEL: 05-00-018-106-024, 063, 064

CHILD PARCEL: 05-00-018-106-088 THRU 093

STARTING POINT: C/Ls NORTH LAKE STREET & WEST MARTIN AVENUE

NO. 22660

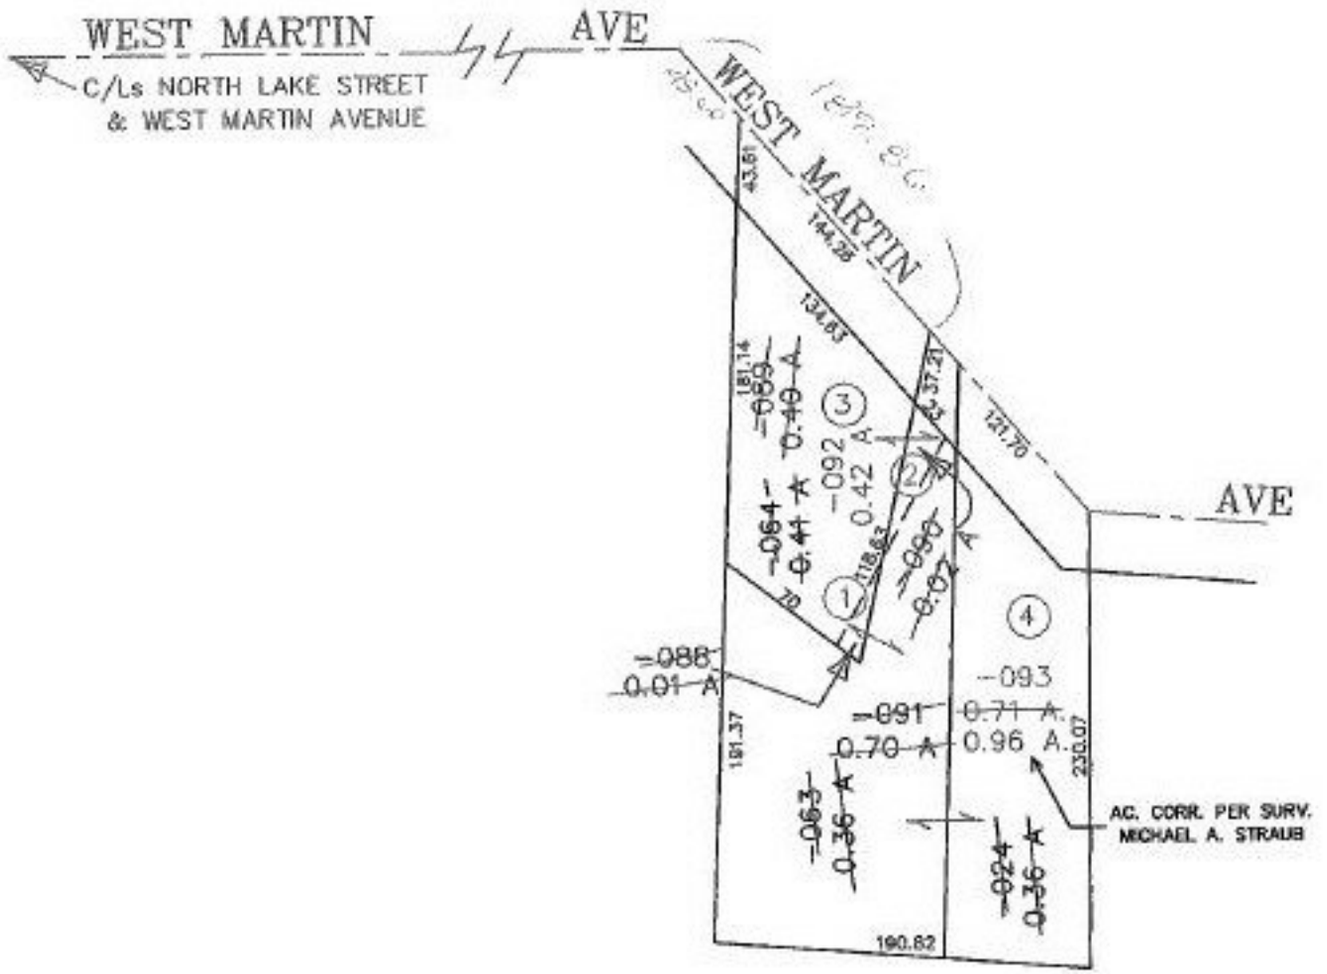

SPLITS/DEEDS PROCESSED

LORAIN COUNTY TAX MAP DEPARTMENT

226 MIDDLE AVE. ELYRIA, OHIO

SURVEYED BY: MICHAEL A STRAUB

CLOSURE: 0.03 / 10,000

MAP PAGE(S): 5-00-018-B

APPROVED BY: F. COLBERT DATE: 10/2/98

SCALE: 1" = 100 PRIOR INSTRUMENT: 388/577 1136/386