PARENT PARCEL: 04-00-019-138-028 & -032
CHILD PARCEL: 04-00-019-138-033 THRU -038
STARTING POINT: P.K. SPIKE AT, CL OF LEAR NAGLE RD. & CL OF DIVISION RD.

NO. 22665

DETAIL 1"=50'

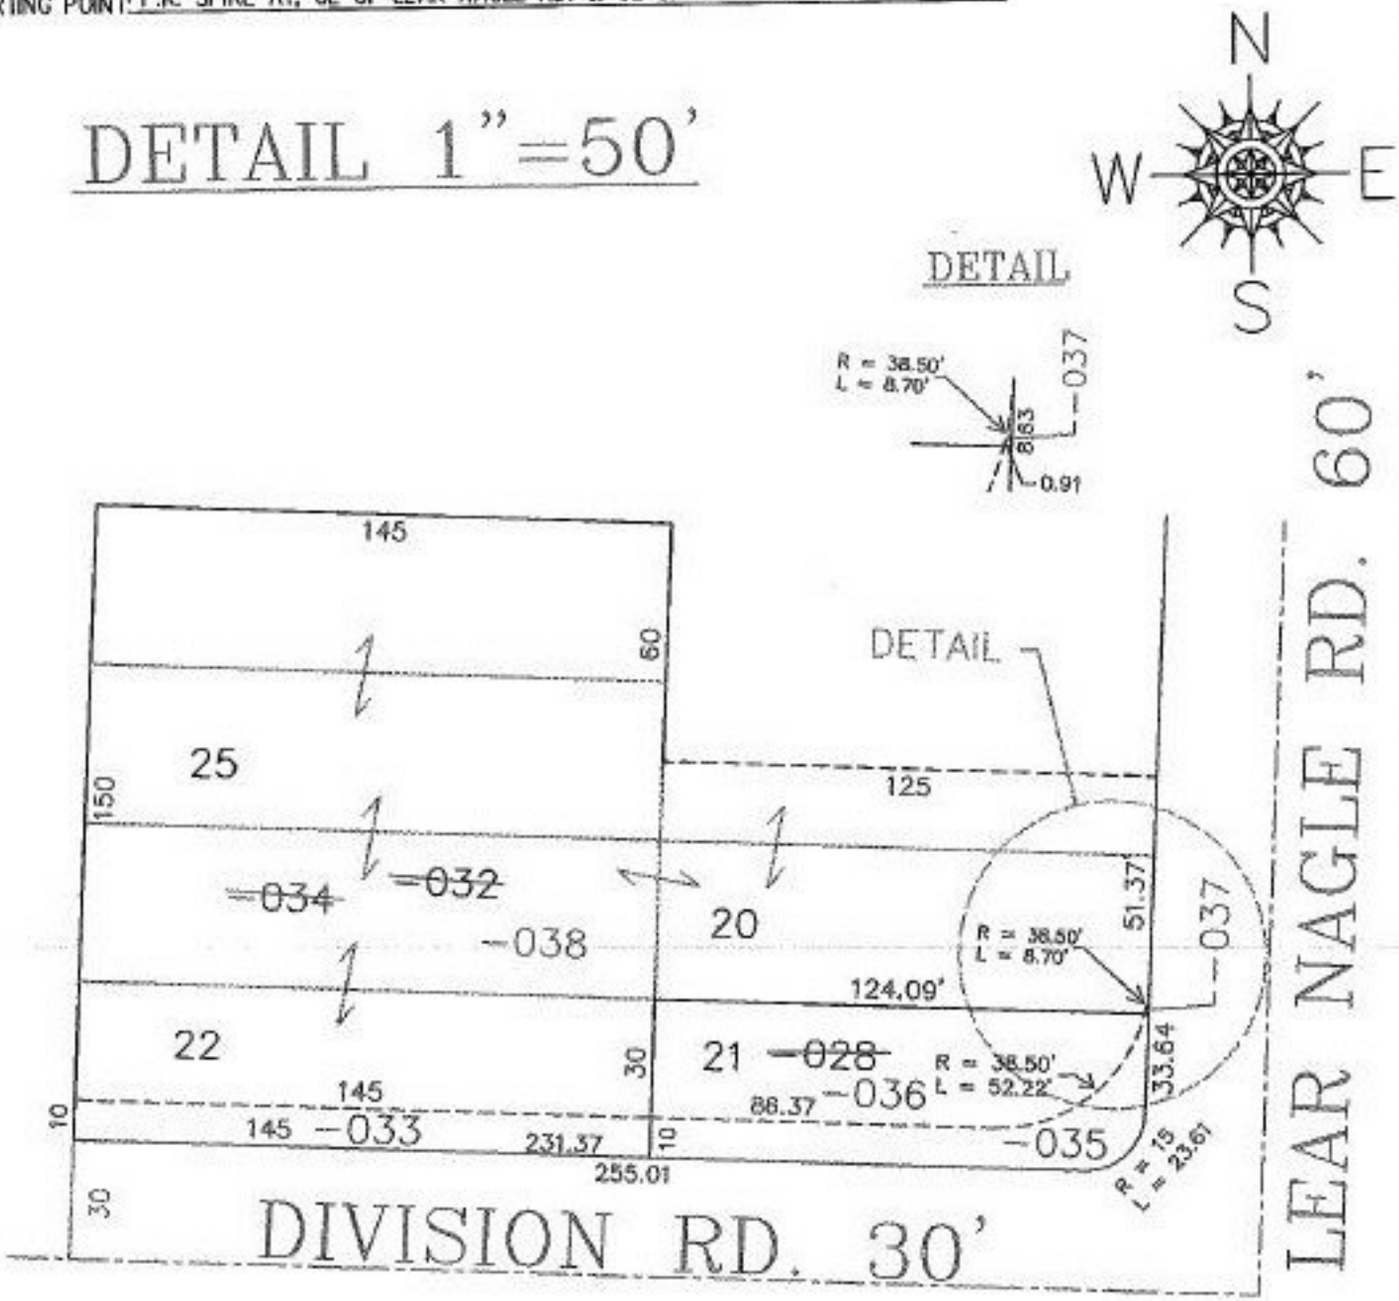

2 OF 3

SPLITS/DEEDS PROCESSED

LORAIN COUNTY TAX MAP DEPARTMENT
226 MIDDLE AVE. ELYRIA, OHIO

SURVEYED BY: THOMAS A. SIMON
CLOSURE: 0.11 : 10,000
MAP PAGE(S): 04-00-019-D
APPROVED BY: TJS DATE: 10/21/98
SCALE: 1"= 100 PRIOR INSTRUMENT: OR 269/336