PARENT PARCEL: 06-24-012-101-007, -008, & -012

CHILD PARCEL: 06-24-012-101-018 THRU -020

STARTING POINT: CL OF LOWELL ST. & CL OF HURON ST.

NO. 22666

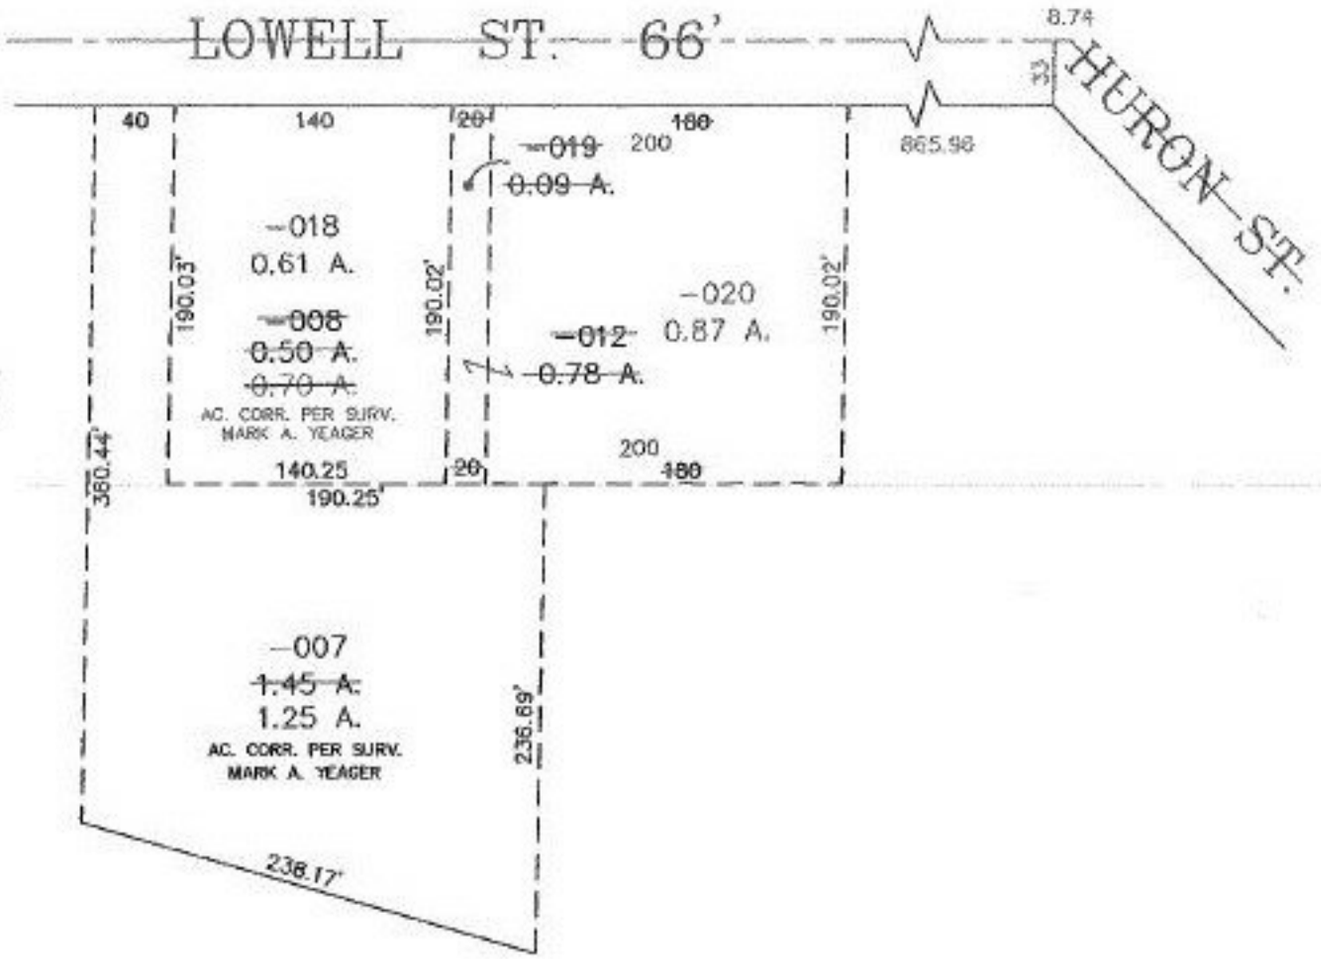

PRIOR INSTRUMENT: DV 908/588

PRIOR INSTRUMENT: DV 932/918

SPLITS/DEEDS PROCESSED

LORAIN COUNTY TAX MAP DEPARTMENT

226 MIDDLE AVE. ELYRIA, OHIO

SURVEYED BY: MARK A. YEAGER

CLOSURE: 0.09 ; 10,000

MAP PAGE(S): 6-96

APPROVED BY: TJS DATE: 10/13/98

SCALE: 1"= 100