PARENT PARCEL: 04-00-024-111-005

CHILD PARCEL: 04-00-024-111-094 & -095

STARTING POINT: BEGINNING ON THE EST LINE OF JAYCOX RD. & THE S.W. CORNER OF S\L 1

NO. 22673

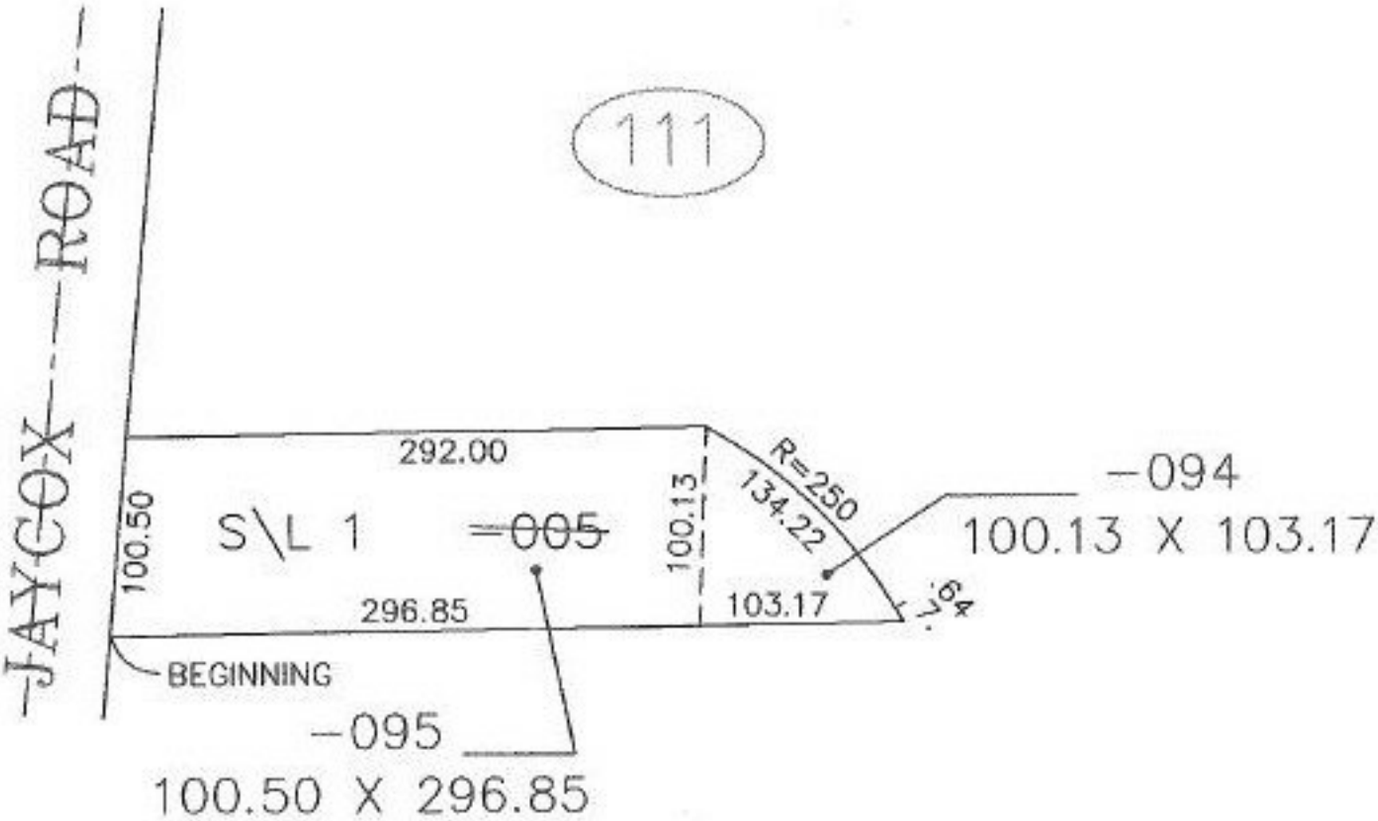

SPLITS/DEEDS PROCESSED

LORAIN COUNTY TAX MAP DEPARTMENT
226 MIDDLE AVE. ELYRIA, OHIO

SURVEYED BY: RICHARD A. THOMPSON JR.

CLOSURE: 0.32 : 10,000

MAP PAGE(S): 04-00-024-B

APPROVED BY: TJS DATE: 10/30/98

SCALE: 1" = 100 PRIOR INSTRUMENT: OR 555/748