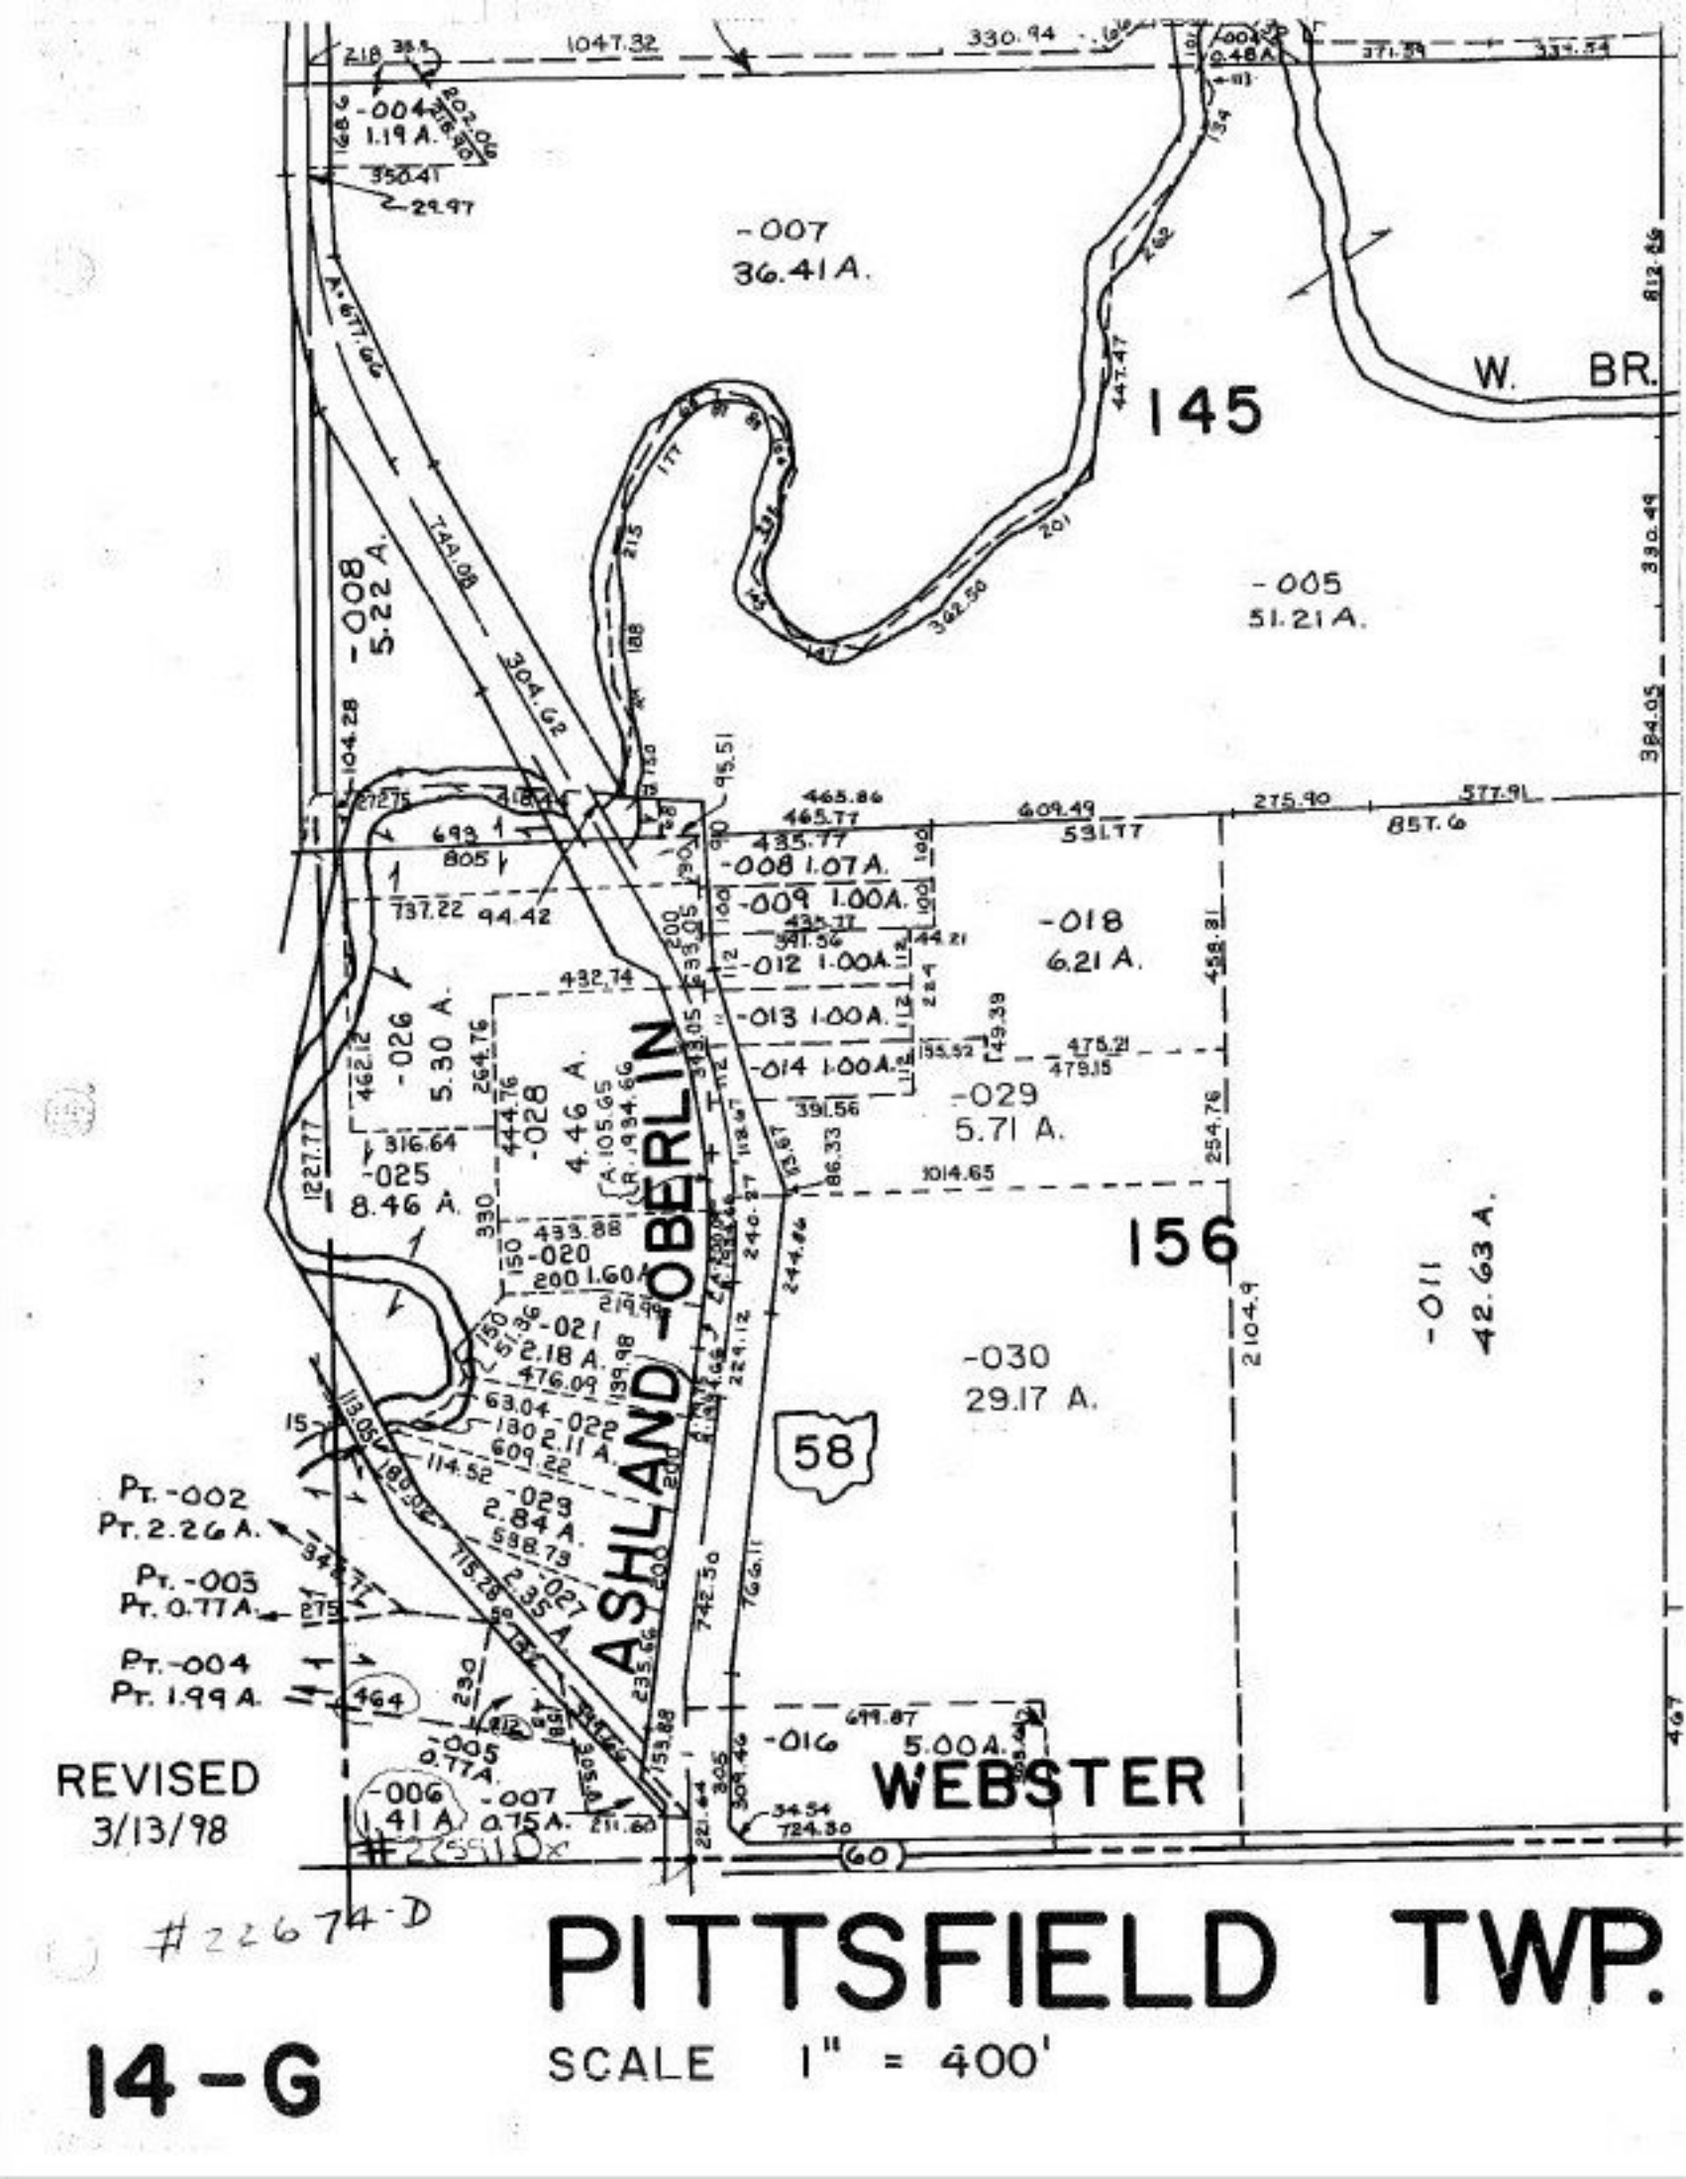
-007
36.41 A.
145
W. BR.
-008
5.22 A.
-005
51.21 A.
-018
6.21 A.
-026
5.30 A.
-028
4.46 A.
-025
8.46 A.
-029
5.71 A.
156
-011
42.63 A.
-030
29.17 A.
ASHLAND - OBERLIN
58
WEBSTER
Pt. -002
Pt. 2.26 A.
Pt. -003
Pt. 0.77 A.
Pt. -004
Pt. 1.99 A.
REVISED
3/13/98
#22674-D
PITTSFIELD TWP.
14-G
SCALE 1" = 400'