PARENT PARCEL: 04-00-022-101-001, -002, -003, -005, & -047

CHILD PARCEL: 04-00-022-101-049

STARTING POINT: I.P. MON., AT INTERSECTION OF THE NORTH LINE OF O.L. 22, & CL OF JAYCOX RD.

NO. 22682

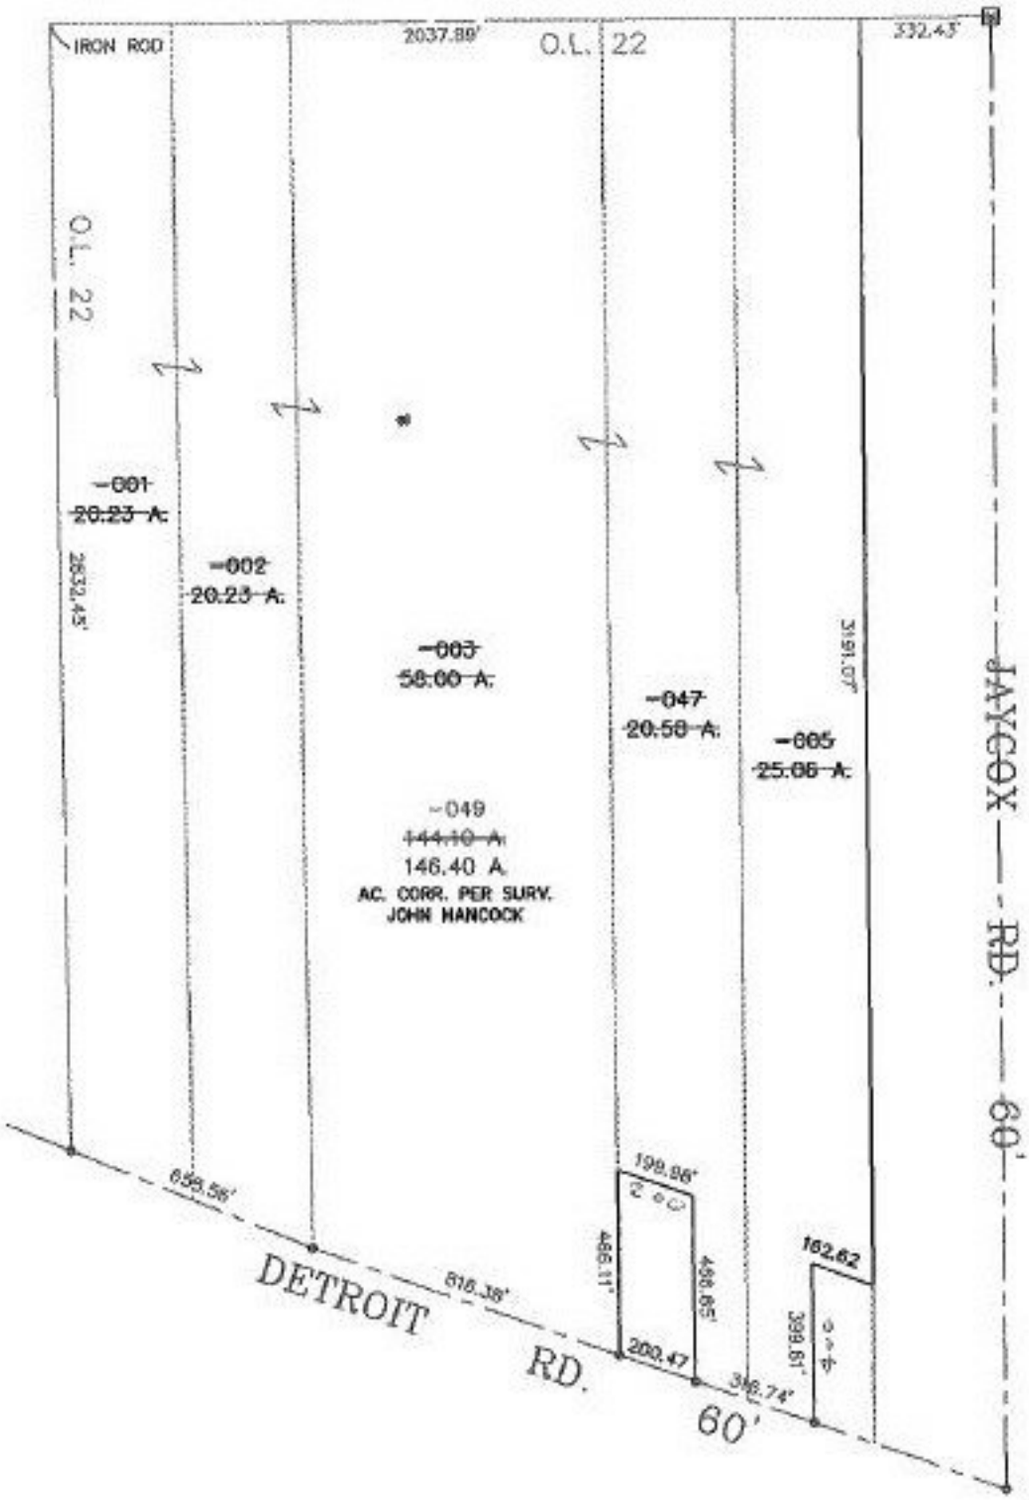

○ R.R.S.

PRIOR INSTRUMENT: 980515845

PRIOR INSTRUMENT: 980515846

PRIOR INSTRUMENT: 970503964

SPLITS/DEEDS PROCESSED

LORAIN COUNTY TAX MAP DEPARTMENT

226 MIDDLE AVE. ELYRIA, OHIO

SURVEYED BY: JOHN HANCOCK

CLOSURE: 0.01 : 10,000

MAP PAGE(S): 04-00-022-A, B & F, E

APPROVED BY: TJS DATE: 10/26/98

SCALE: 1" = 500