PARENT PARCEL: 11-00-070-000-067, & -082

CHILD PARCEL: 11-00-069-000-006, 11-00-070-000-114 THRU -116

STARTING POINT: CL OF BUTTERNUT RIDGE RD. & IT'S INTERSECTION WITH WEST LINE OF O.L. 69

NO. 22687

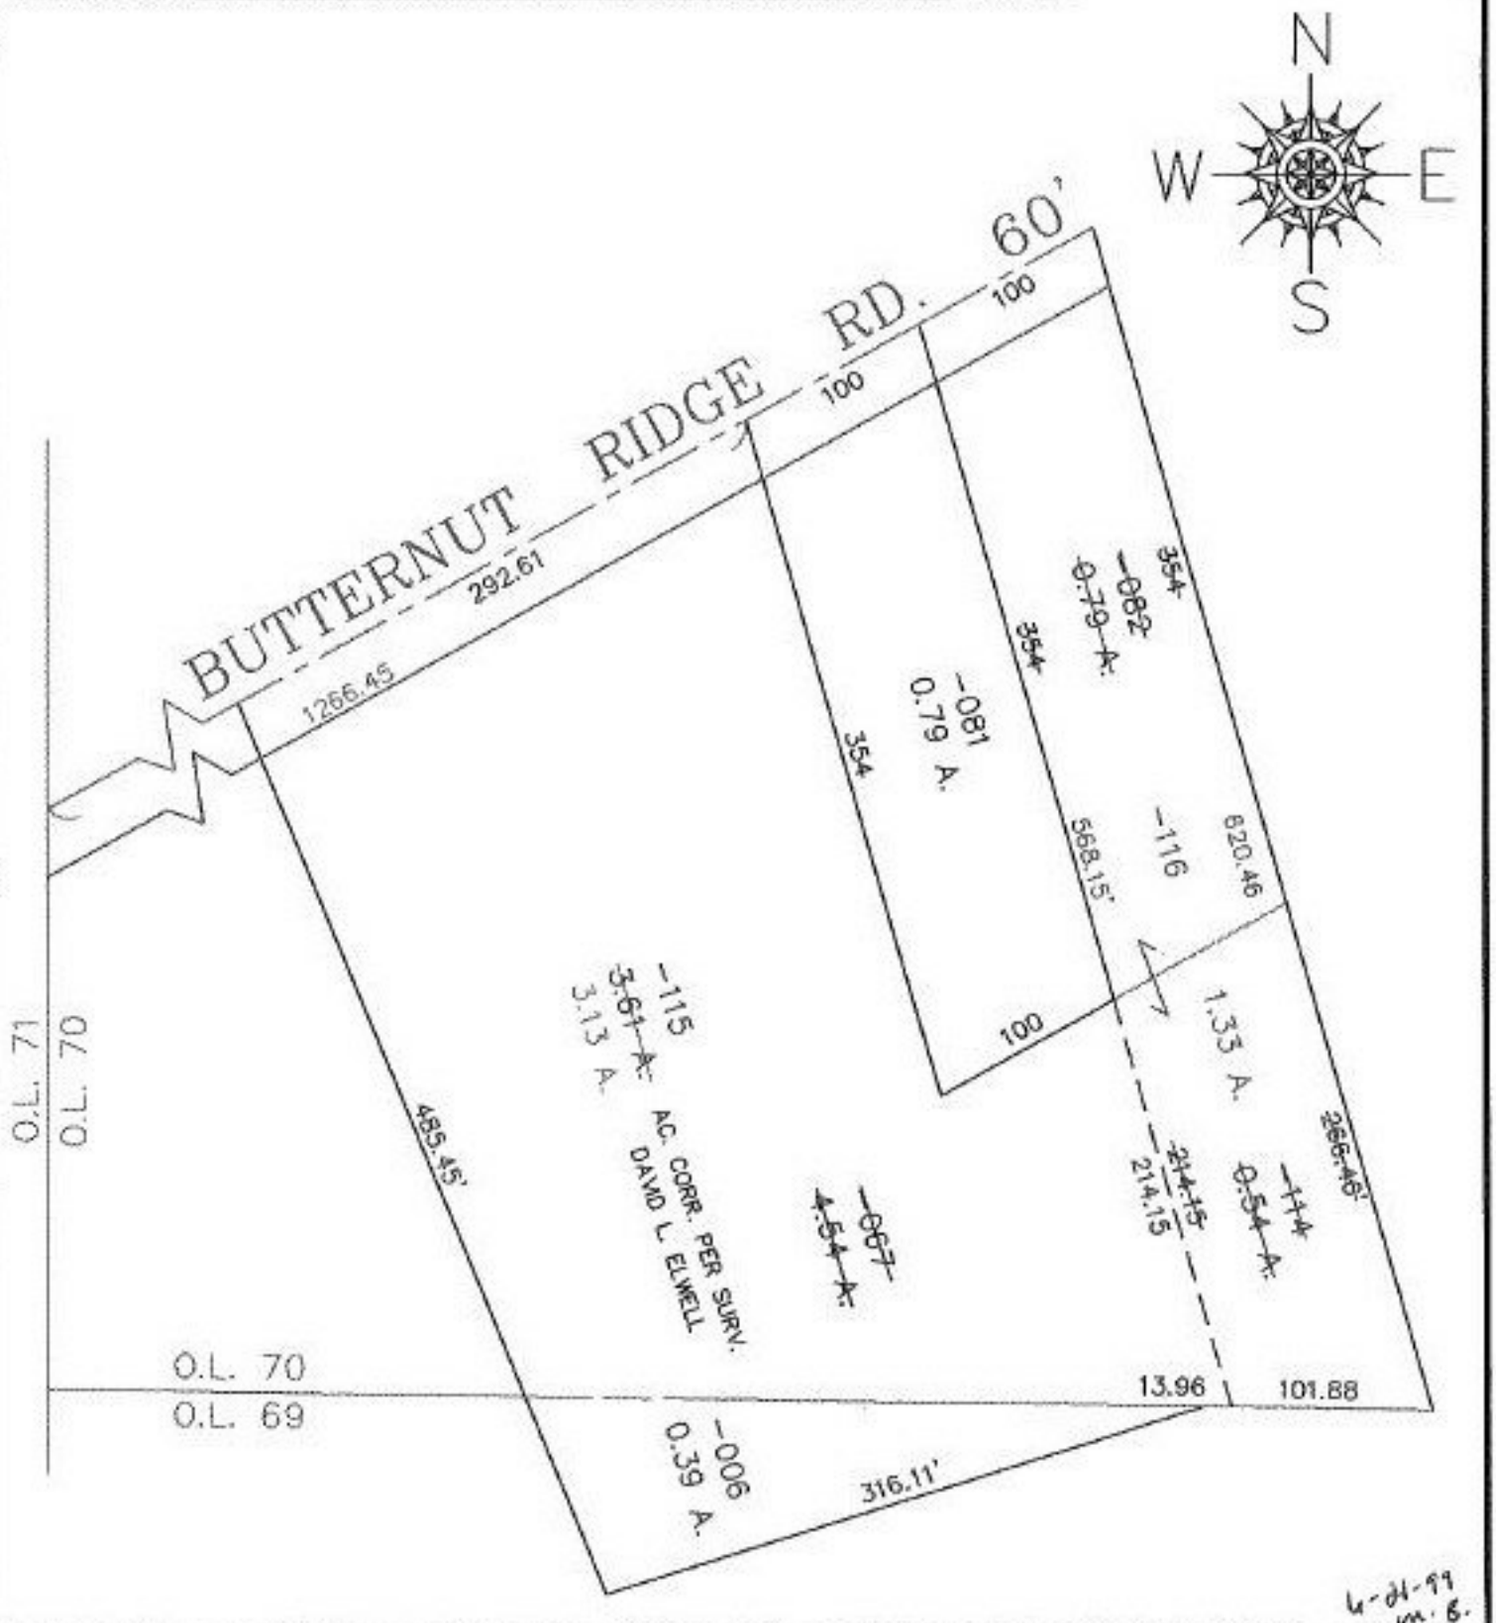

4-21-99 M. B.

SPLITS/DEEDS PROCESSED

LORAIN COUNTY TAX MAP DEPARTMENT
226 MIDDLE AVE. ELYRIA, OHIO

SURVEYED BY: DAVID L. ELWELL

CLOSURE: 0.09 : 10,000

MAP PAGE(S): 11-00-070-A, & 11-B

APPROVED BY: TJS DATE: 11/02/98

SCALE: 1" = 100 PRIOR INSTRUMENT: OR 117/490