PARENT PARCEL: 05-00-087-000-052, -053, & -054

CHILD PARCEL: 05-00-087-000-066

STARTING POINT: CL OF ELYRIA-MILAN RD. & CL OF WEST RIDGE RD.

NO. 22688

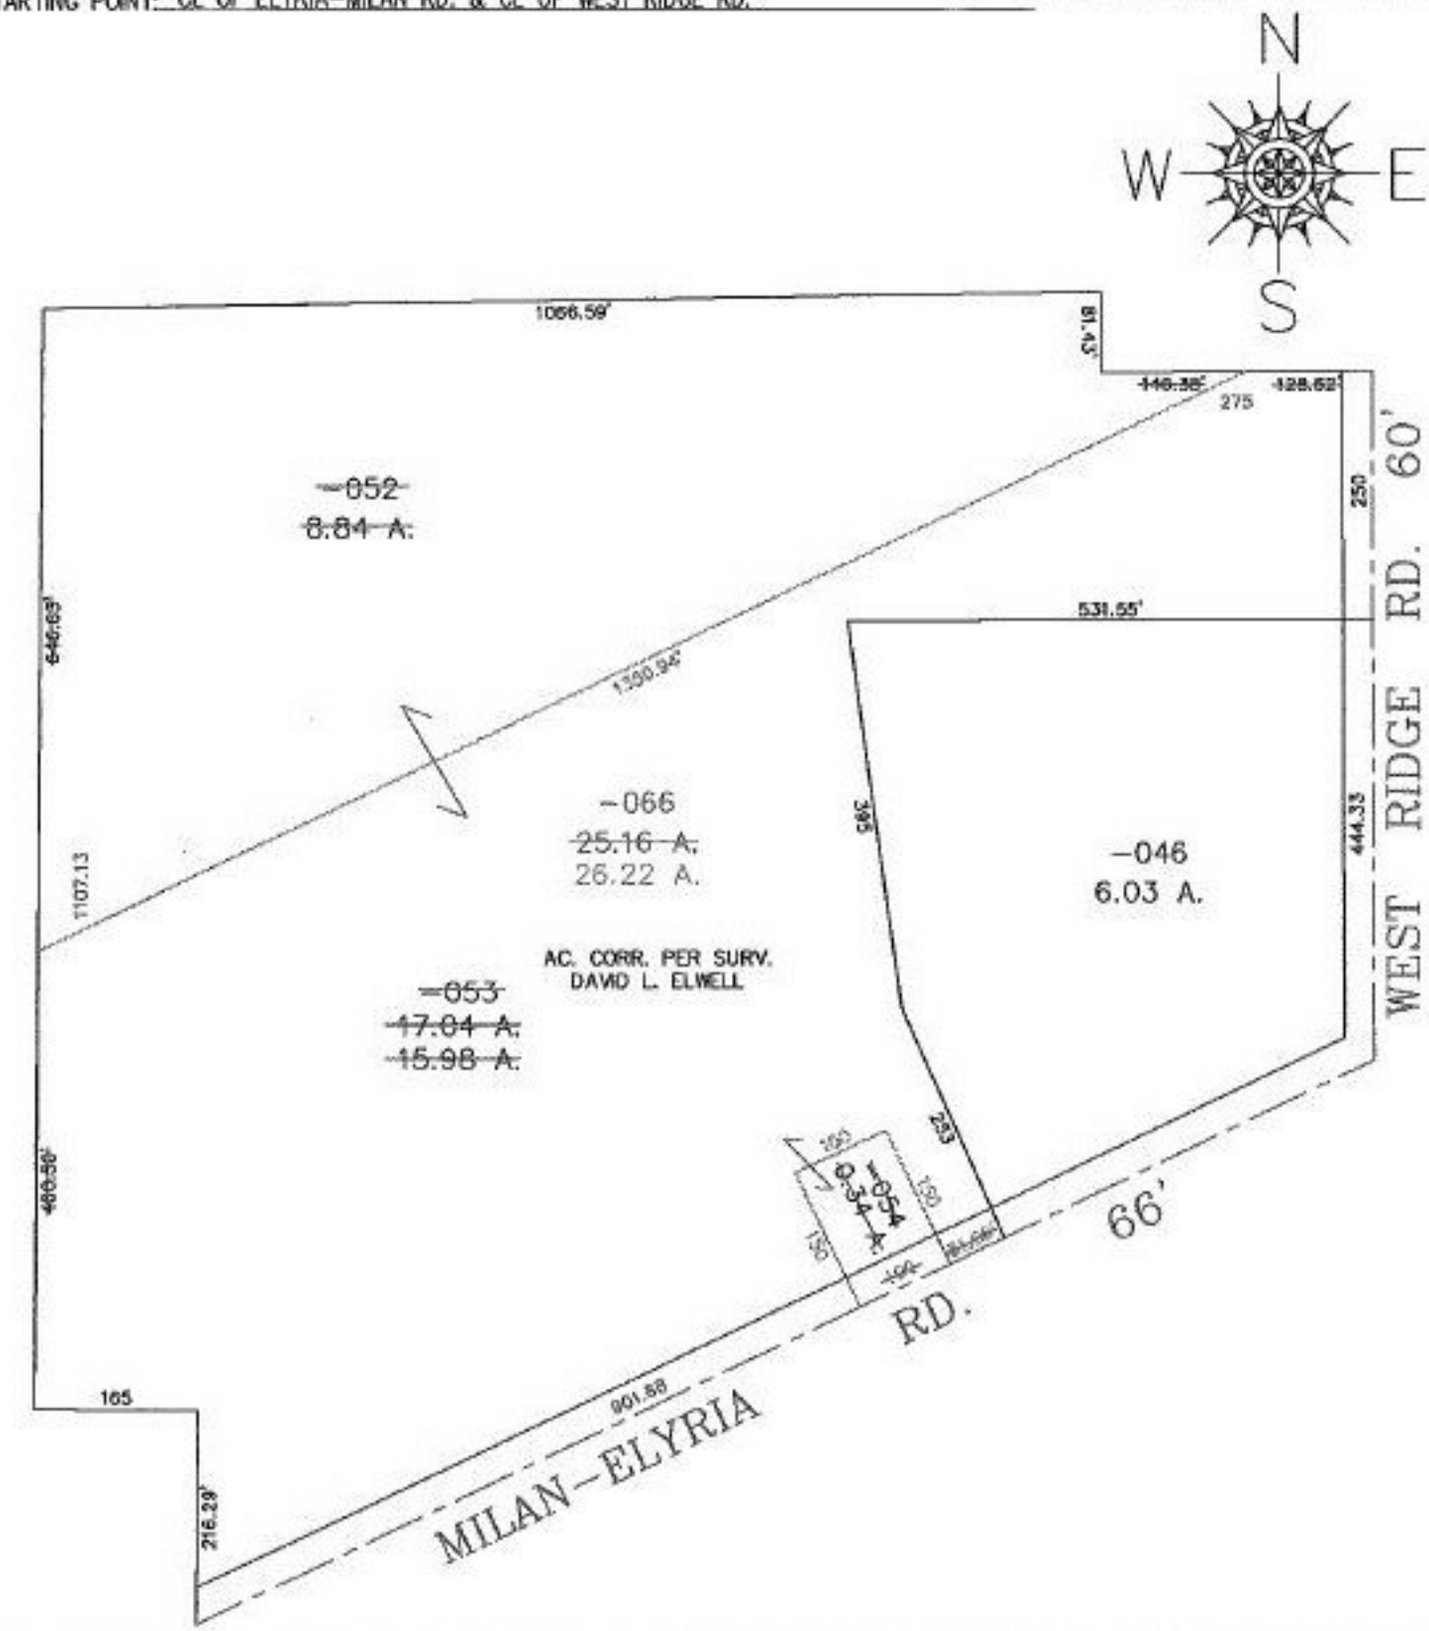

SPLITS/DEEDS PROCESSED

LORAIN COUNTY TAX MAP DEPARTMENT
226 MIDDLE AVE. ELYRIA, OHIO

SURVEYED BY: DAVID L. ELWELL

CLOSURE: 0.03 : 10,000

MAP PAGE(S): 05-00-087

APPROVED BY: TJS DATE: 11/02/98

SCALE: 1" = 200 PRIOR INSTRUMENT: OR 1368/21.25