PARENT PARCEL: 06-25-031-114-033

CHILD PARCEL: 06-25-031-114-038 THRU -063

STARTING POINT: COMMENCING AT A REBAR FOUND AT THE INTERSECTION OF THE NORTHERLY ROW OF HILLIARD RD. & WESTERLY ROW OF ABBE RD.

NO. 22690

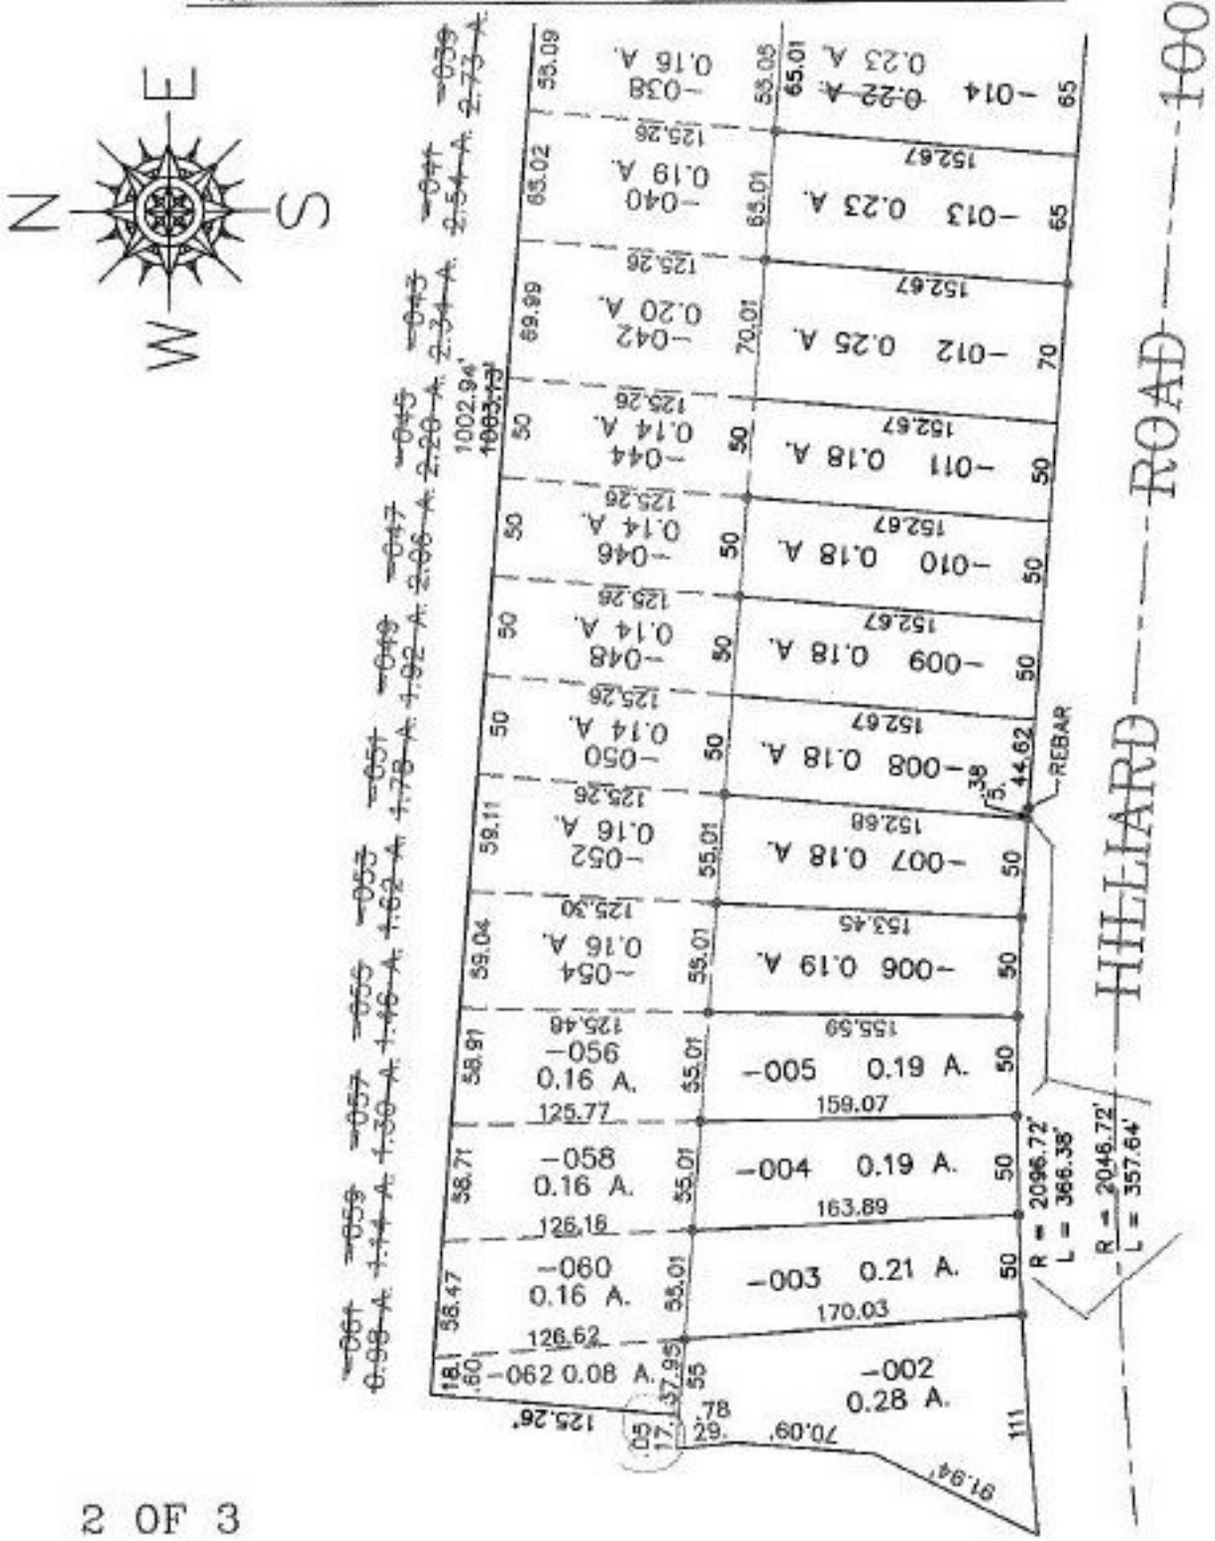

2 OF 3

SPLITS/DEEDS PROCESSED

LORAIN COUNTY TAX MAP DEPARTMENT
226 MIDDLE AVE. ELYRIA, OHIO

SURVEYED BY: DAVID L. ELWELL

CLOSURE: 0.26 : 10,000

MAP PAGE(S): 6-70

APPROVED BY: TJS DATE: 11/09/98

SCALE: 1" = 100 PRIOR INSTRUMENT: 980554691