PARENT PARCEL: 20-20-014-000-015
CHILD PARCEL: 20-20-014-000-022 THRU -025
STARTING POINT: CL OF STOCKING RD. & CL OF GORE ORPHANAGE RD.

NO. 22697

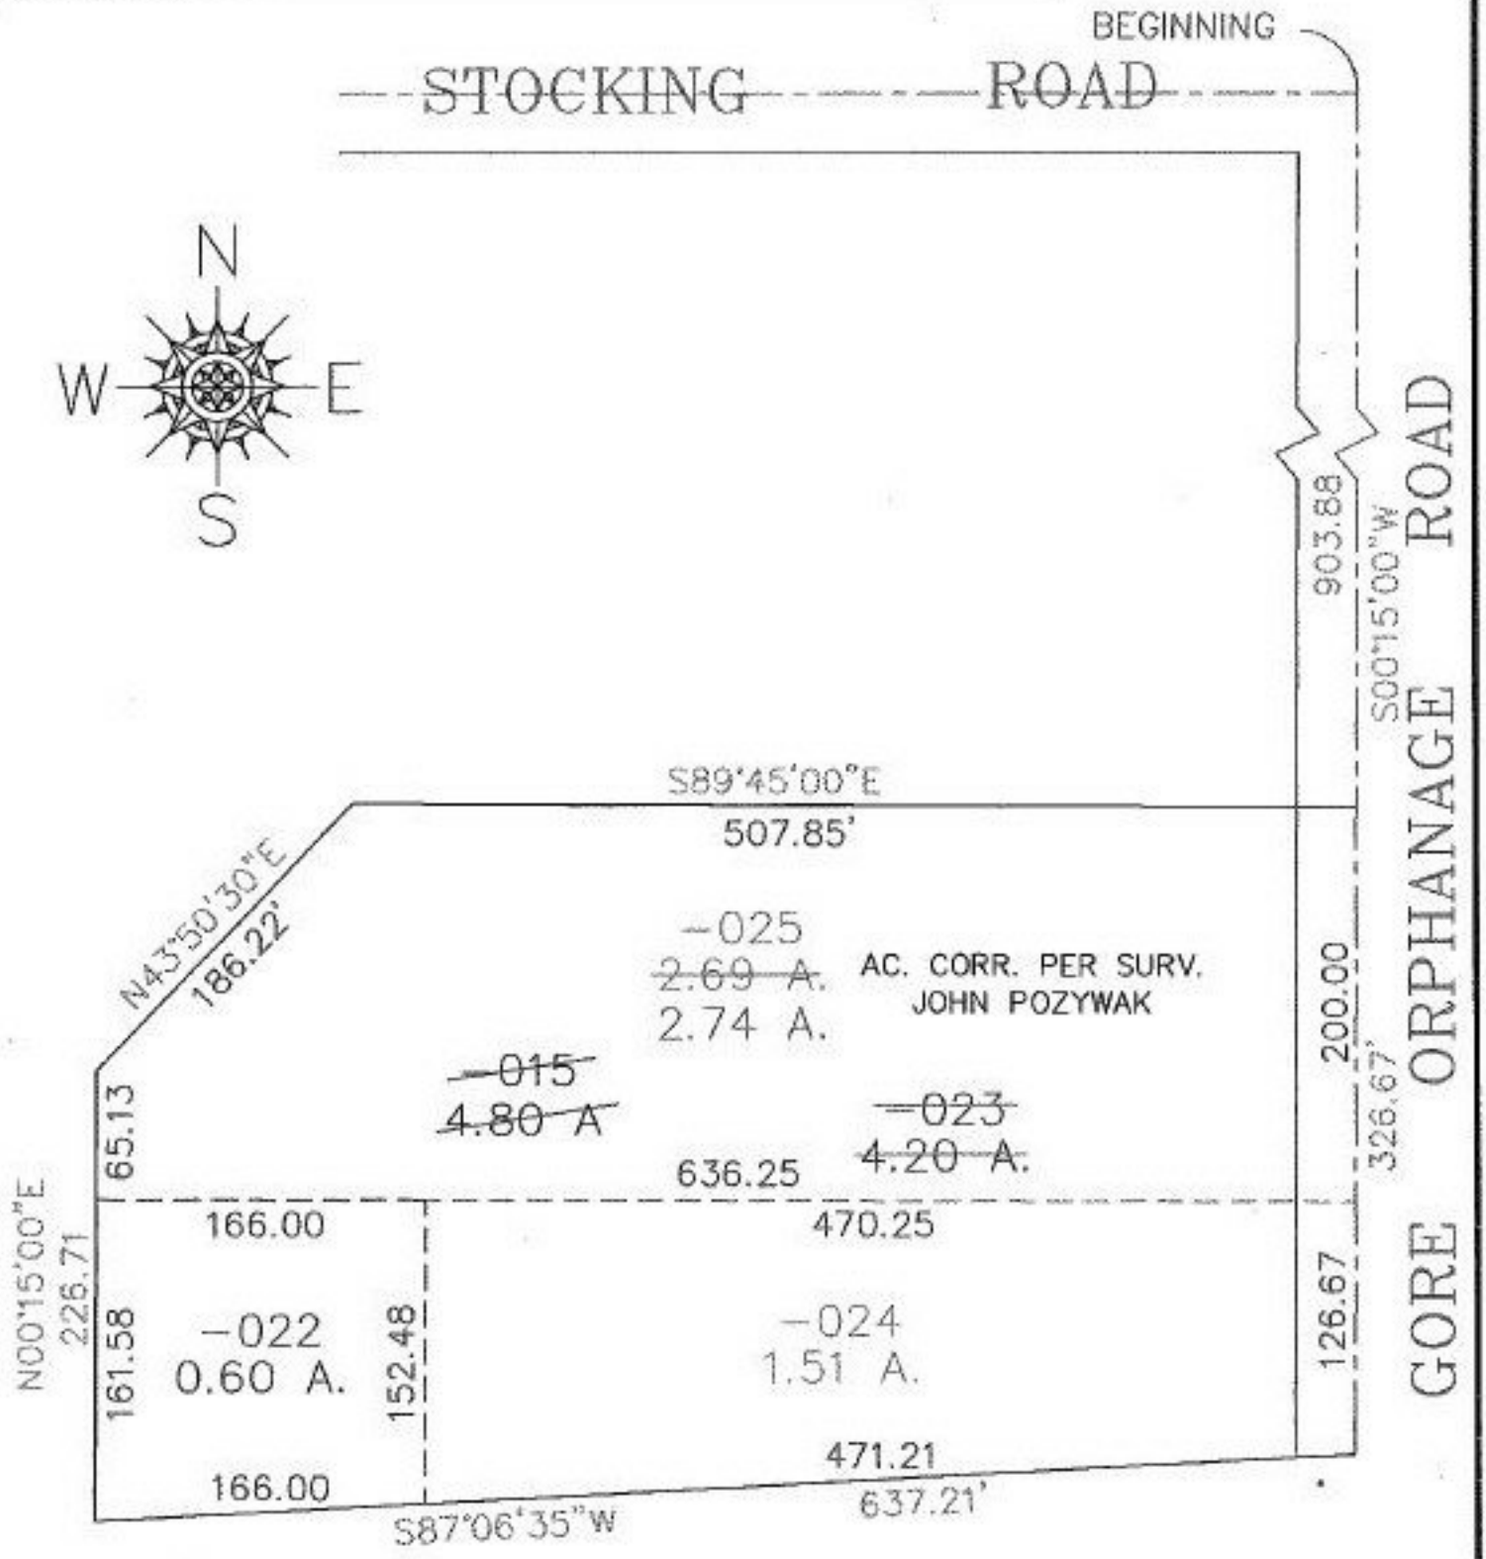

NC 1-6-99

SPLITS/DEEDS PROCESSED

LORAIN COUNTY TAX MAP DEPARTMENT
226 MIDDLE AVE. ELYRIA, OHIO

SURVEYED BY: JOHN POZYWAK
CLOSURE: 0.12 : 10,000
MAP PAGE(S): 20-B
APPROVED BY: TJS DATE: 10/30/98
SCALE: 1"= 100 PRIOR INSTRUMENT: OR 1128/522

8