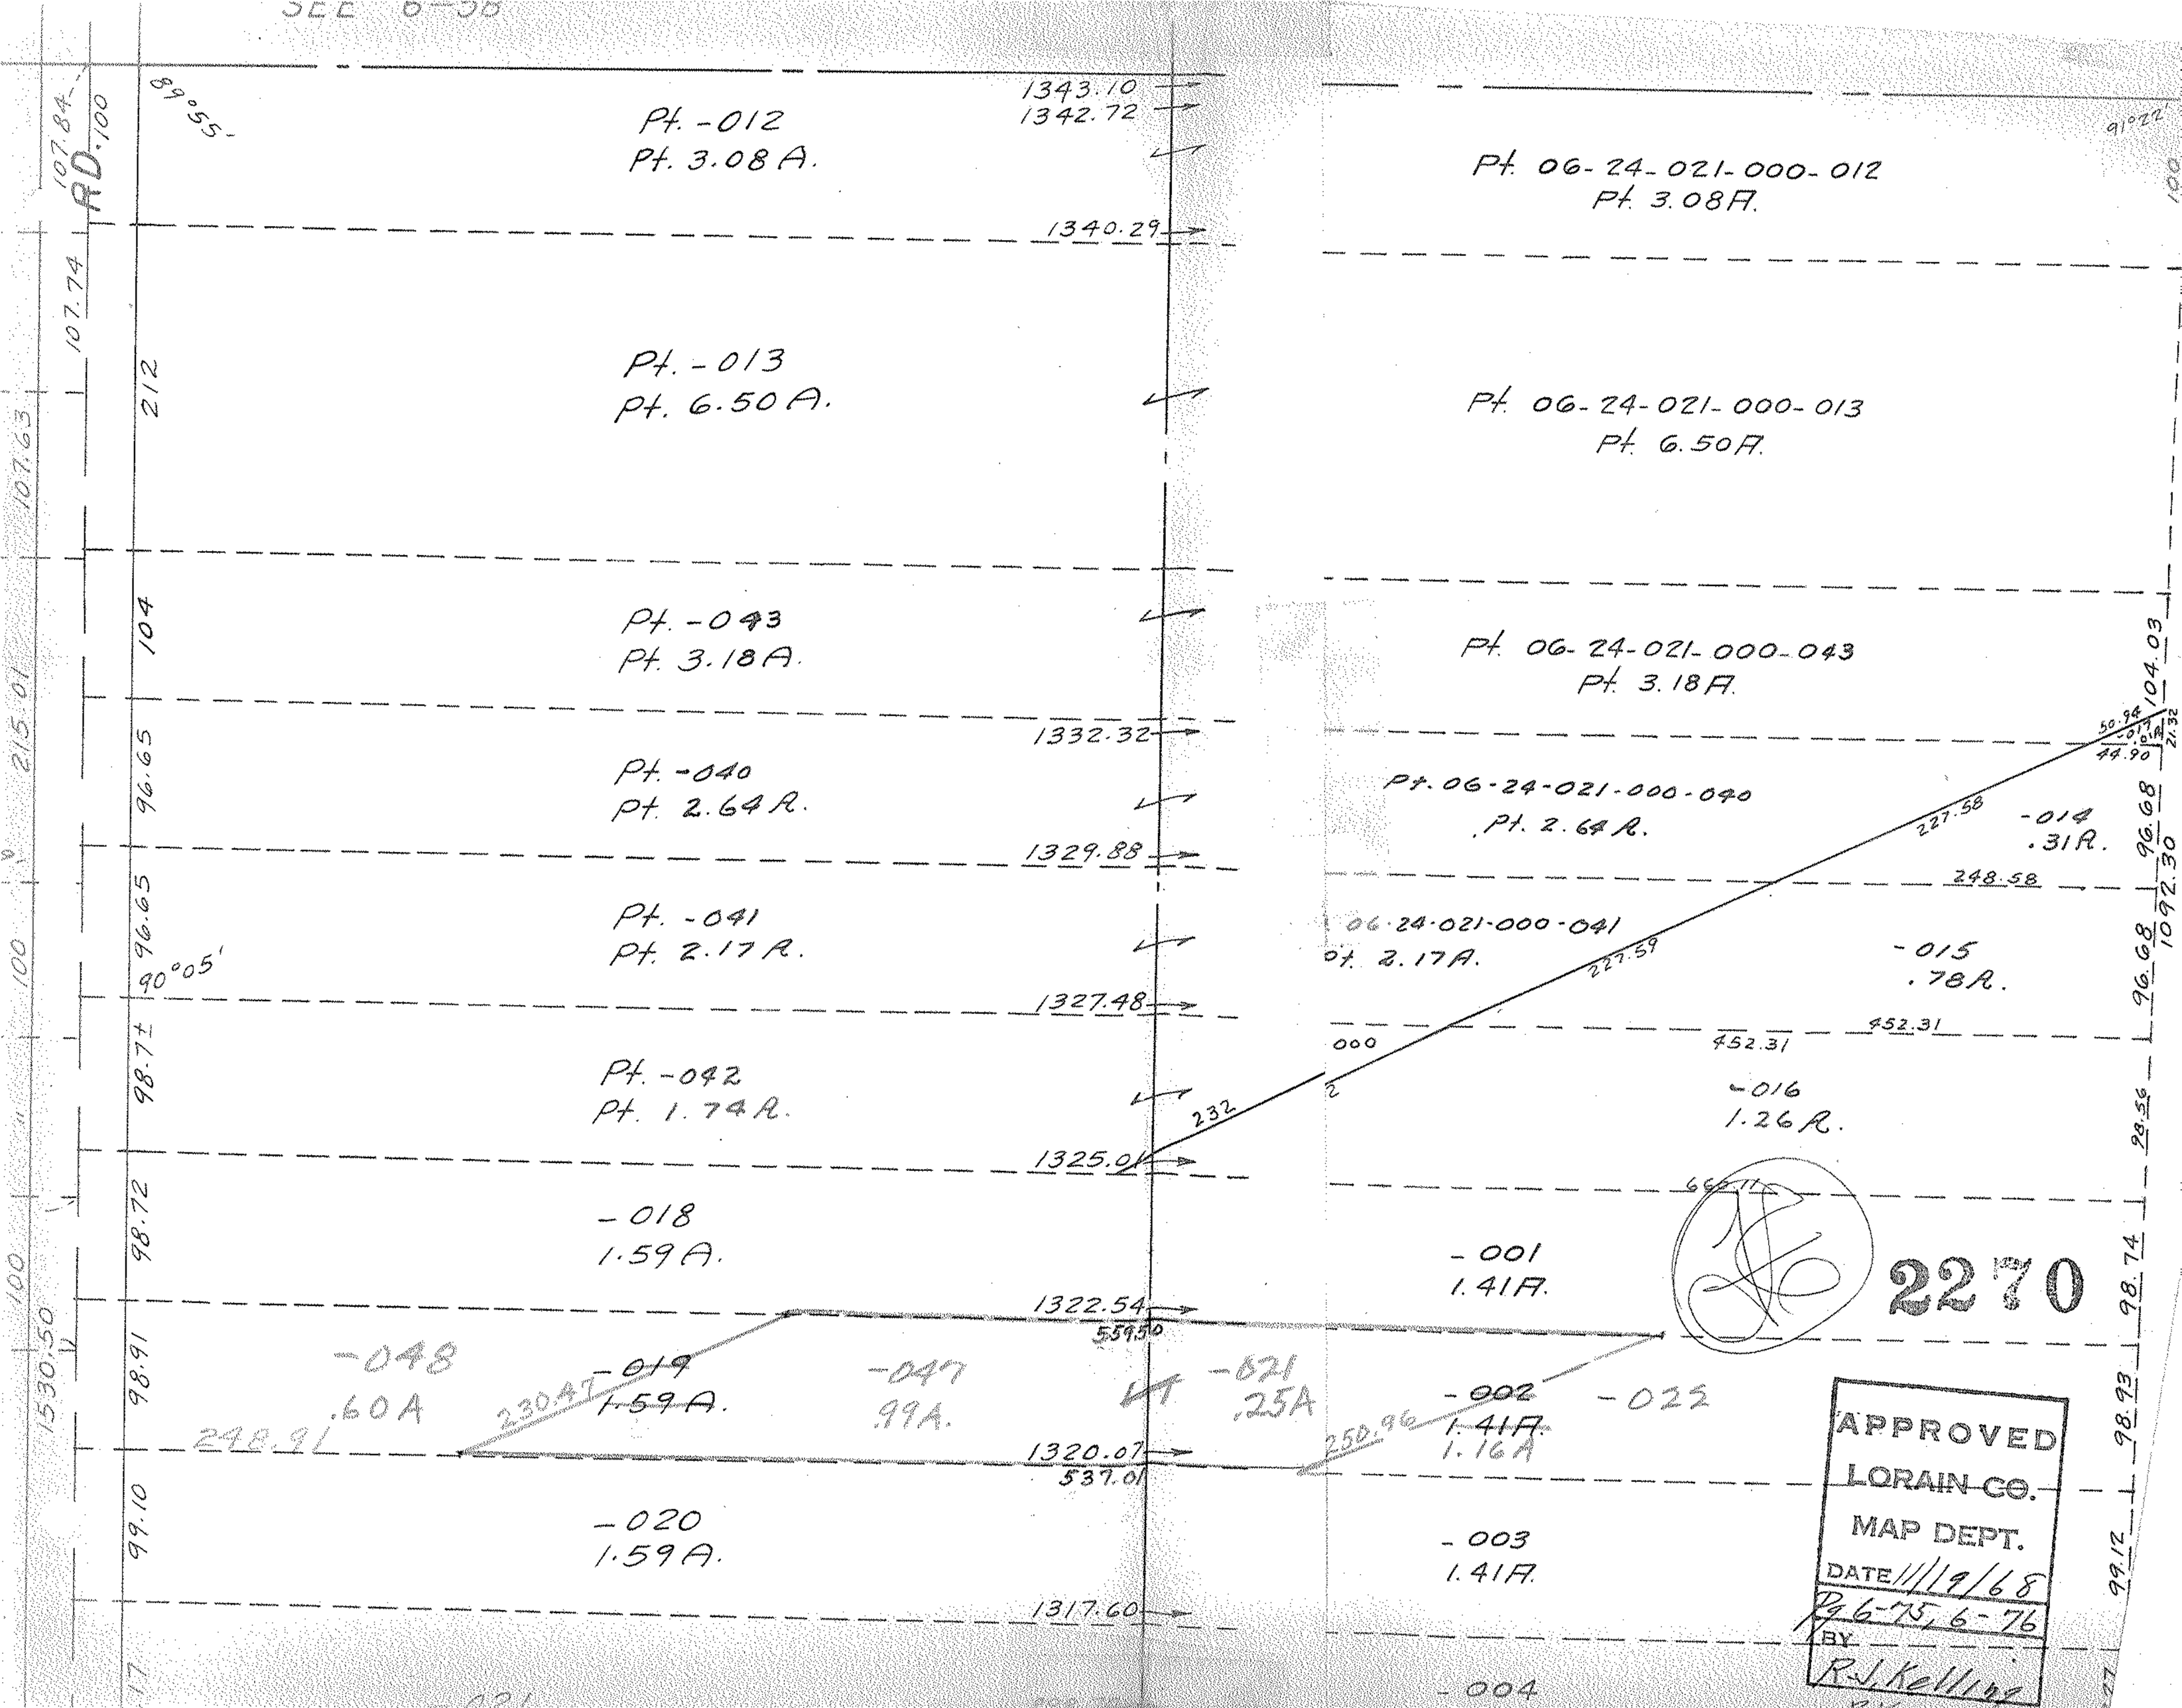

SEE 6-58
RD. 100
107.84
107.74
107.63
215.01
100
1530.50
89°55'
90°05'
212
104
96.65
96.65
98.7±
98.72
98.91
99.10
Pt. -012
Pt. 3.08 A.
Pt. -013
Pt. 6.50 A.
Pt. -043
Pt. 3.18 A.
Pt. -040
Pt. 2.64 A.
Pt. -041
Pt. 2.17 A.
Pt. -042
Pt. 1.74 A.
-018
1.59 A.
-019
1.59 A.
-020
1.59 A.
-048
.60 A
248.91
230.47
-047
.99 A.
-021
.25 A
1343.10
1342.72
1340.29
1332.32
1329.88
1327.48
1325.01
1322.54
559.50
1320.07
537.01
1317.60
Pt. 06-24-021-000-012
Pt. 3.08 A.
Pt. 06-24-021-000-013
Pt. 6.50 A.
Pt. 06-24-021-000-043
Pt. 3.18 A.
Pt. 06-24-021-000-040
Pt. 2.64 A.
06-24-021-000-041
Pt. 2.17 A.
-014
.31 A.
-015
.78 A.
-016
1.26 A.
-001
1.41 A.
-002
1.41 A.
1.16 A
-003
1.41 A.
-004
-022
232
227.58
227.59
248.58
452.31
452.31
250.96
50.94
44.90
104.03
96.68
96.68
98.56
98.74
98.93
99.12
91°22'
2270
APPROVED
LORAIN CO.
MAP DEPT.
DATE 11/19/68
Pg 6-75, 6-76
BY
R.J. Kelling