PARENT PARCEL: 20-05-009-000-015 & -022
CHILD PARCEL: 20-05-009-000-034 THRU -040
STARTING POINT: MON. BOX, CL OF BURSLEY RD. & CL OF QUARRY RD.

NO. 22710

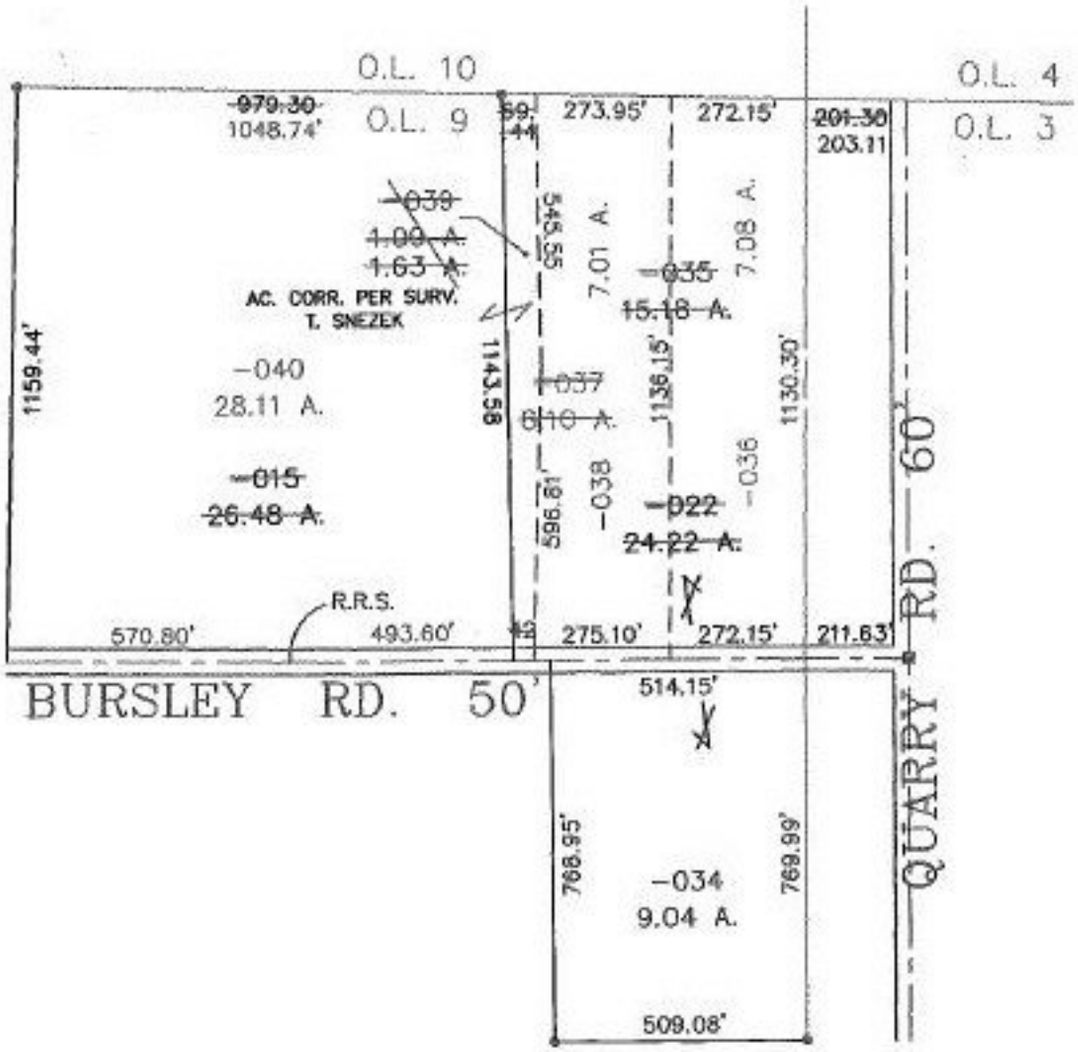

DP 1-6-99

SPLITS/DEEDS PROCESSED
LORAIN COUNTY TAX MAP DEPARTMENT
226 MIDDLE AVE. ELYRIA, OHIO

SURVEYED BY: THOMAS M. SNEZEK
CLOSURE: 0.97 : 10,000
MAP PAGE(S): 20-D
APPROVED BY: T. SPILLMAN DATE: 11/20/98
SCALE: 1" = 400 PRIOR INSTRUMENT: DV 1323/268