PARENT PARCEL: 07-00-004-108-005,-025,-026,-041,-058,-066,-069 THRU -075,-080, & -082

CHILD PARCEL: 07-00-004-108-084

STARTING POINT: MON. BOX, AT THE CL OF CHESTNUT RIDGE RD. & CL OF LEAR NAGLE RD.

NO. 22713

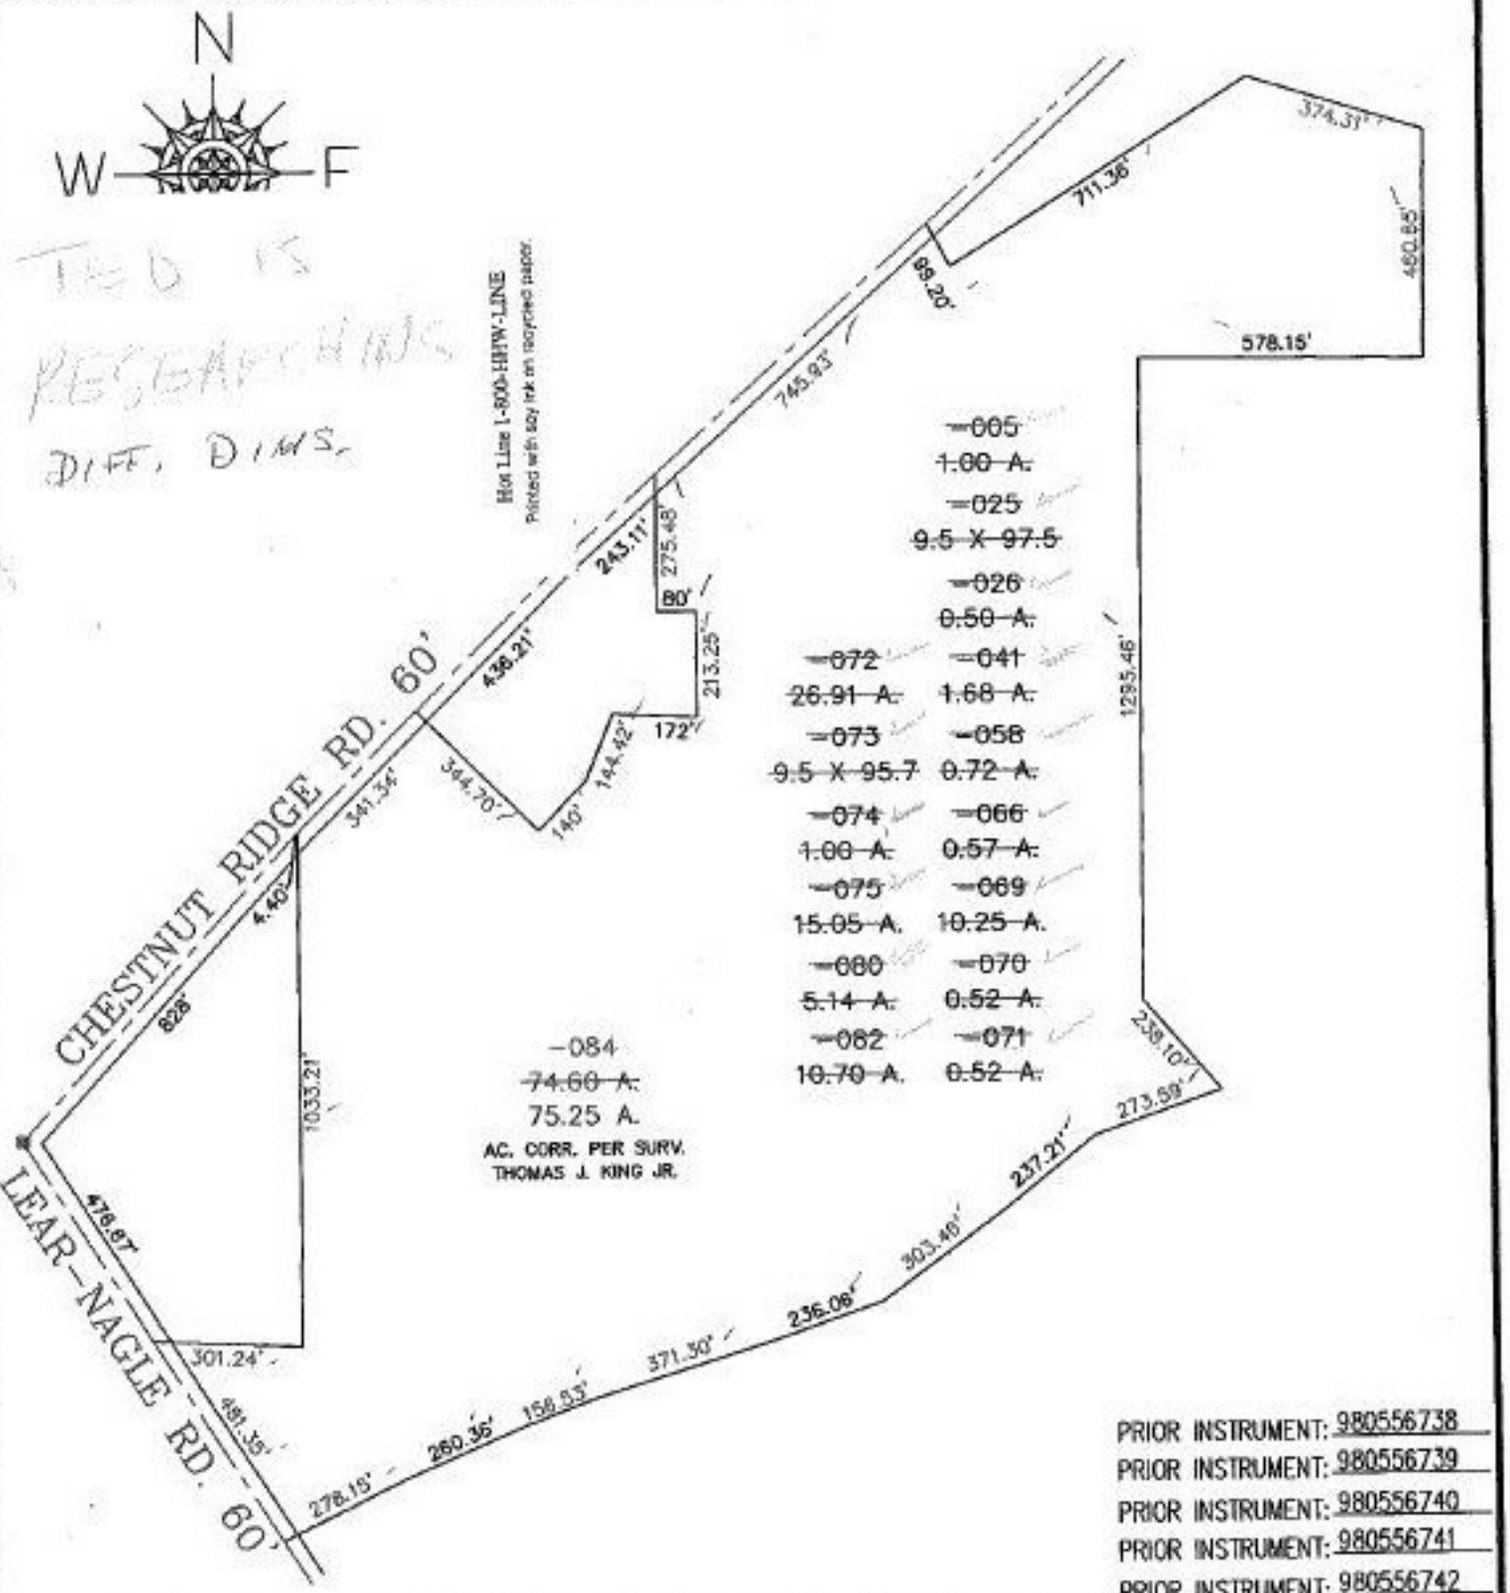

PRIOR INSTRUMENT: 980556738
PRIOR INSTRUMENT: 980556739
PRIOR INSTRUMENT: 980556740
PRIOR INSTRUMENT: 980556741
PRIOR INSTRUMENT: 980556742

SPLITS/DEEDS PROCESSED

LORAIN COUNTY TAX MAP DEPARTMENT
226 MIDDLE AVE. ELYRIA, OHIO

SURVEYED BY: THOMAS J. KING JR.
CLOSURE: 0.01 : 10,000
MAP PAGE(S): 07-00-004-A,B,C, & D
APPROVED BY: T. SPILLMAN DATE: 11/24/98
SCALE: 1" = 400