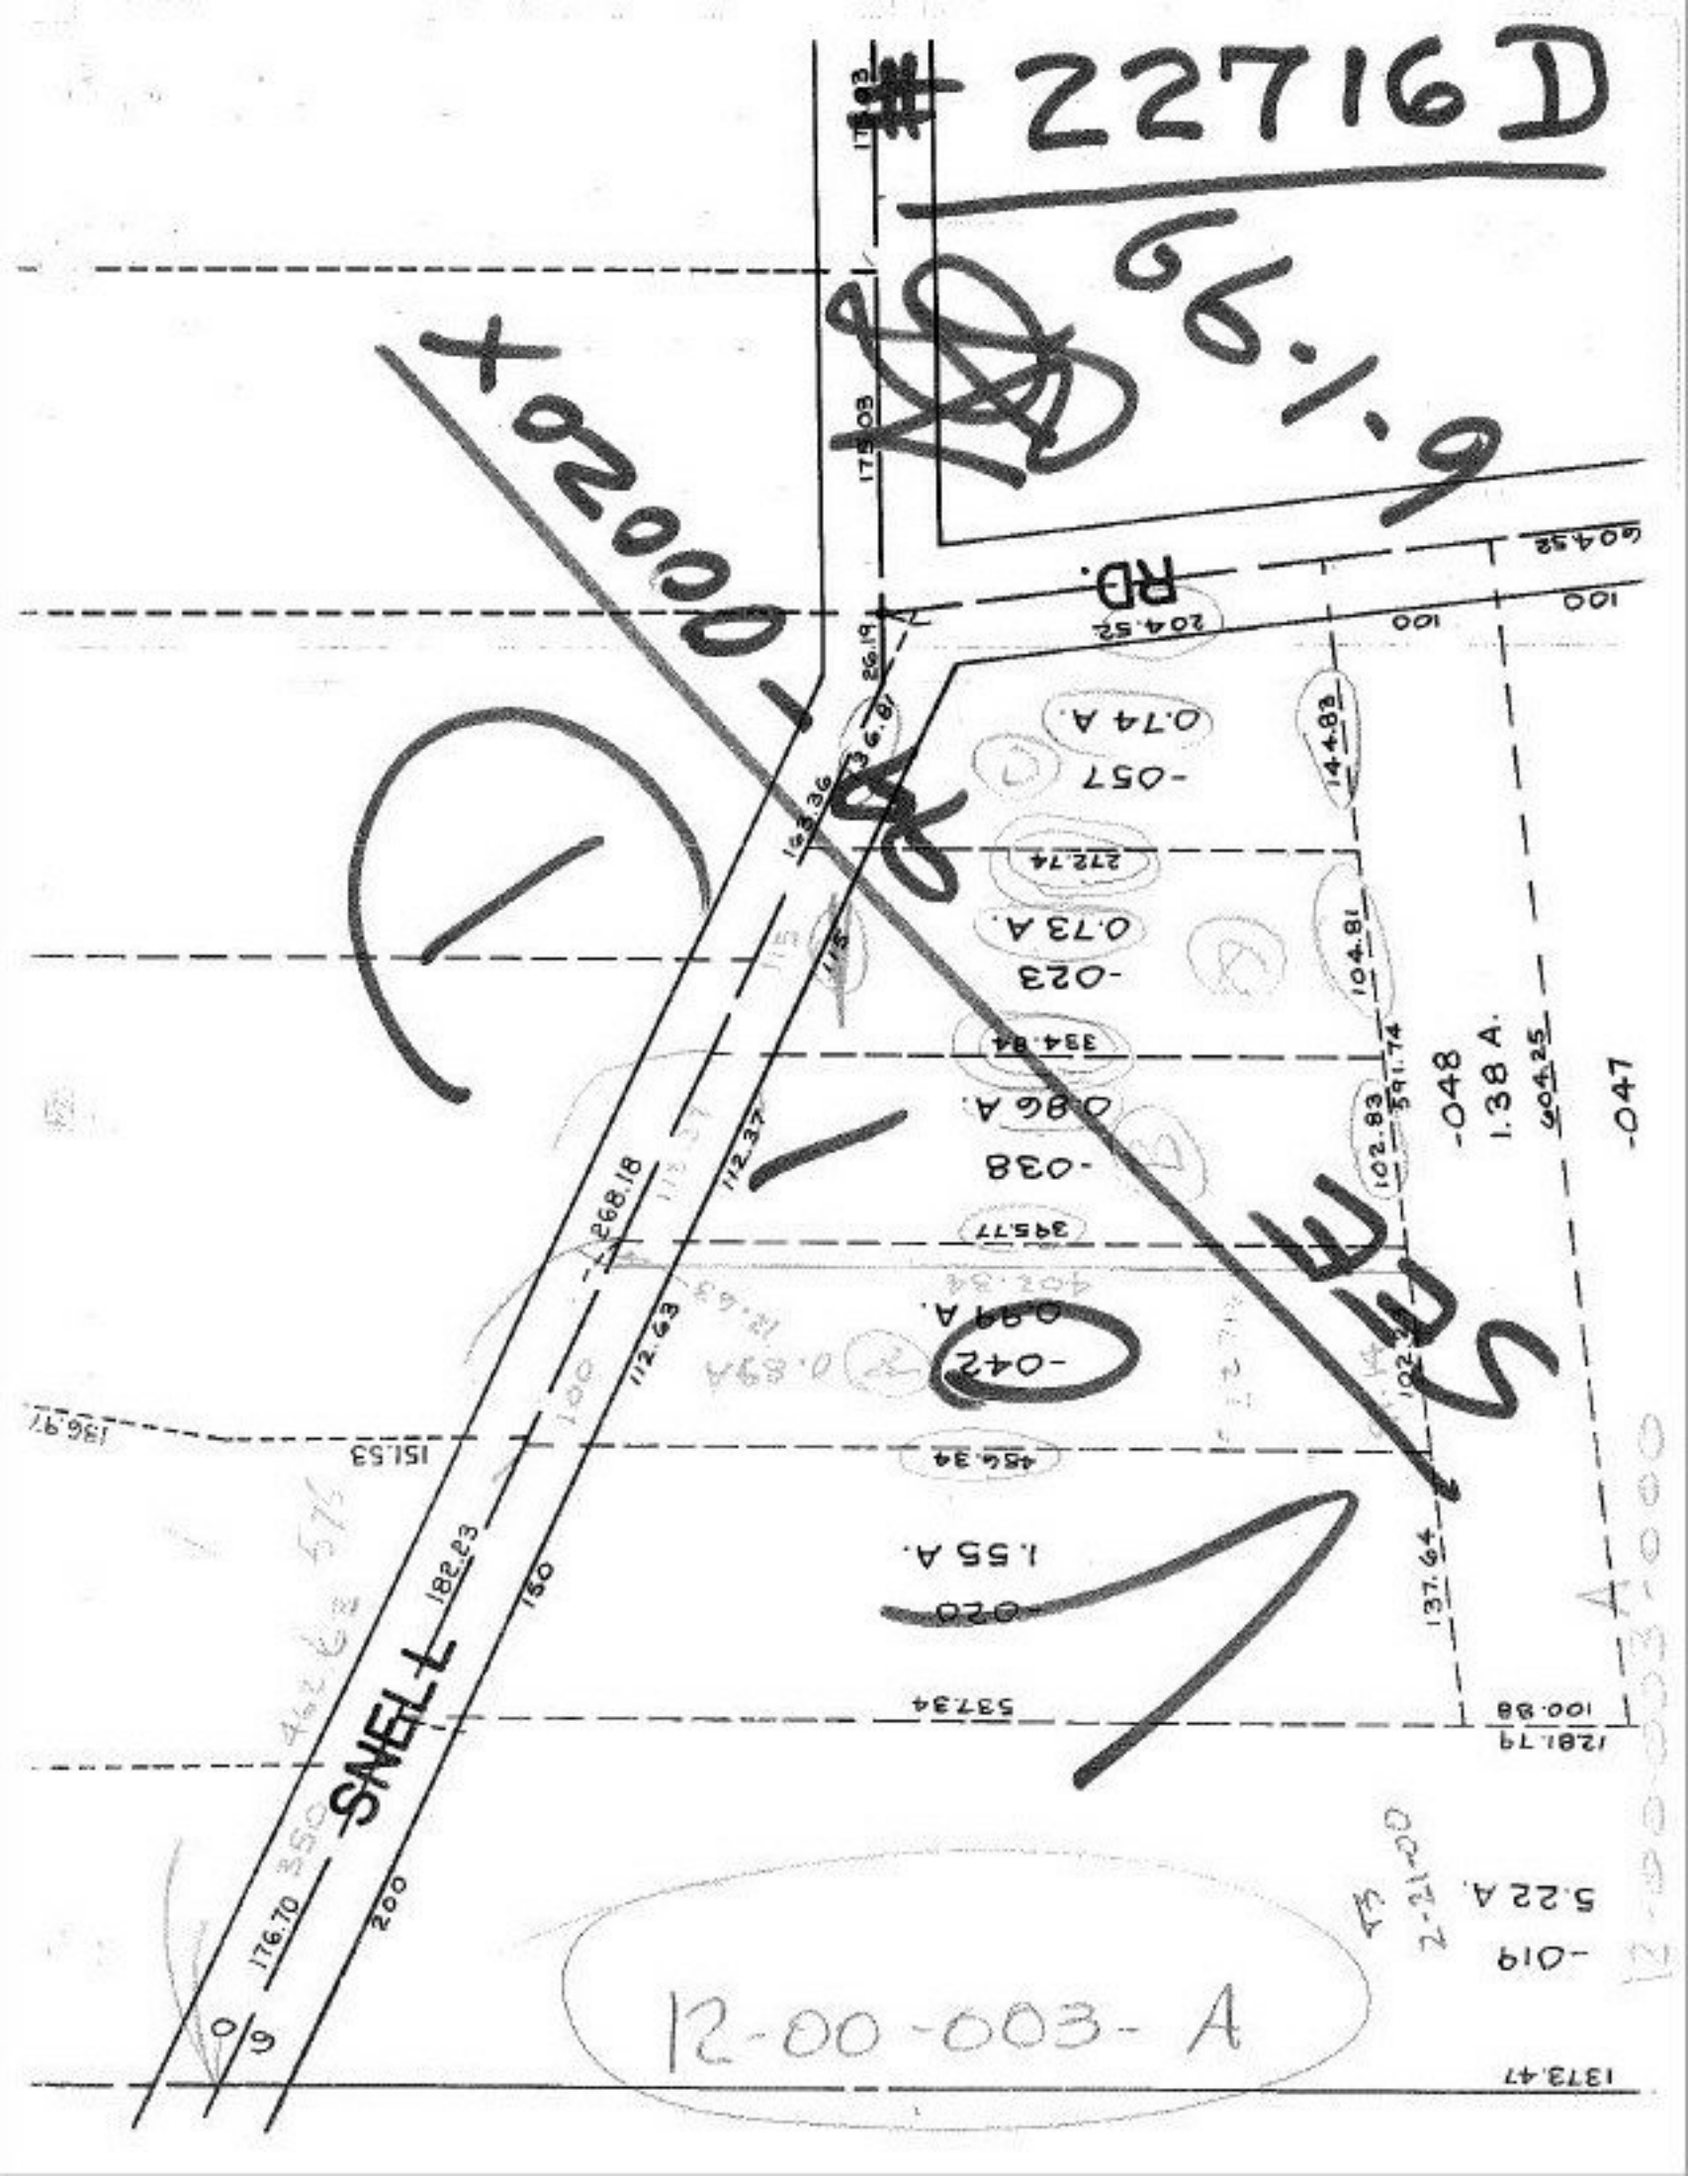
#22716D
12-00-003-A
SNELL
RD.
-057
0.74 A.
-023
0.73 A.
-038
0.86 A.
-042
0.89 A.
-020
1.55 A.
-019
5.22 A.
-048
1.38 A.
-047
204.52
100
60.38
175.03
133.36
136.81
26.19
144.83
272.74
104.81
334.84
102.83
591.74
404.25
395.77
402.84
112.37
112.63
268.18
182.83
176.70
150
200
151.53
456.34
137.64
537.34
100.88
128.79
1373.47
Sketch
Ex 2-21-00