PARENT PARCEL: 05-00-037-103-006

CHILD PARCEL: 05-00-037-103-029 & -030

STARTING POINT: I.P., AT THE INTERSECTION OF THE SOUTH LINE OF TENNEY ST. & THE EAST LINE OF JAMES ST.

NO. 22719

N

W E

S

NEW PARCEL SIZES

05-00-037-103-029
4.50 X 131.99

05-00-037-103-030
82.08 X 131.99

7-22-99

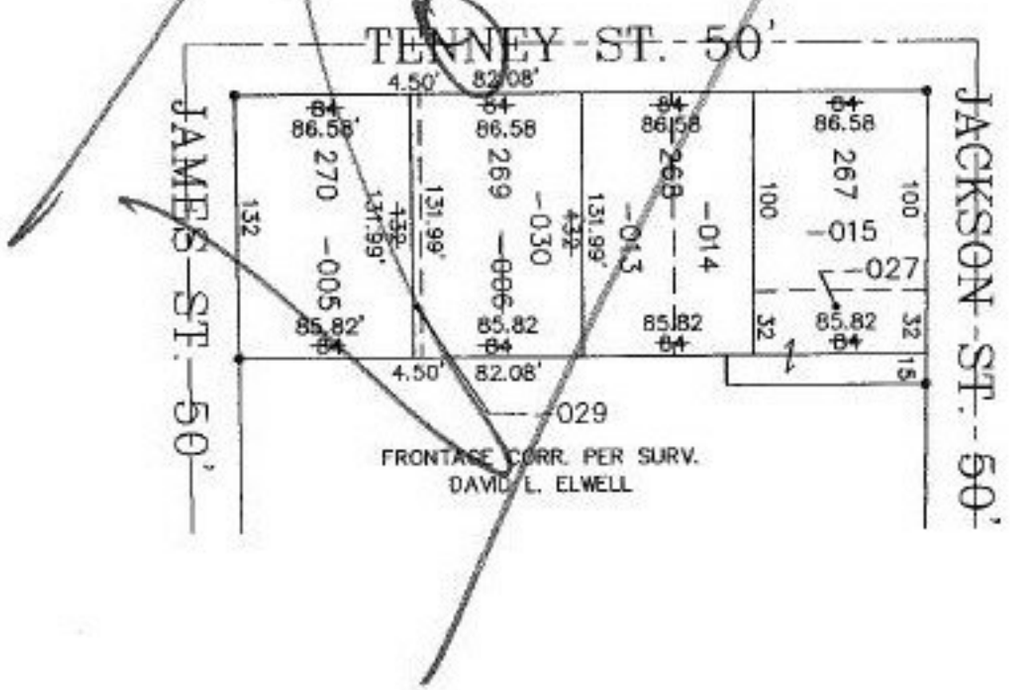

SPLITS/DEEDS PROCESSED

LORAIN COUNTY TAX MAP DEPARTMENT
226 MIDDLE AVE. ELYRIA, OHIO

SURVEYED BY: KS ASSOC.
CLOSURE: 0.00 : 10,000
MAP PAGE(S): 05-00-037-A
APPROVED BY: TJS DATE: 12/07/98
SCALE: 1" = 100 PRIOR INSTRUMENT: DV 1267/811