PARENT PARCEL: 10-00-003-121-010 & -011

CHILD PARCEL: 10-00-003-121-039

STARTING POINT: MON. BOX, CL OF RUSSIA RD. & CL OF W.RIVER RD.

NO. 22724

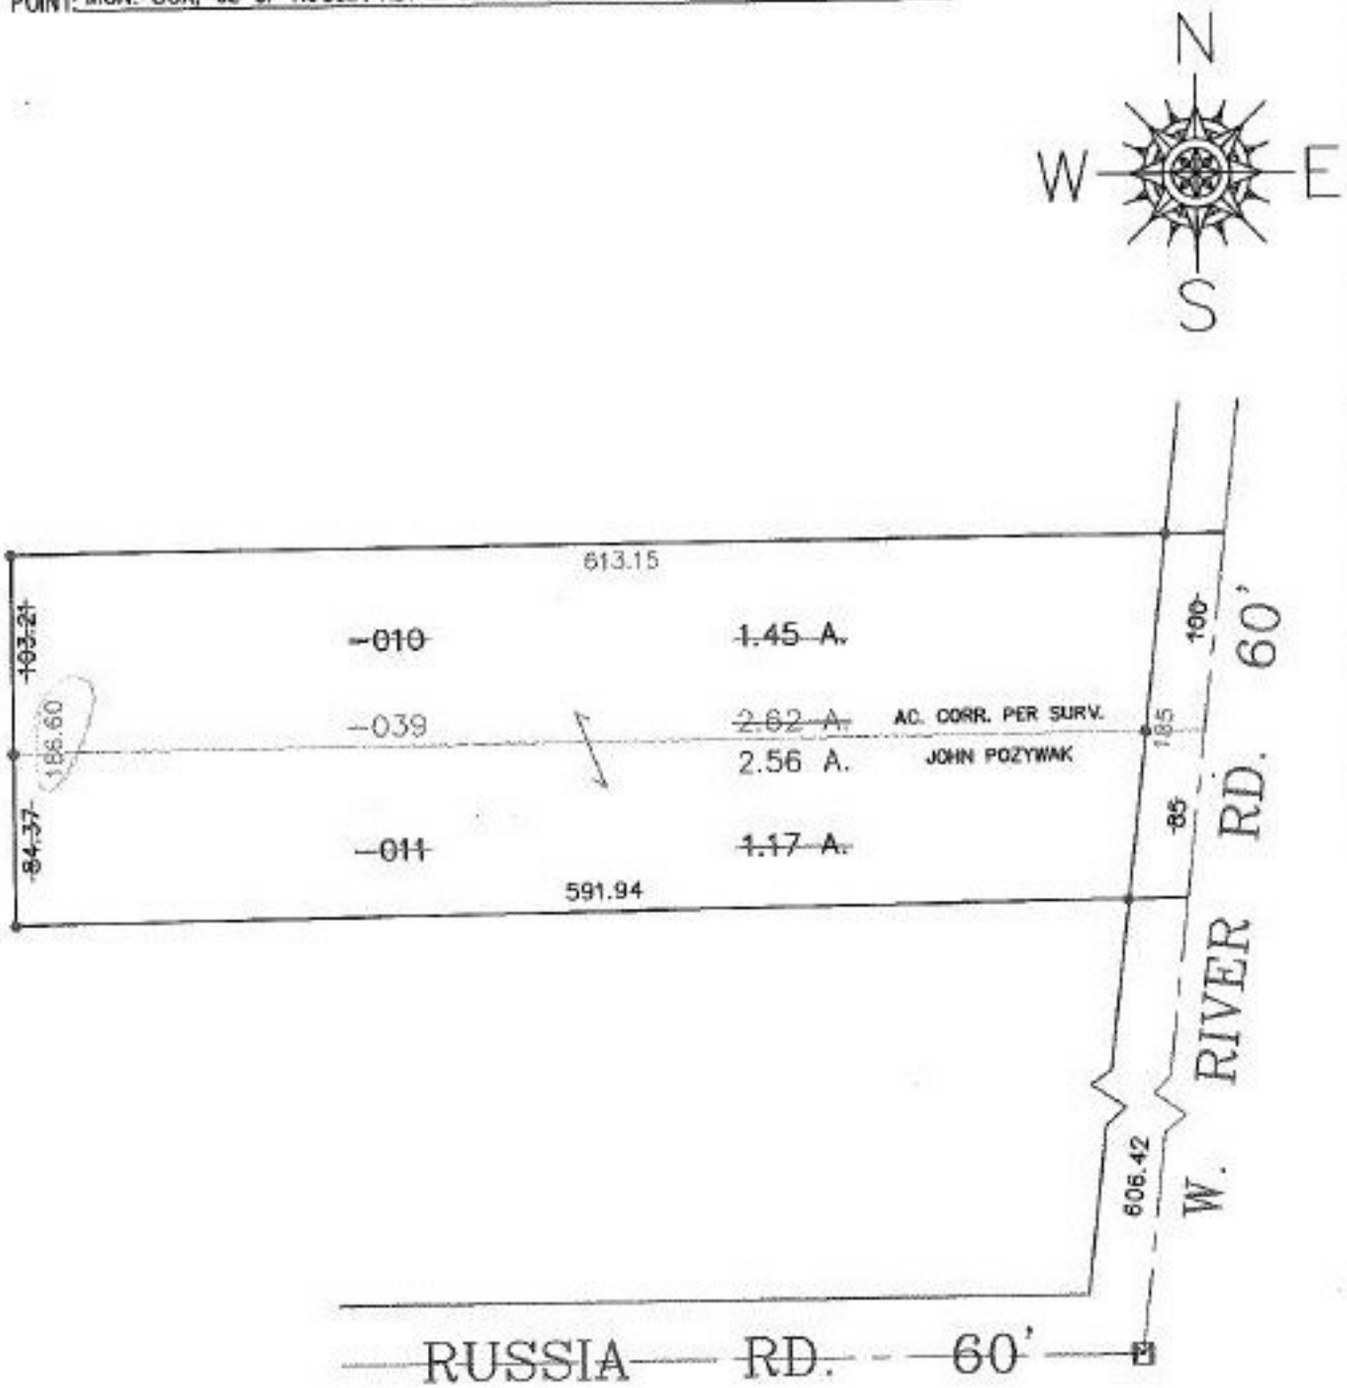


6/21/99

SPLITS/DEEDS PROCESSED

LORAIN COUNTY TAX MAP DEPARTMENT
226 MIDDLE AVE. ELYRIA, OHIO

SURVEYED BY: JOHN POZYWAK

CLOSURE: 0.21 : 10,000

MAP PAGE(S): 10-00-003-E

APPROVED BY: TJS DATE: 12/22/98

SCALE: 1"= 100 PRIOR INSTRUMENT: DV 1072/243