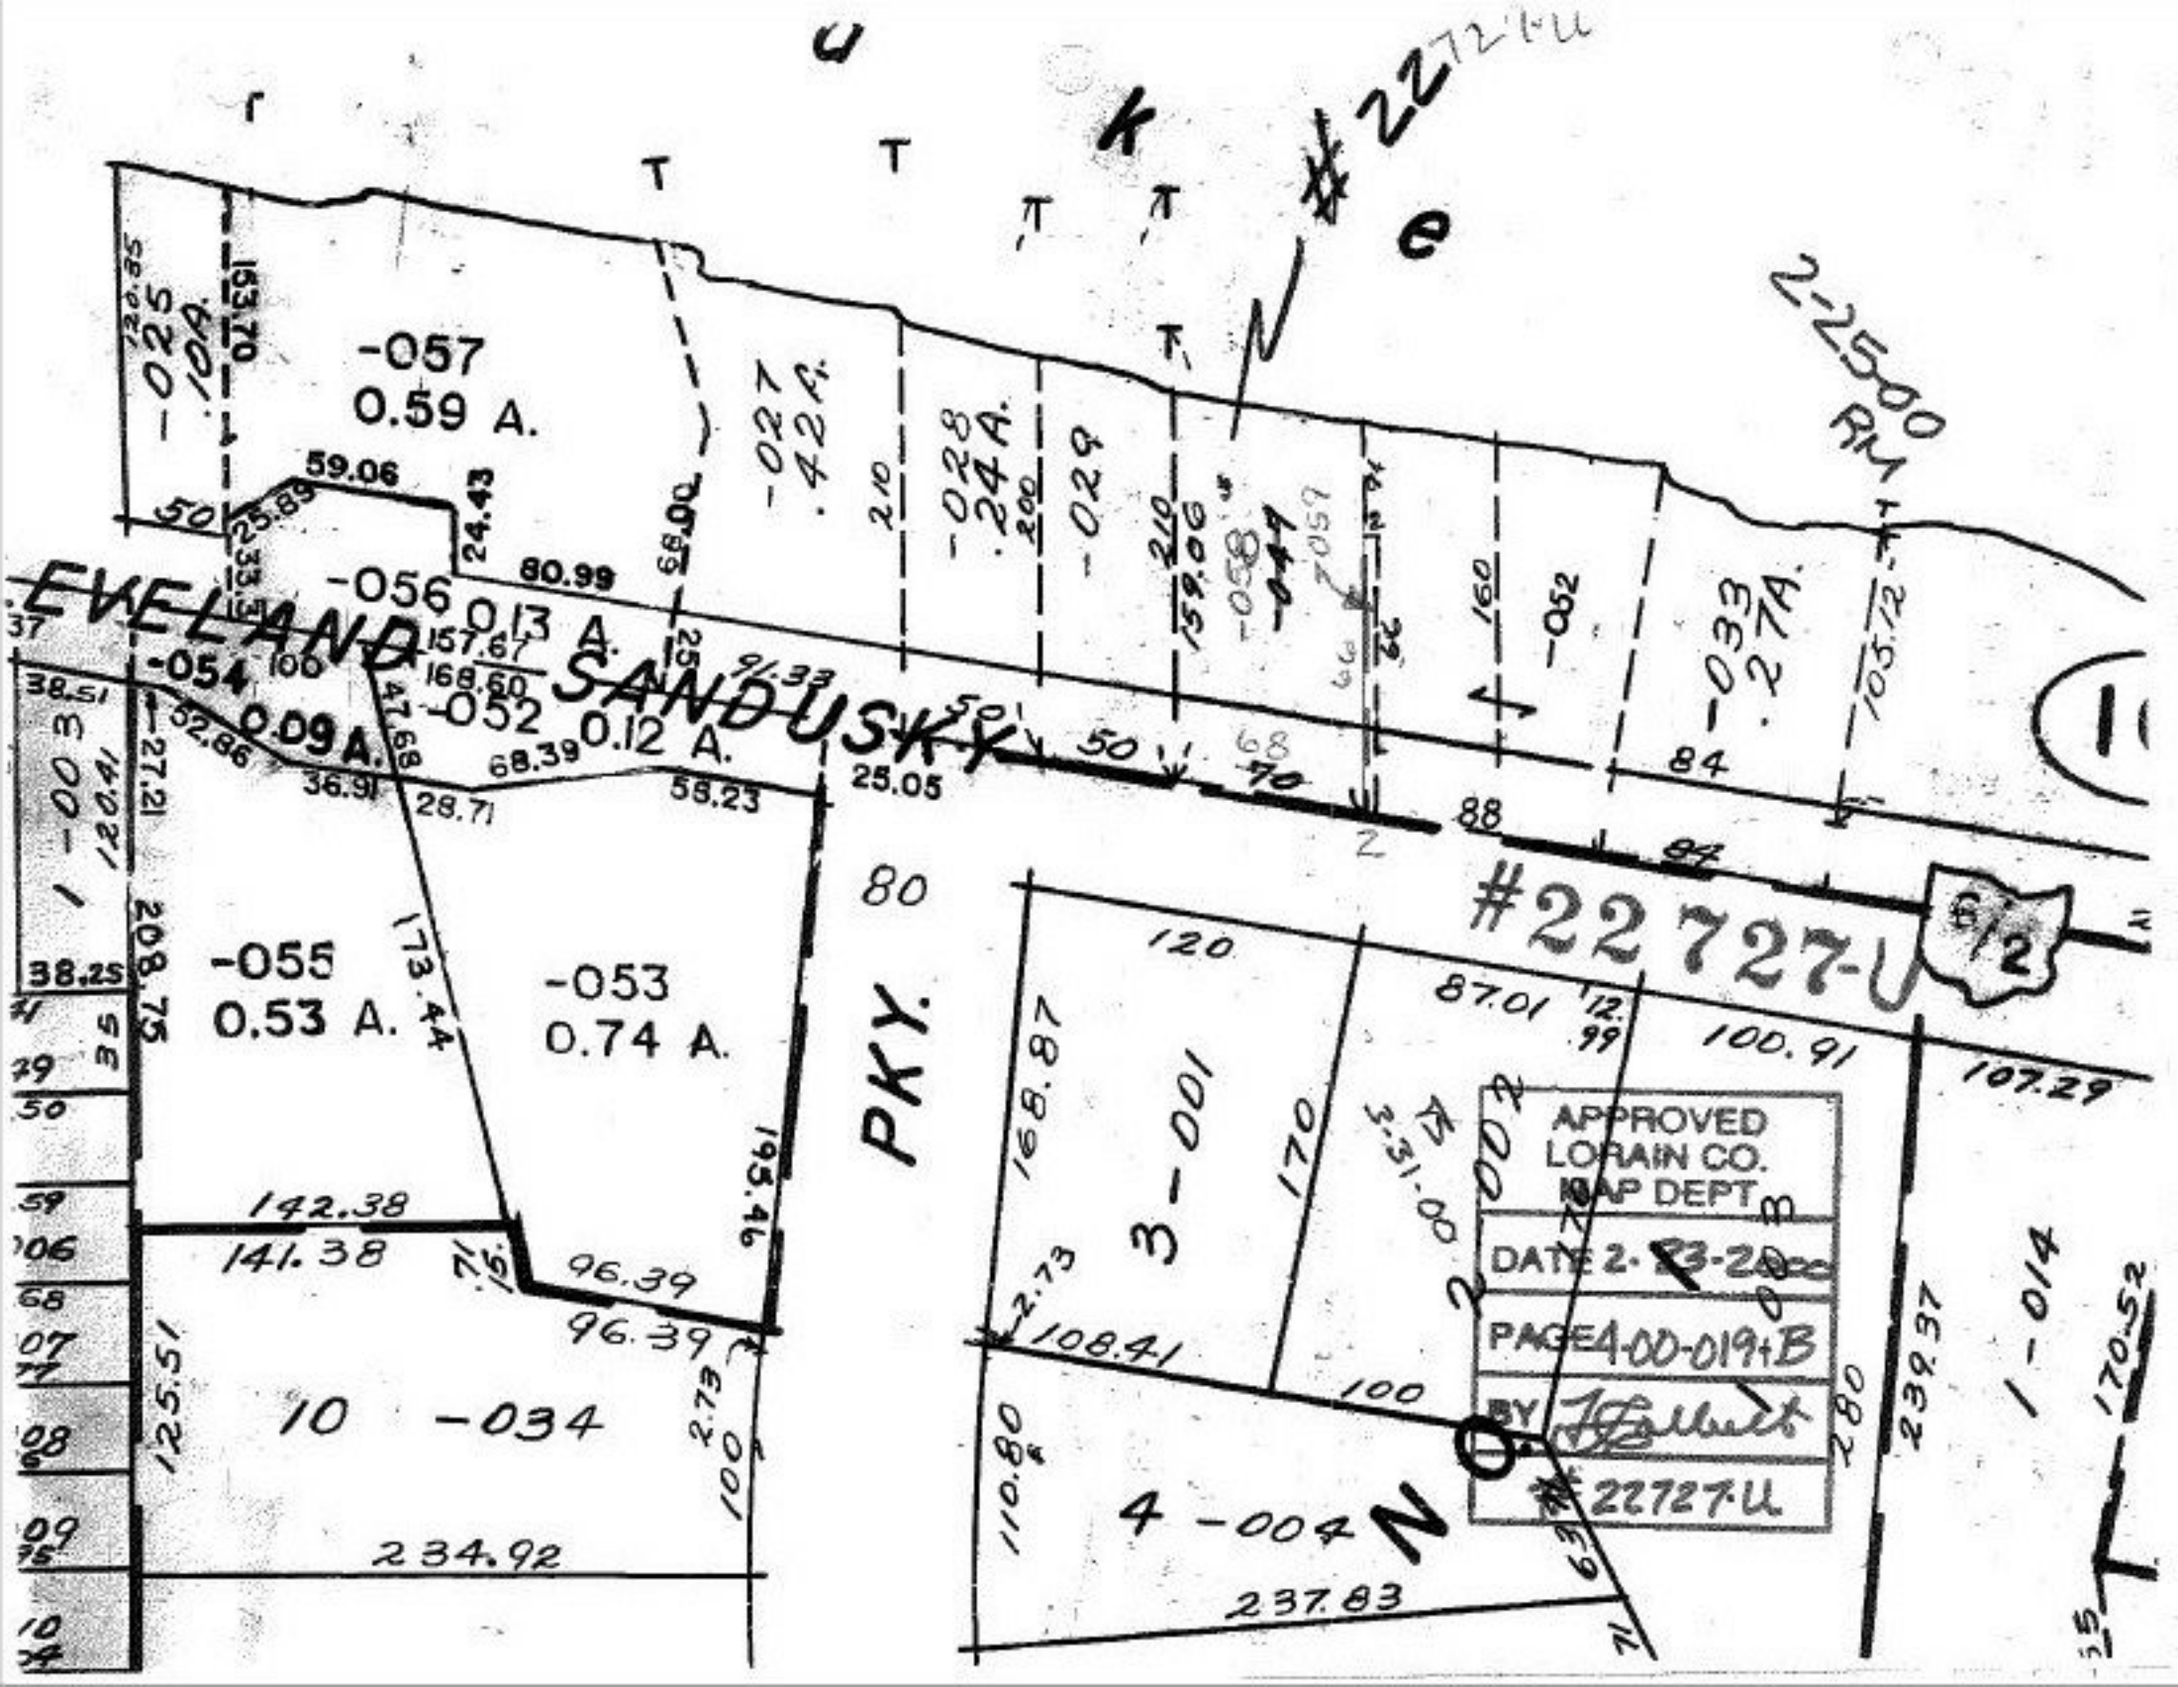
-057
0.59 A.
-056 0.13 A.
-054
0.09 A.
-052 0.12 A.
-055
0.53 A.
-053
0.74 A.
-025
-027 .42A.
-028 .24A.
-029
-033 .27A.
EVELAND SANDUSKY
PKY.
#22727-U
3-001
4-004
10 -034
1-003
1-014
APPROVED
LORAIN CO.
MAP DEPT
DATE 2-23-2000
PAGE 4-00-019+B
BY
#22727-U
NO
59.06
24.43
80.99
68.90
157.67
168.60
68.39
55.23
25.05
173.44
208.75
142.38
141.38
96.39
234.92
168.87
170
108.41
100
237.83
87.01
100.91
107.29
239.97
280
2.73
3.31.00