PARENT PARCEL: 11-00-069-000-006 , 11-00-070-000-115

CHILD PARCEL: 11-00-069-000-007 & -008, 11-00-070-000-117 & -118

STARTING POINT: CL OF BUTTERNUT RIDGE RD. & IT'S INTERSECTION WITH WEST LINE OF O.L. 69

NO. 22727

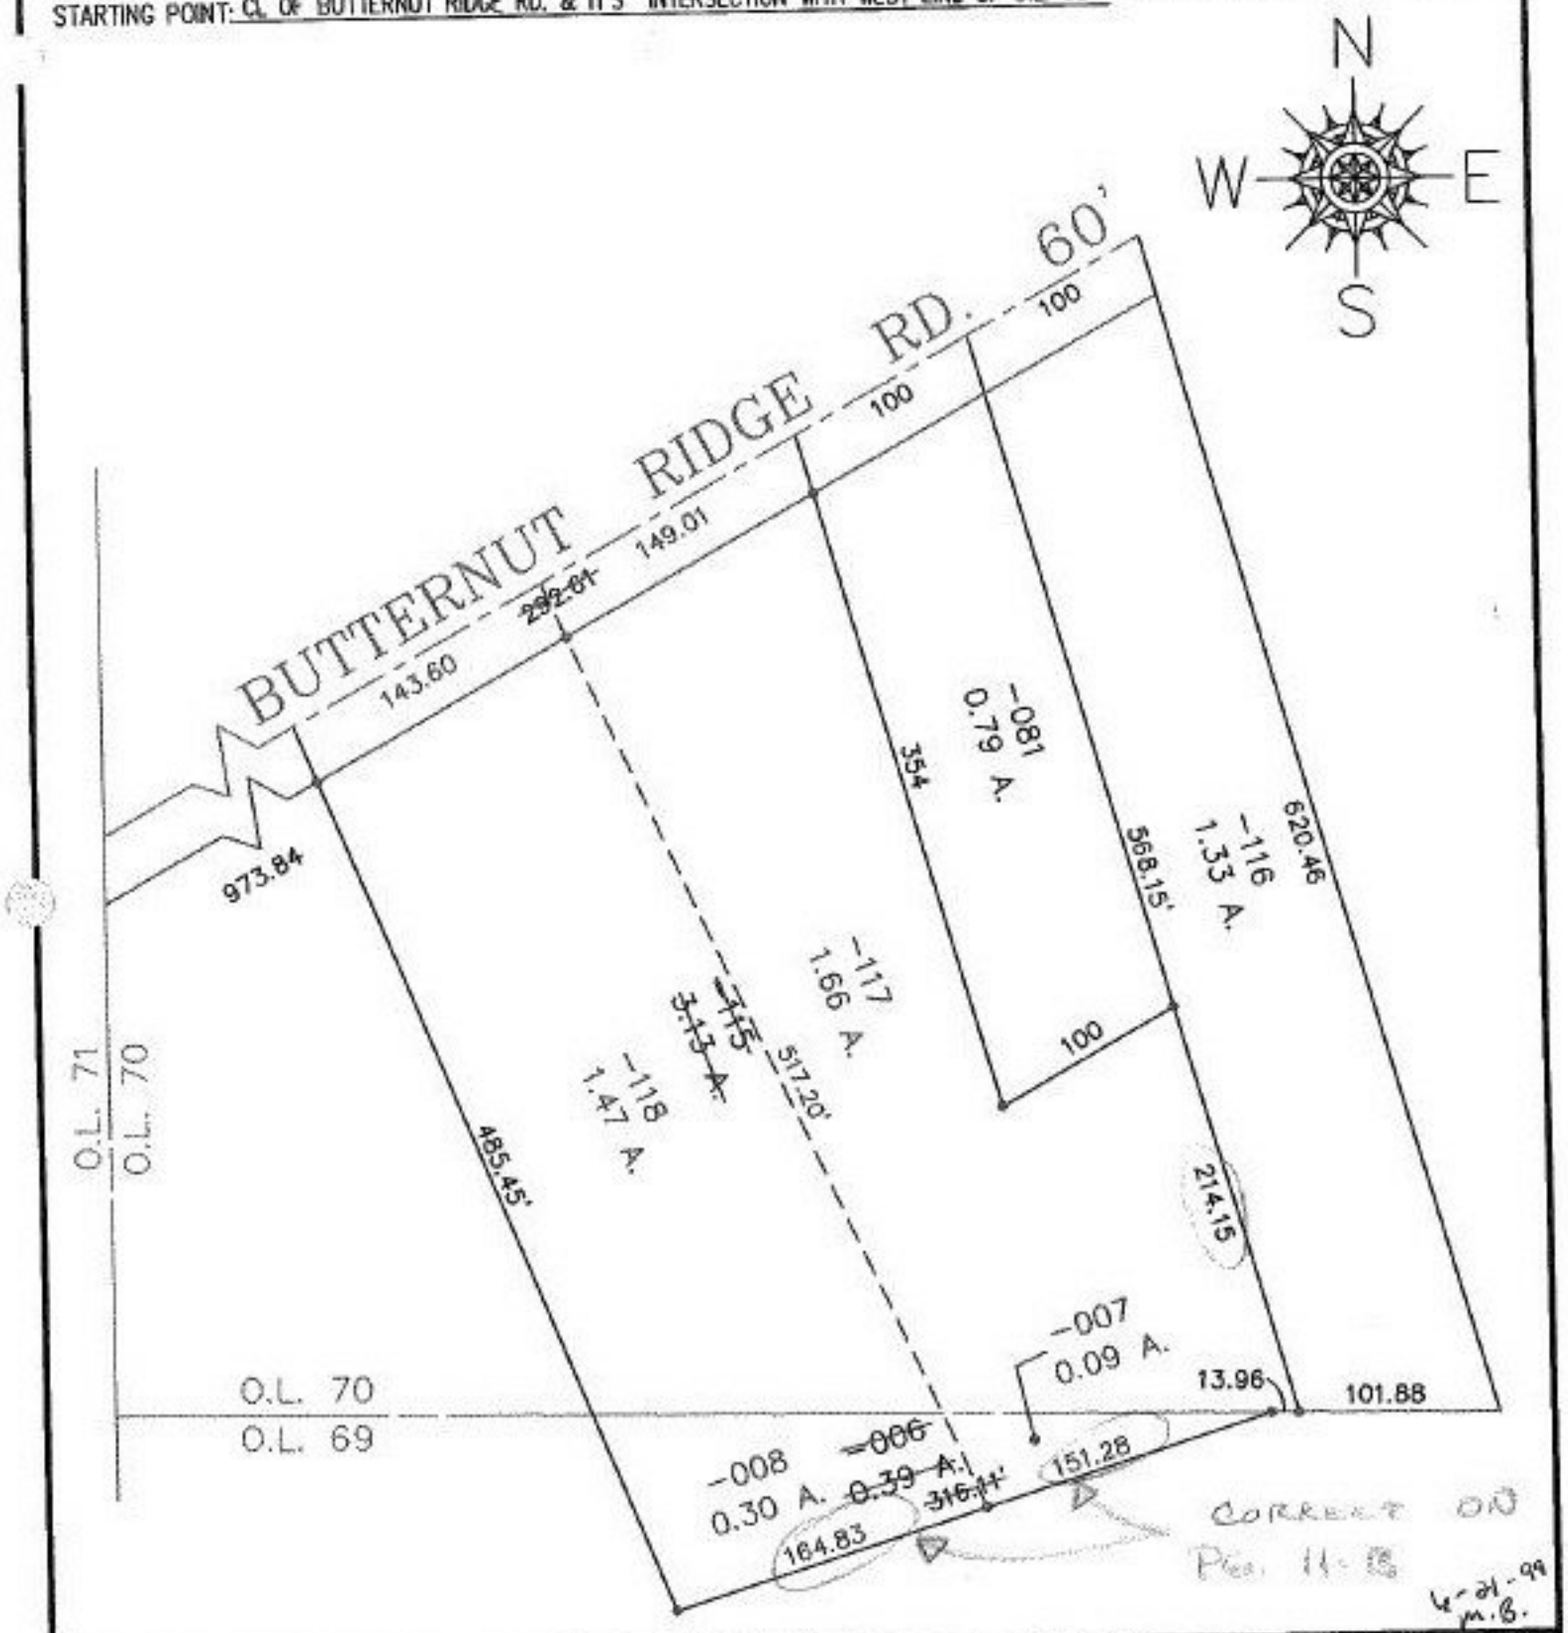

SPLITS/DEEDS PROCESSED

LORAIN COUNTY TAX MAP DEPARTMENT
226 MIDDLE AVE. ELYRIA, OHIO

SURVEYED BY: DAVID L. ELWELL

CLOSURE: 0.04 : 10,000

MAP PAGE(S): 11-00-070-A & 11-B

APPROVED BY: TJS DATE: 12/16/98

SCALE: 1" = 100 PRIOR INSTRUMENT: OR 117/490