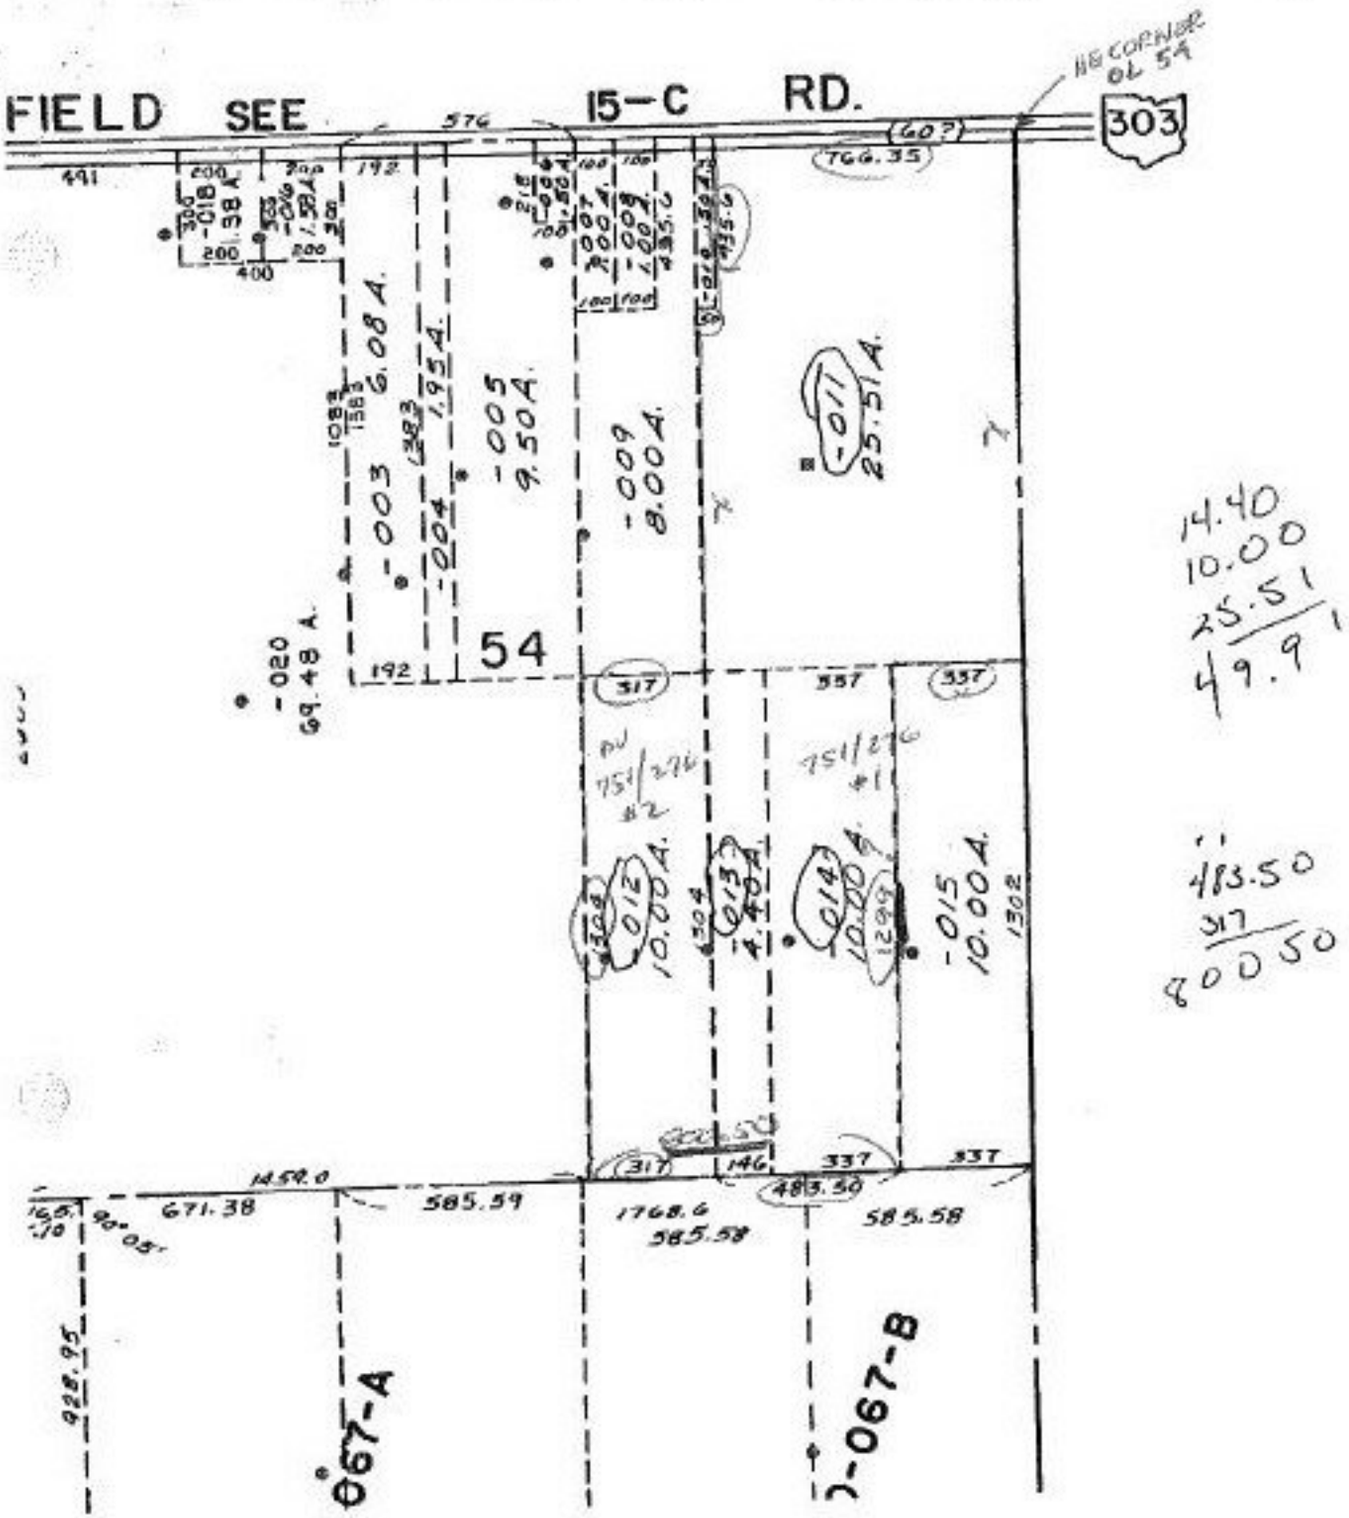

LORAIN COUNTY GIS
MARK R. STEWART
COUNTY AUDITOR

LORAIN COUNTY AUDITOR'S OFFICE
MARK R. STEWART
LORAIN COUNTY AUDITOR

LORAIN COUNTY ENGINEER'S OFFICE
KENNETH P. CARNEY SR.
LORAIN COUNTY ENGINEER

www.loraincounty.com/auditor

auditor.stewart@juno.com

NOTE: TAX MAP NOT DRAWN TO SCALE