PARENT PARCEL: 02-01-007-102-058 & -059

CHILD PARCEL: 02-01-007-102-060 THRU -062

STARTING POINT: CL OF WASHINGTON AVE. & CL OF NORTH RIDGE RD.

NO. 22738

N

W E

S

△ R.R.S.

● I.P.

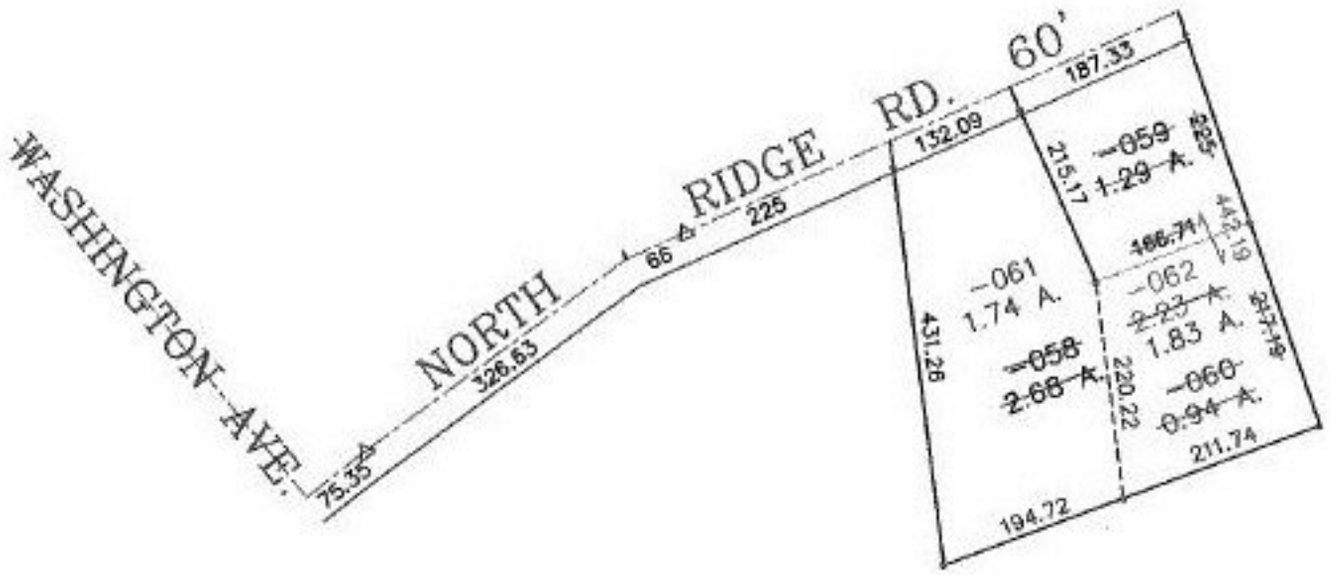

PRIOR INSTRUMENT: OR 1316/516

PRIOR INSTRUMENT: OR 1410/716

SPLITS/DEEDS PROCESSED

LORAIN COUNTY TAX MAP DEPARTMENT
226 MIDDLE AVE. ELYRIA, OHIO

SURVEYED BY: RODGER G. SIMON

CLOSURE: 0.15 : 10,000

MAP PAGE(S): 02-01-007-B

APPROVED BY: TJS DATE: 12/29/98

SCALE: 1" = 200