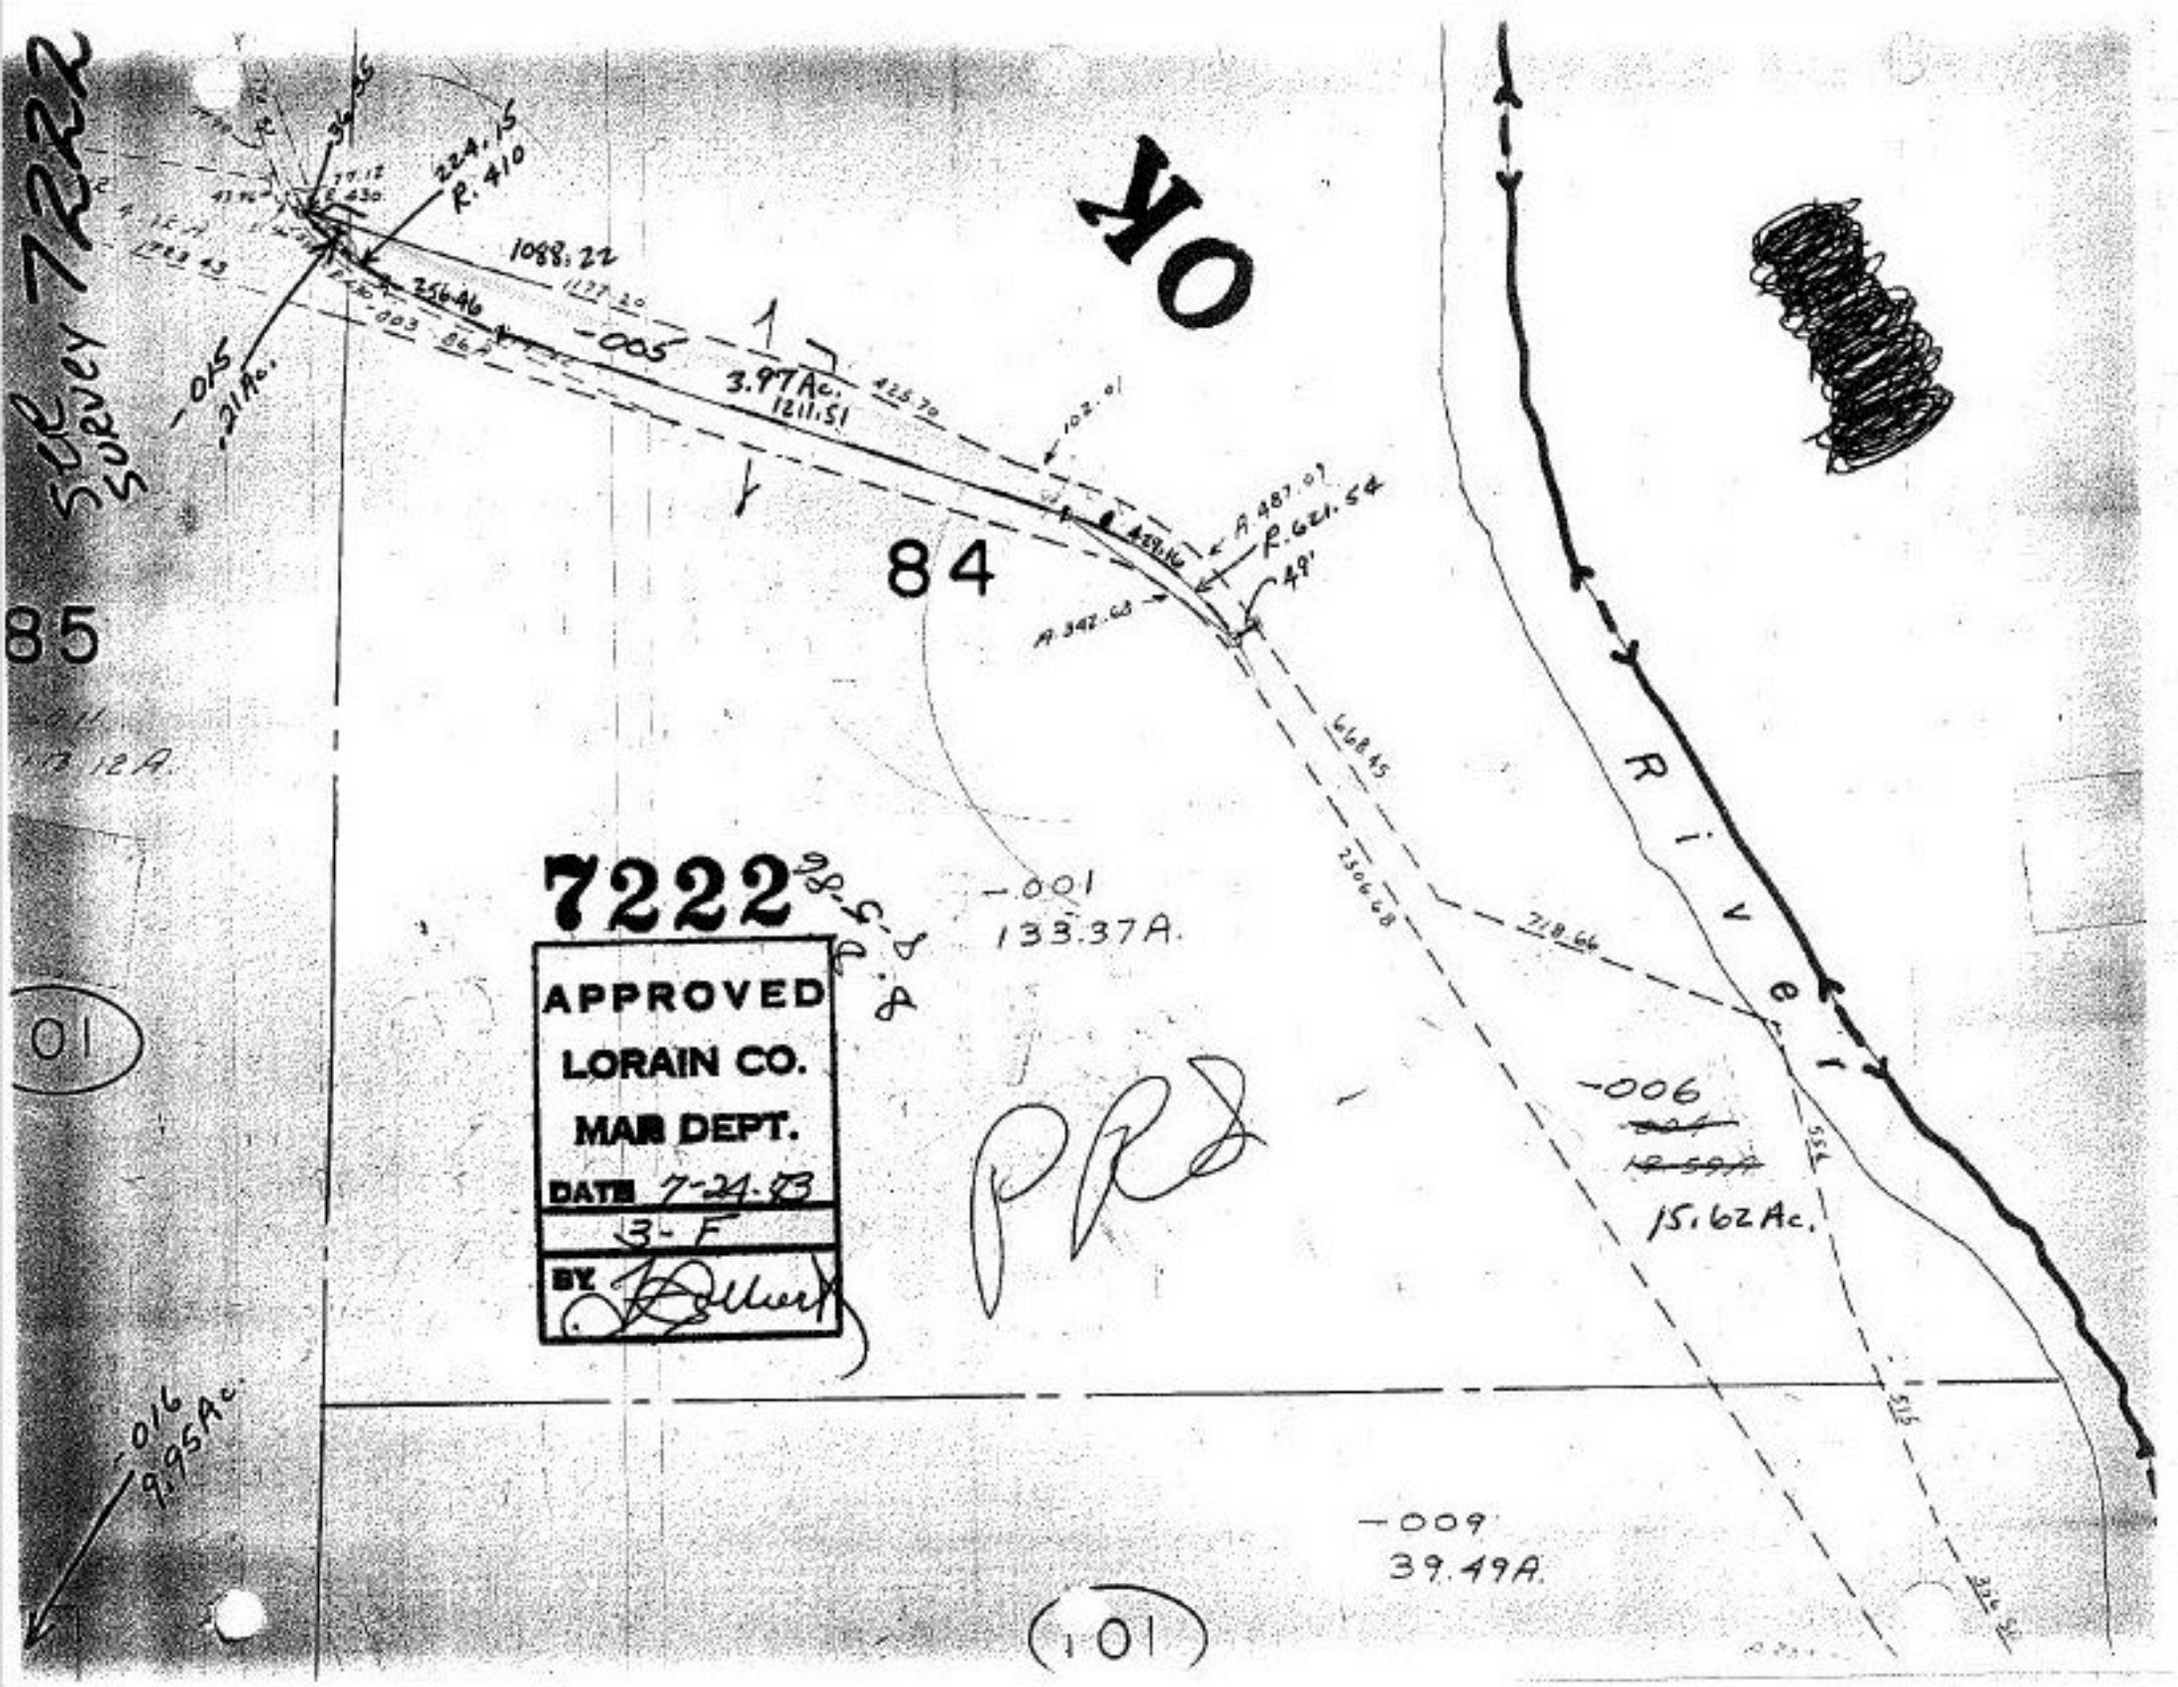
SURVEY 7222
85
84
YO
R i v e r
1088.22
1127.20
224.15
R. 410
256.46
-005
3.97 Ac.
1211.51
.21 Ac.
425.70
102.01
A. 487.09
R. 621.54
49'
A. 342.63
668.45
250.68
219.64
-001
133.37A.
7222
APPROVED
LORAIN CO.
MAP DEPT.
DATE 7-24-83
3-F
BY
-006
15.62 Ac.
-009
39.49A.
-016
9.95Ac.
(101)
(101)