PARENT PARCEL: 09-00-066-000-036 & -037

CHILD PARCEL: 09-00-066-000-038

STARTING POINT: CL OF BUTTERNUT RIDGE RD. & CL OF OBERLIN NORTH RD. (S.R. 58)

NO. 22746

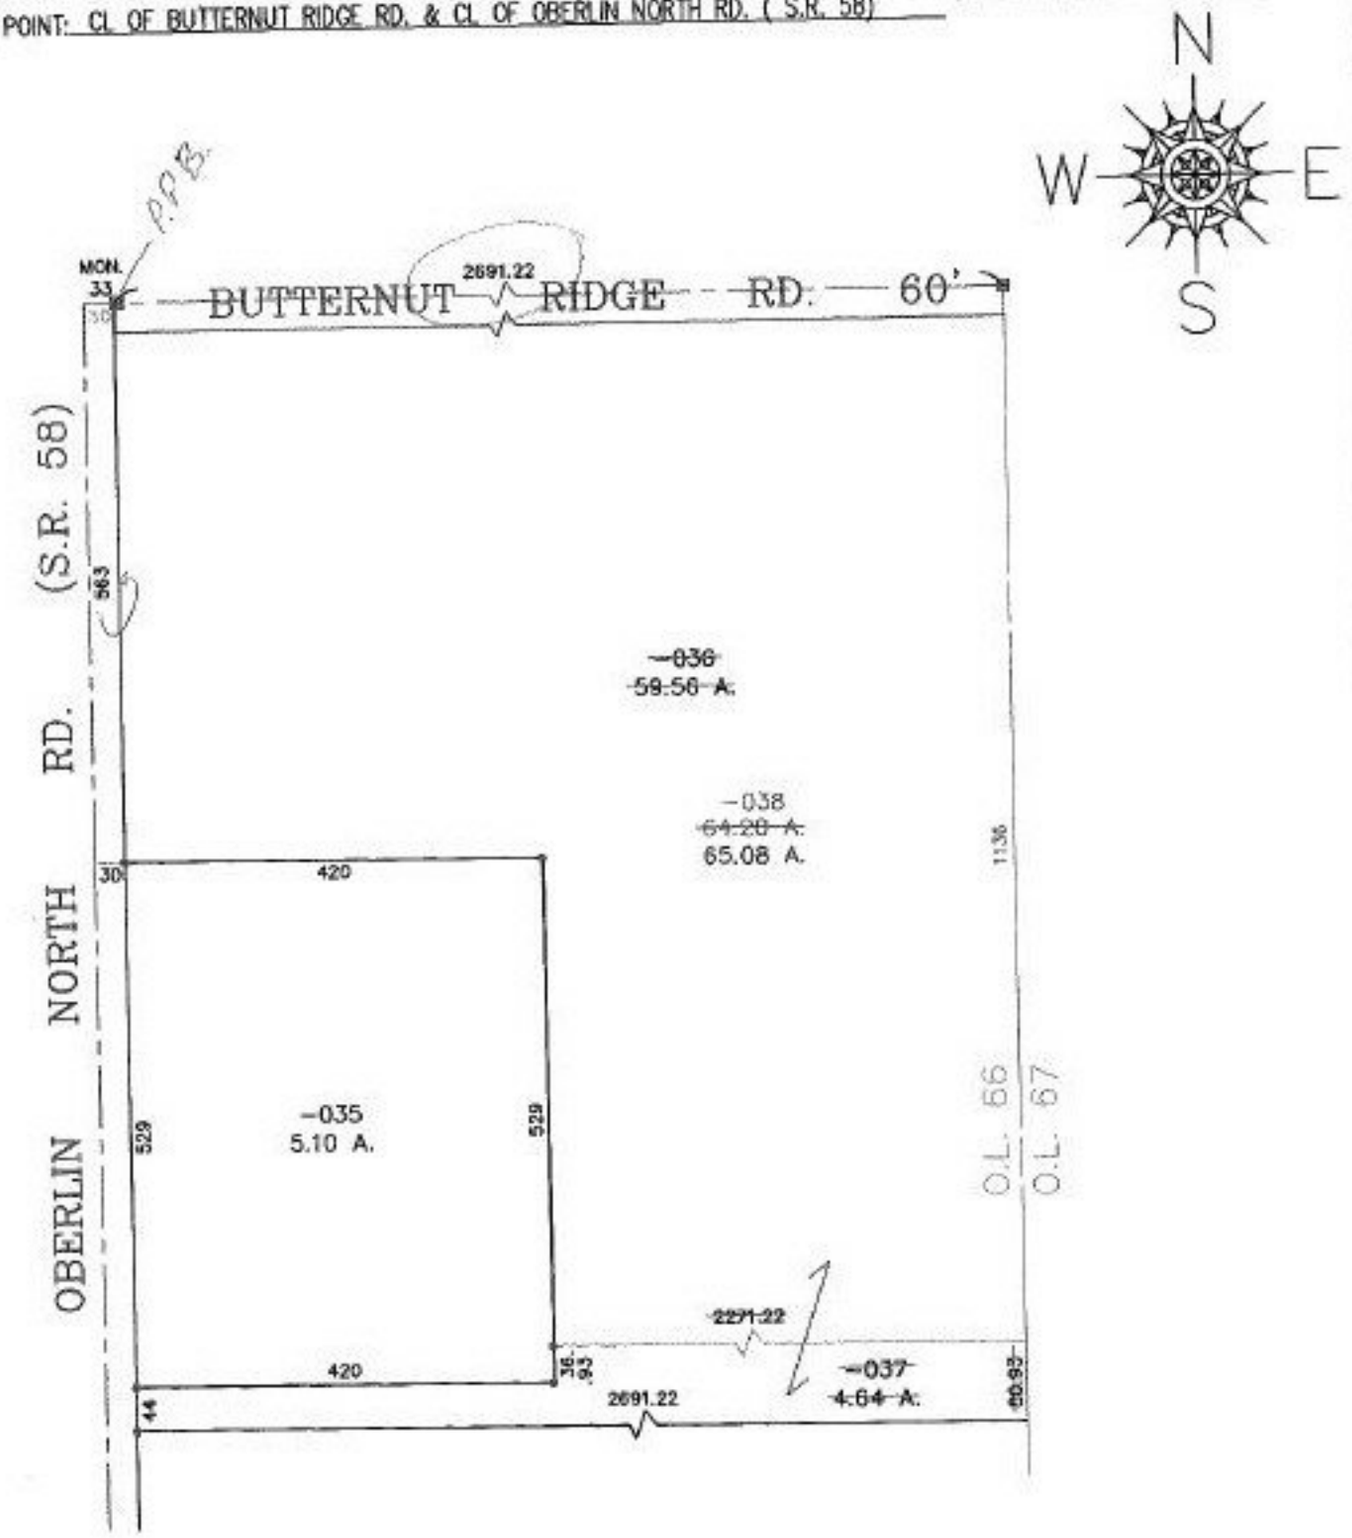

SPLITS/DEEDS PROCESSED

LORAIN COUNTY TAX MAP DEPARTMENT
226 MIDDLE AVE. ELYRIA, OHIO

SURVEYED BY: JOHN POZYWAK

CLOSURE: 0.00 : 10,000

MAP PAGE(S): 09-00-066-A & B

APPROVED BY: TJS DATE: 01/15/99

SCALE: 1" = 200 PRIOR INSTRUMENT: 980585733