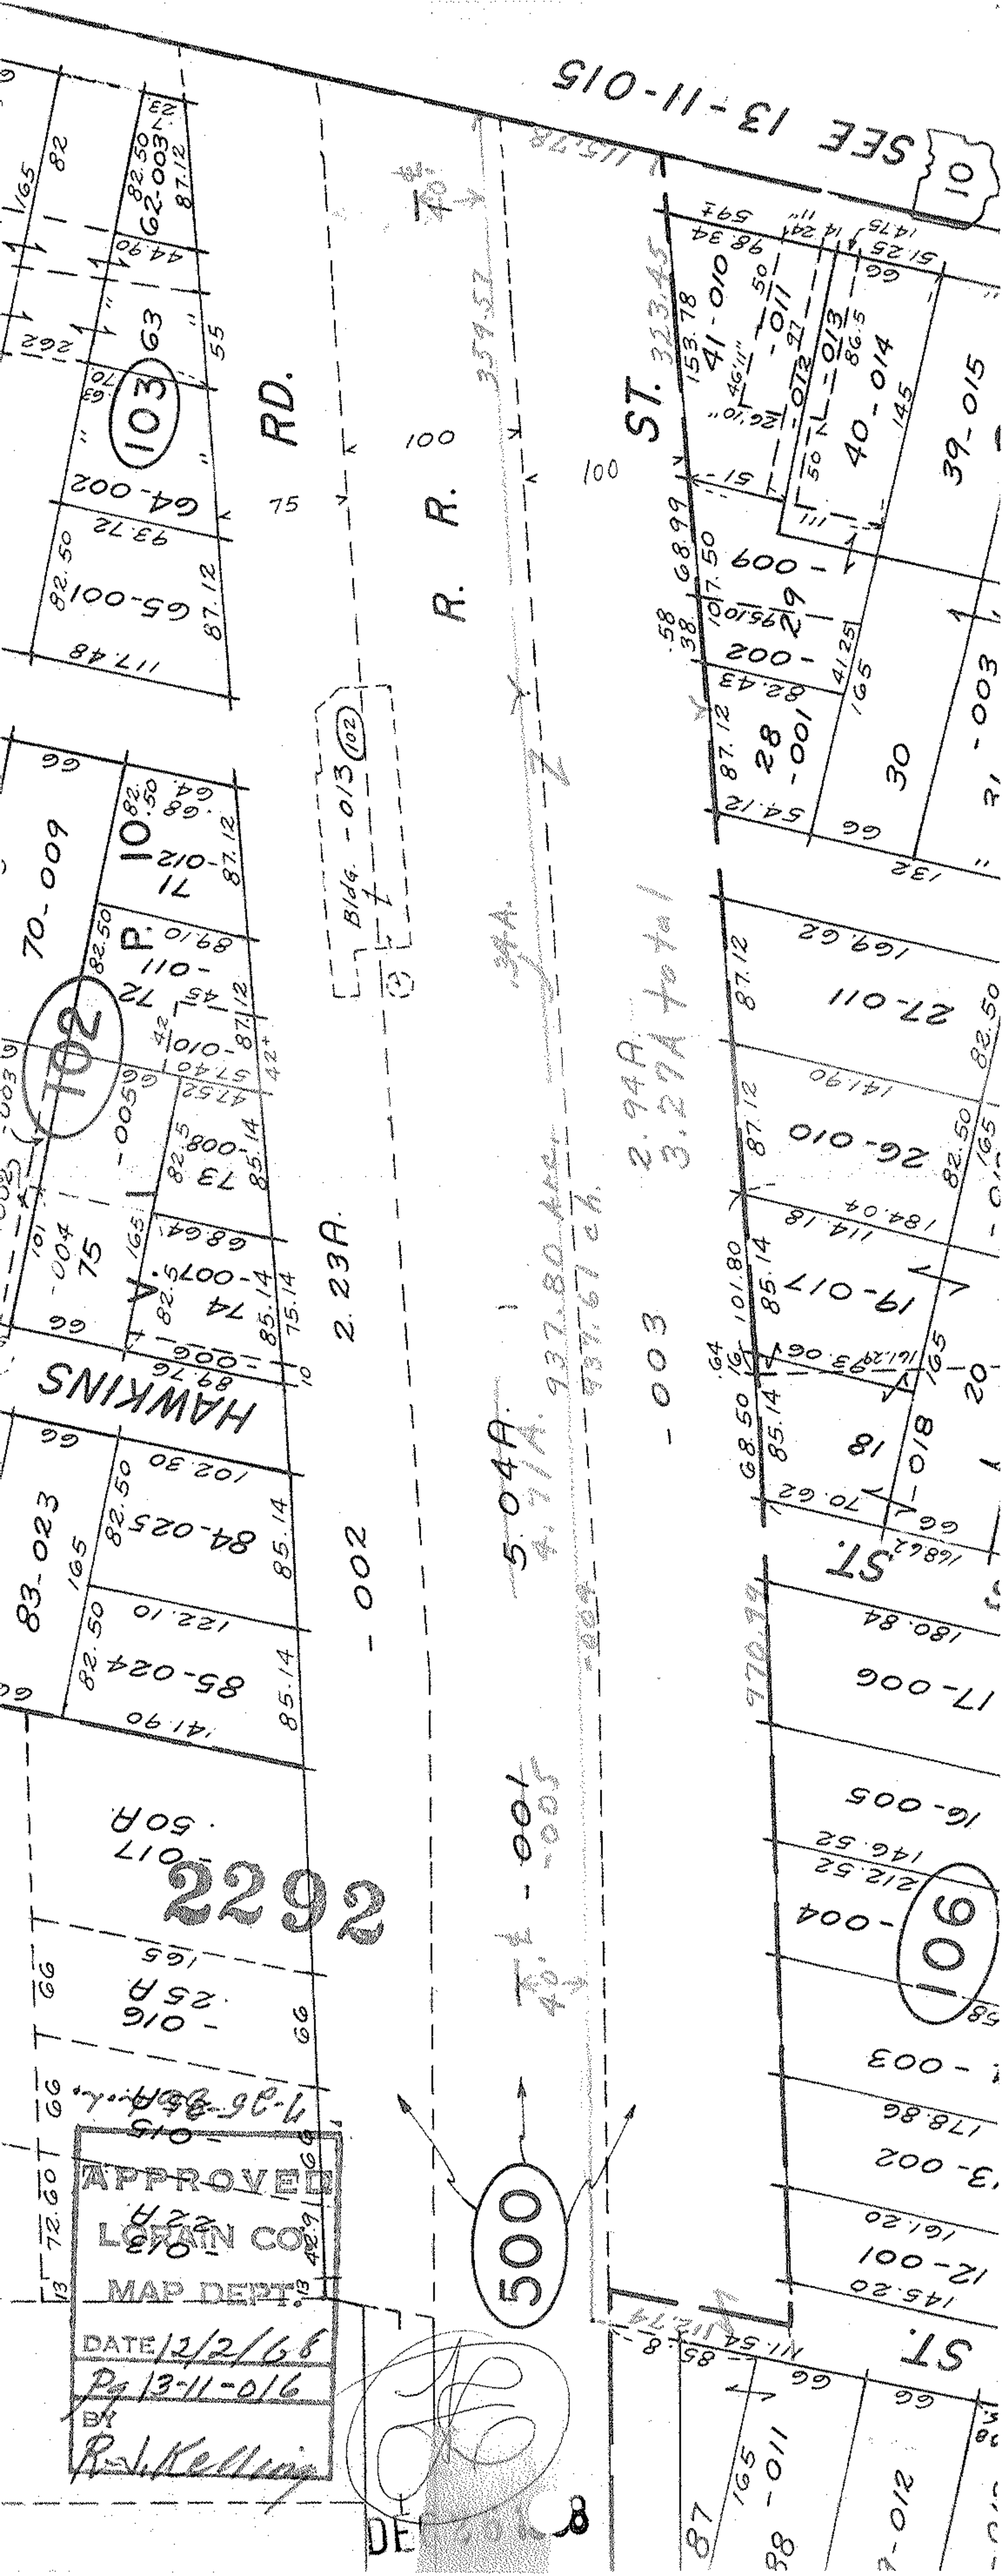
SEE 13-11-015
RD.
R. R.
ST.
HAWKINS
2292
500
103
102
106
APPROVED
LORAIN CO.
MAP DEPT.
DATE 12/2/68
Pg 13-11-016
BY
R. J. Kelling