


-069
~~069~~
28.03 AC
19.53

002A

94
98

WOOSTER AVE. TAKE

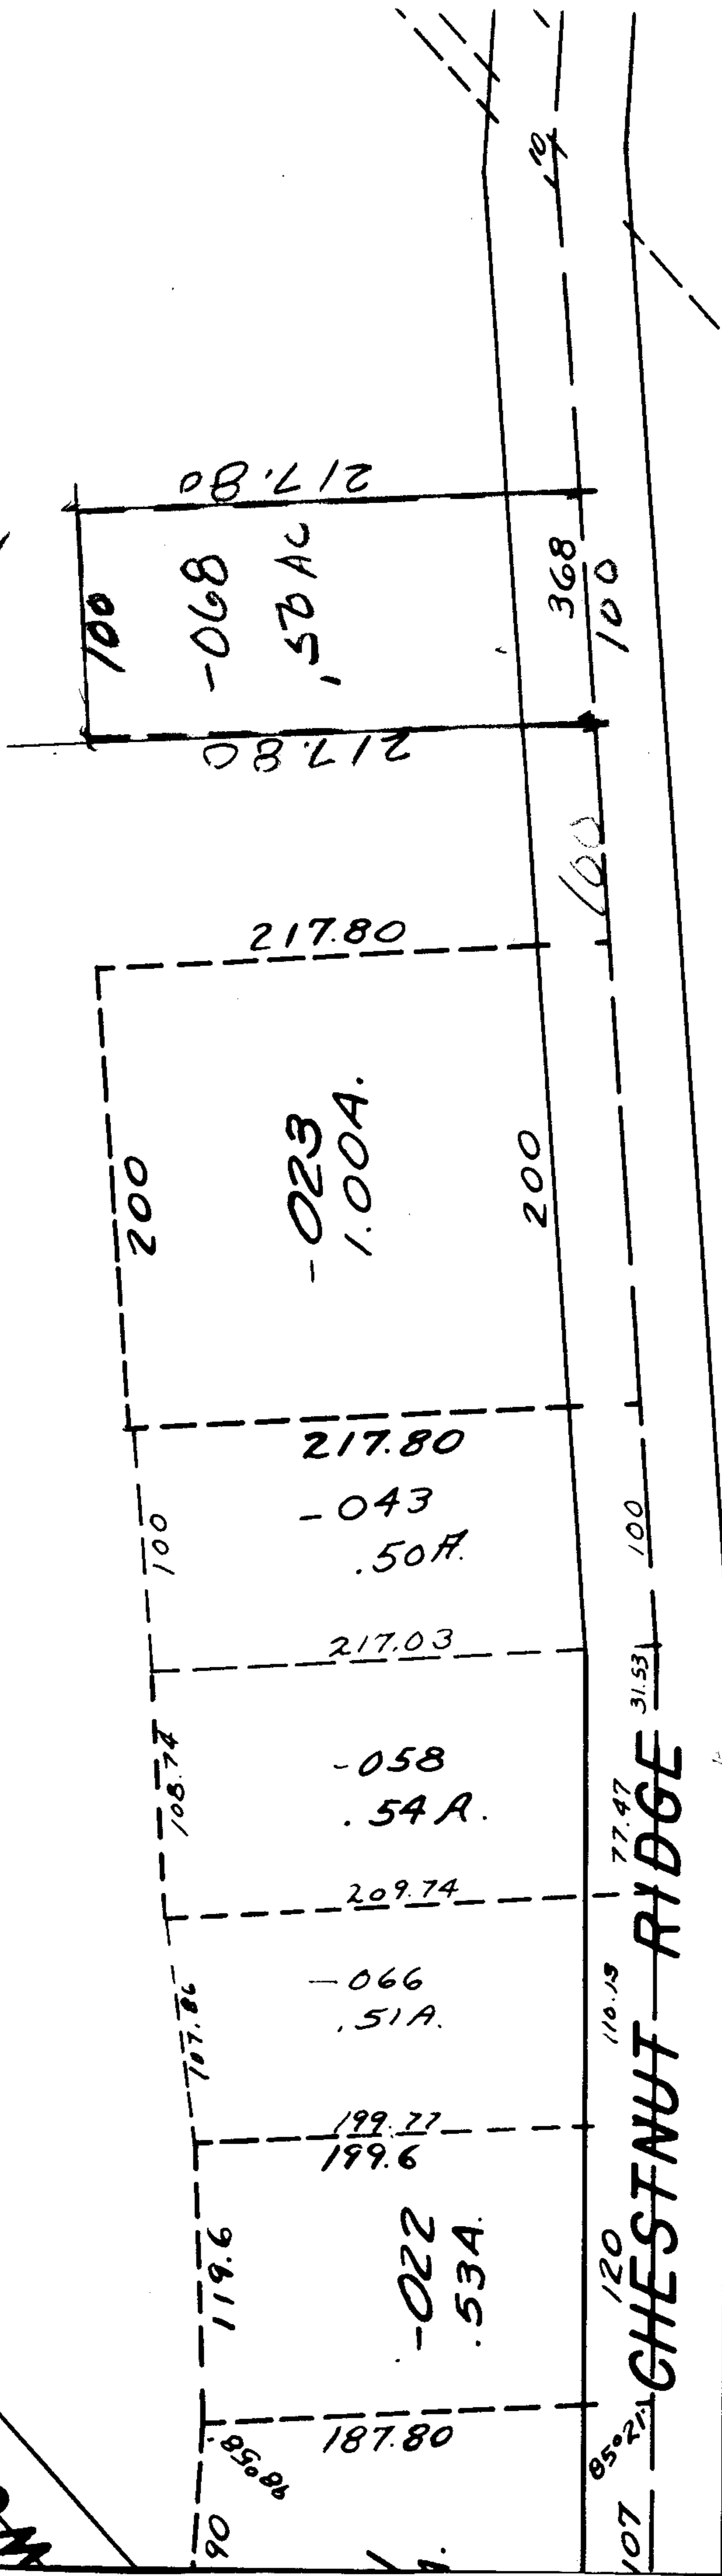

-001
5.00A

#2297
APPROVED
LORAIN CO.
MAP DEPT.
DATE 12-3-68
7-00-023C
BY LWHall

7-00-023C