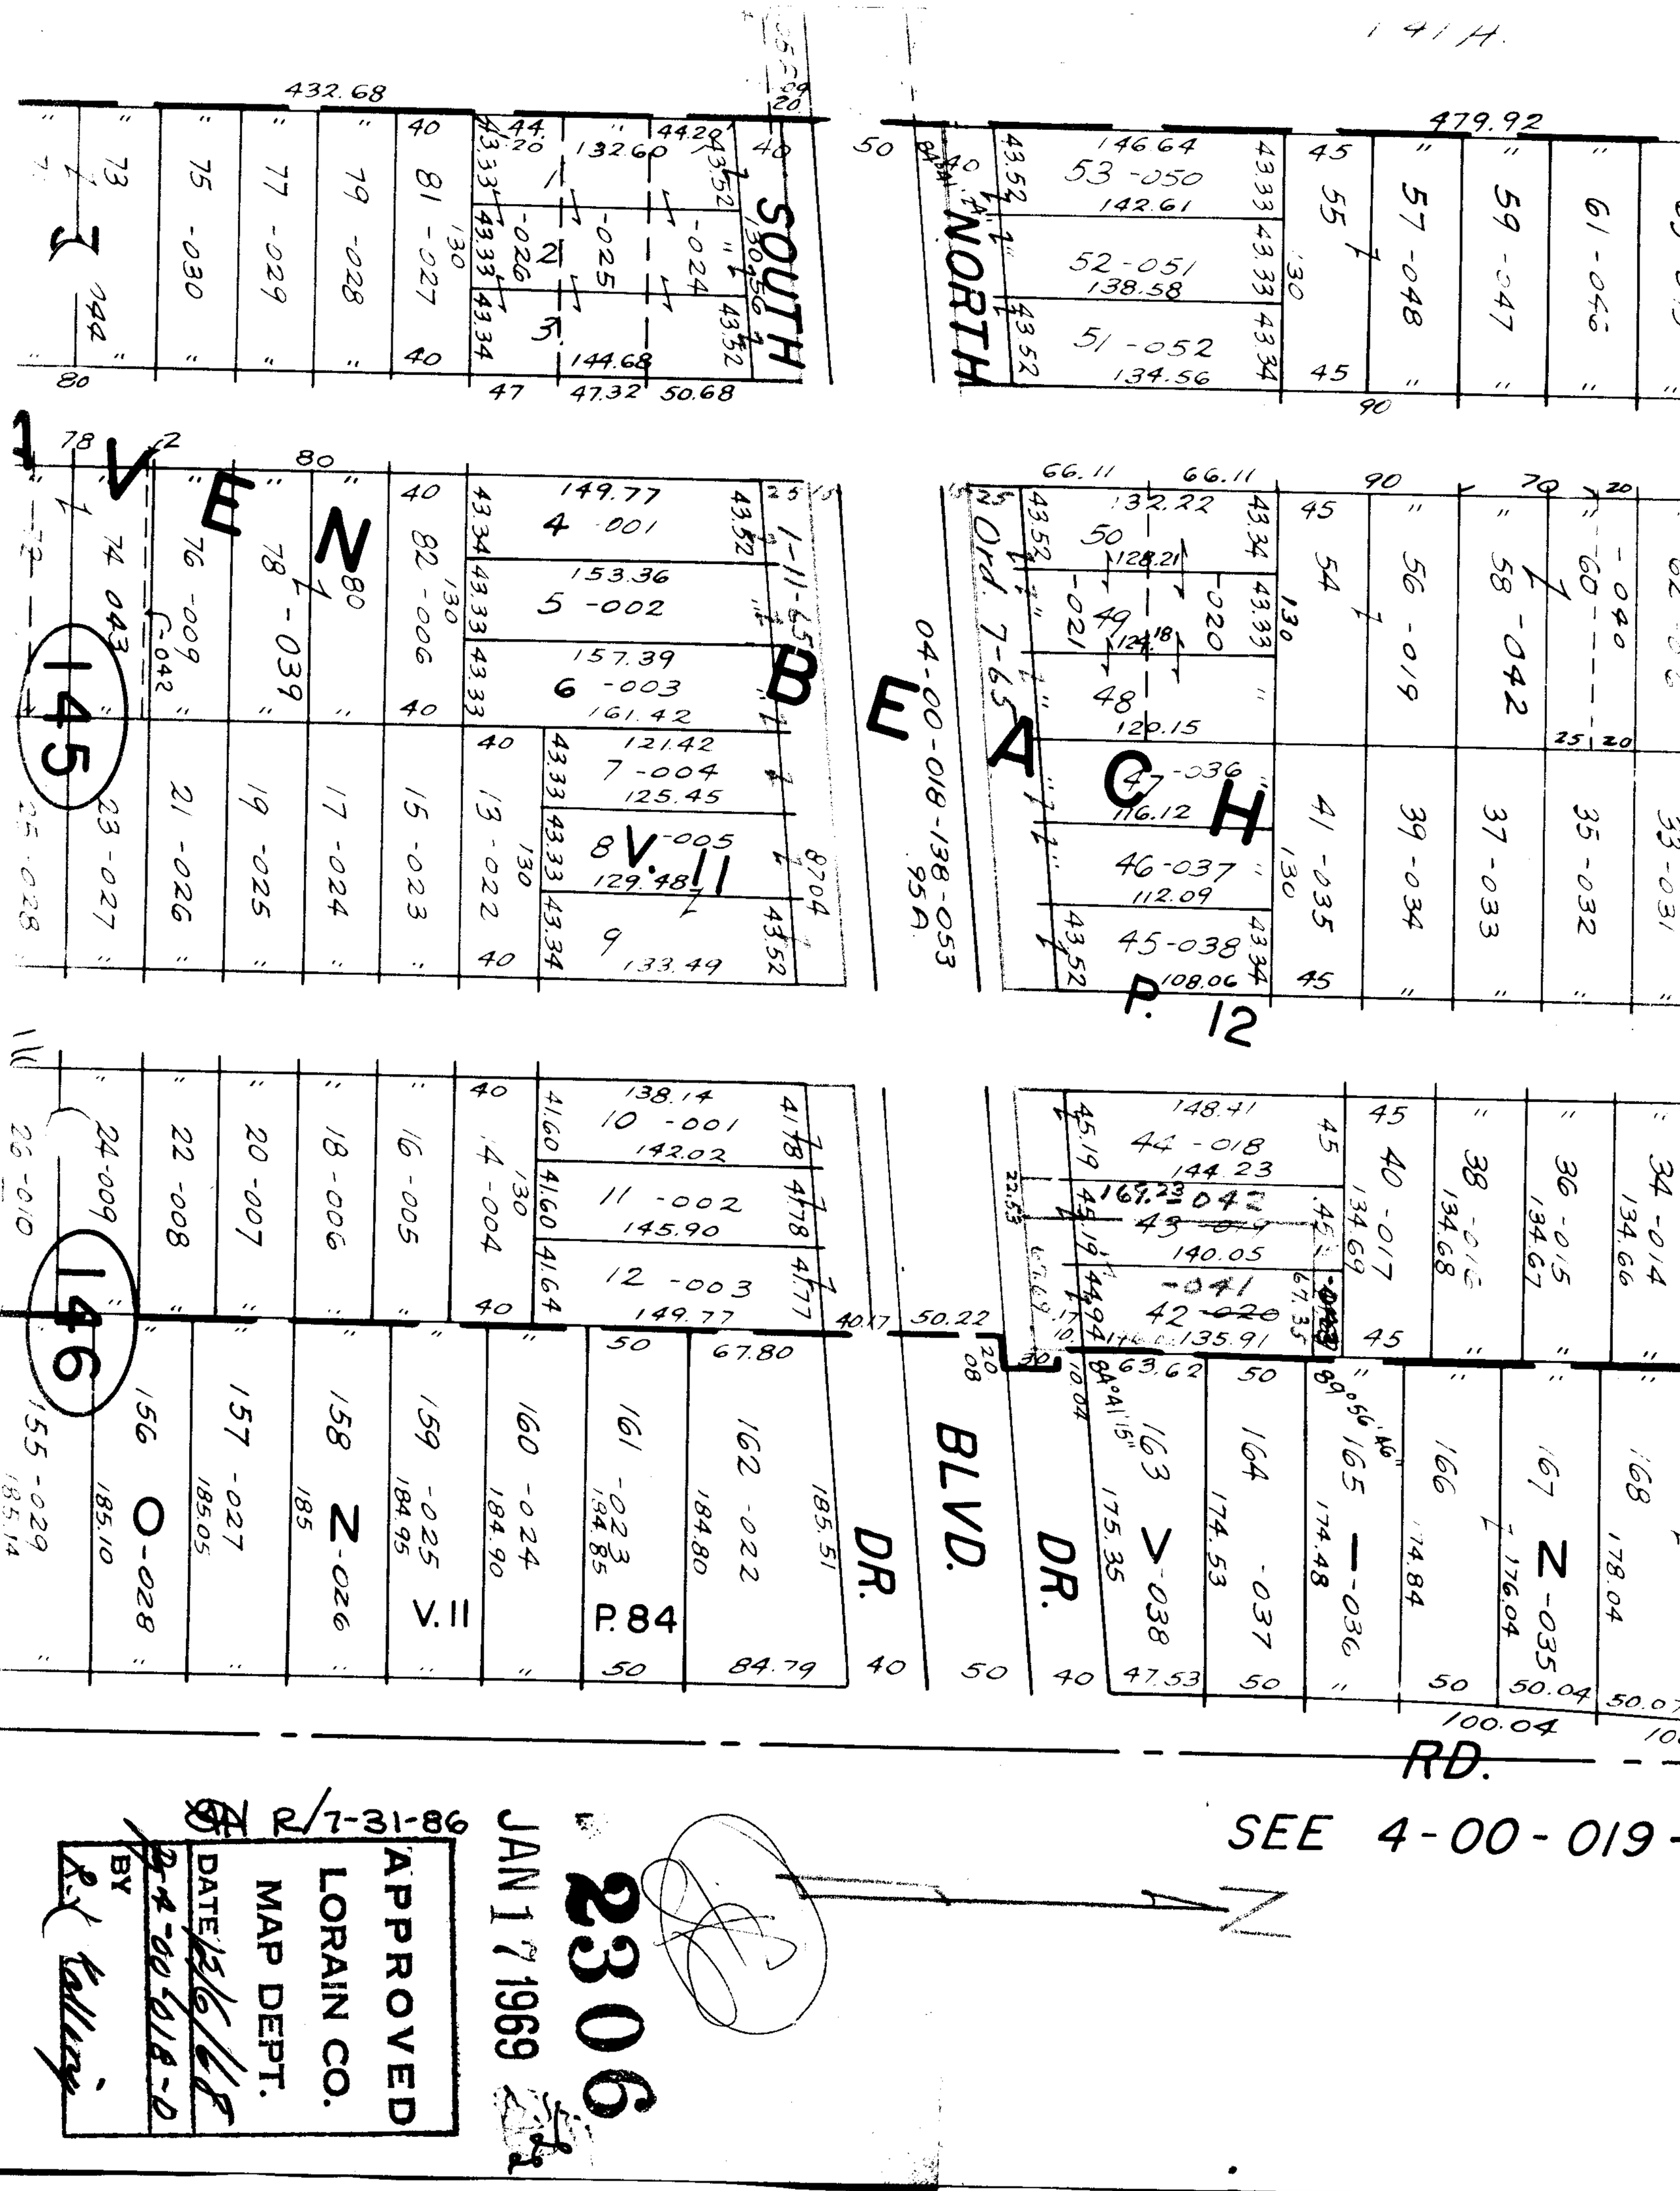

R/7-31-86
APPROVED
LORAIN CO.
MAP DEPT.
DATE 12/6/68
BY
JAN 17 1969
2306