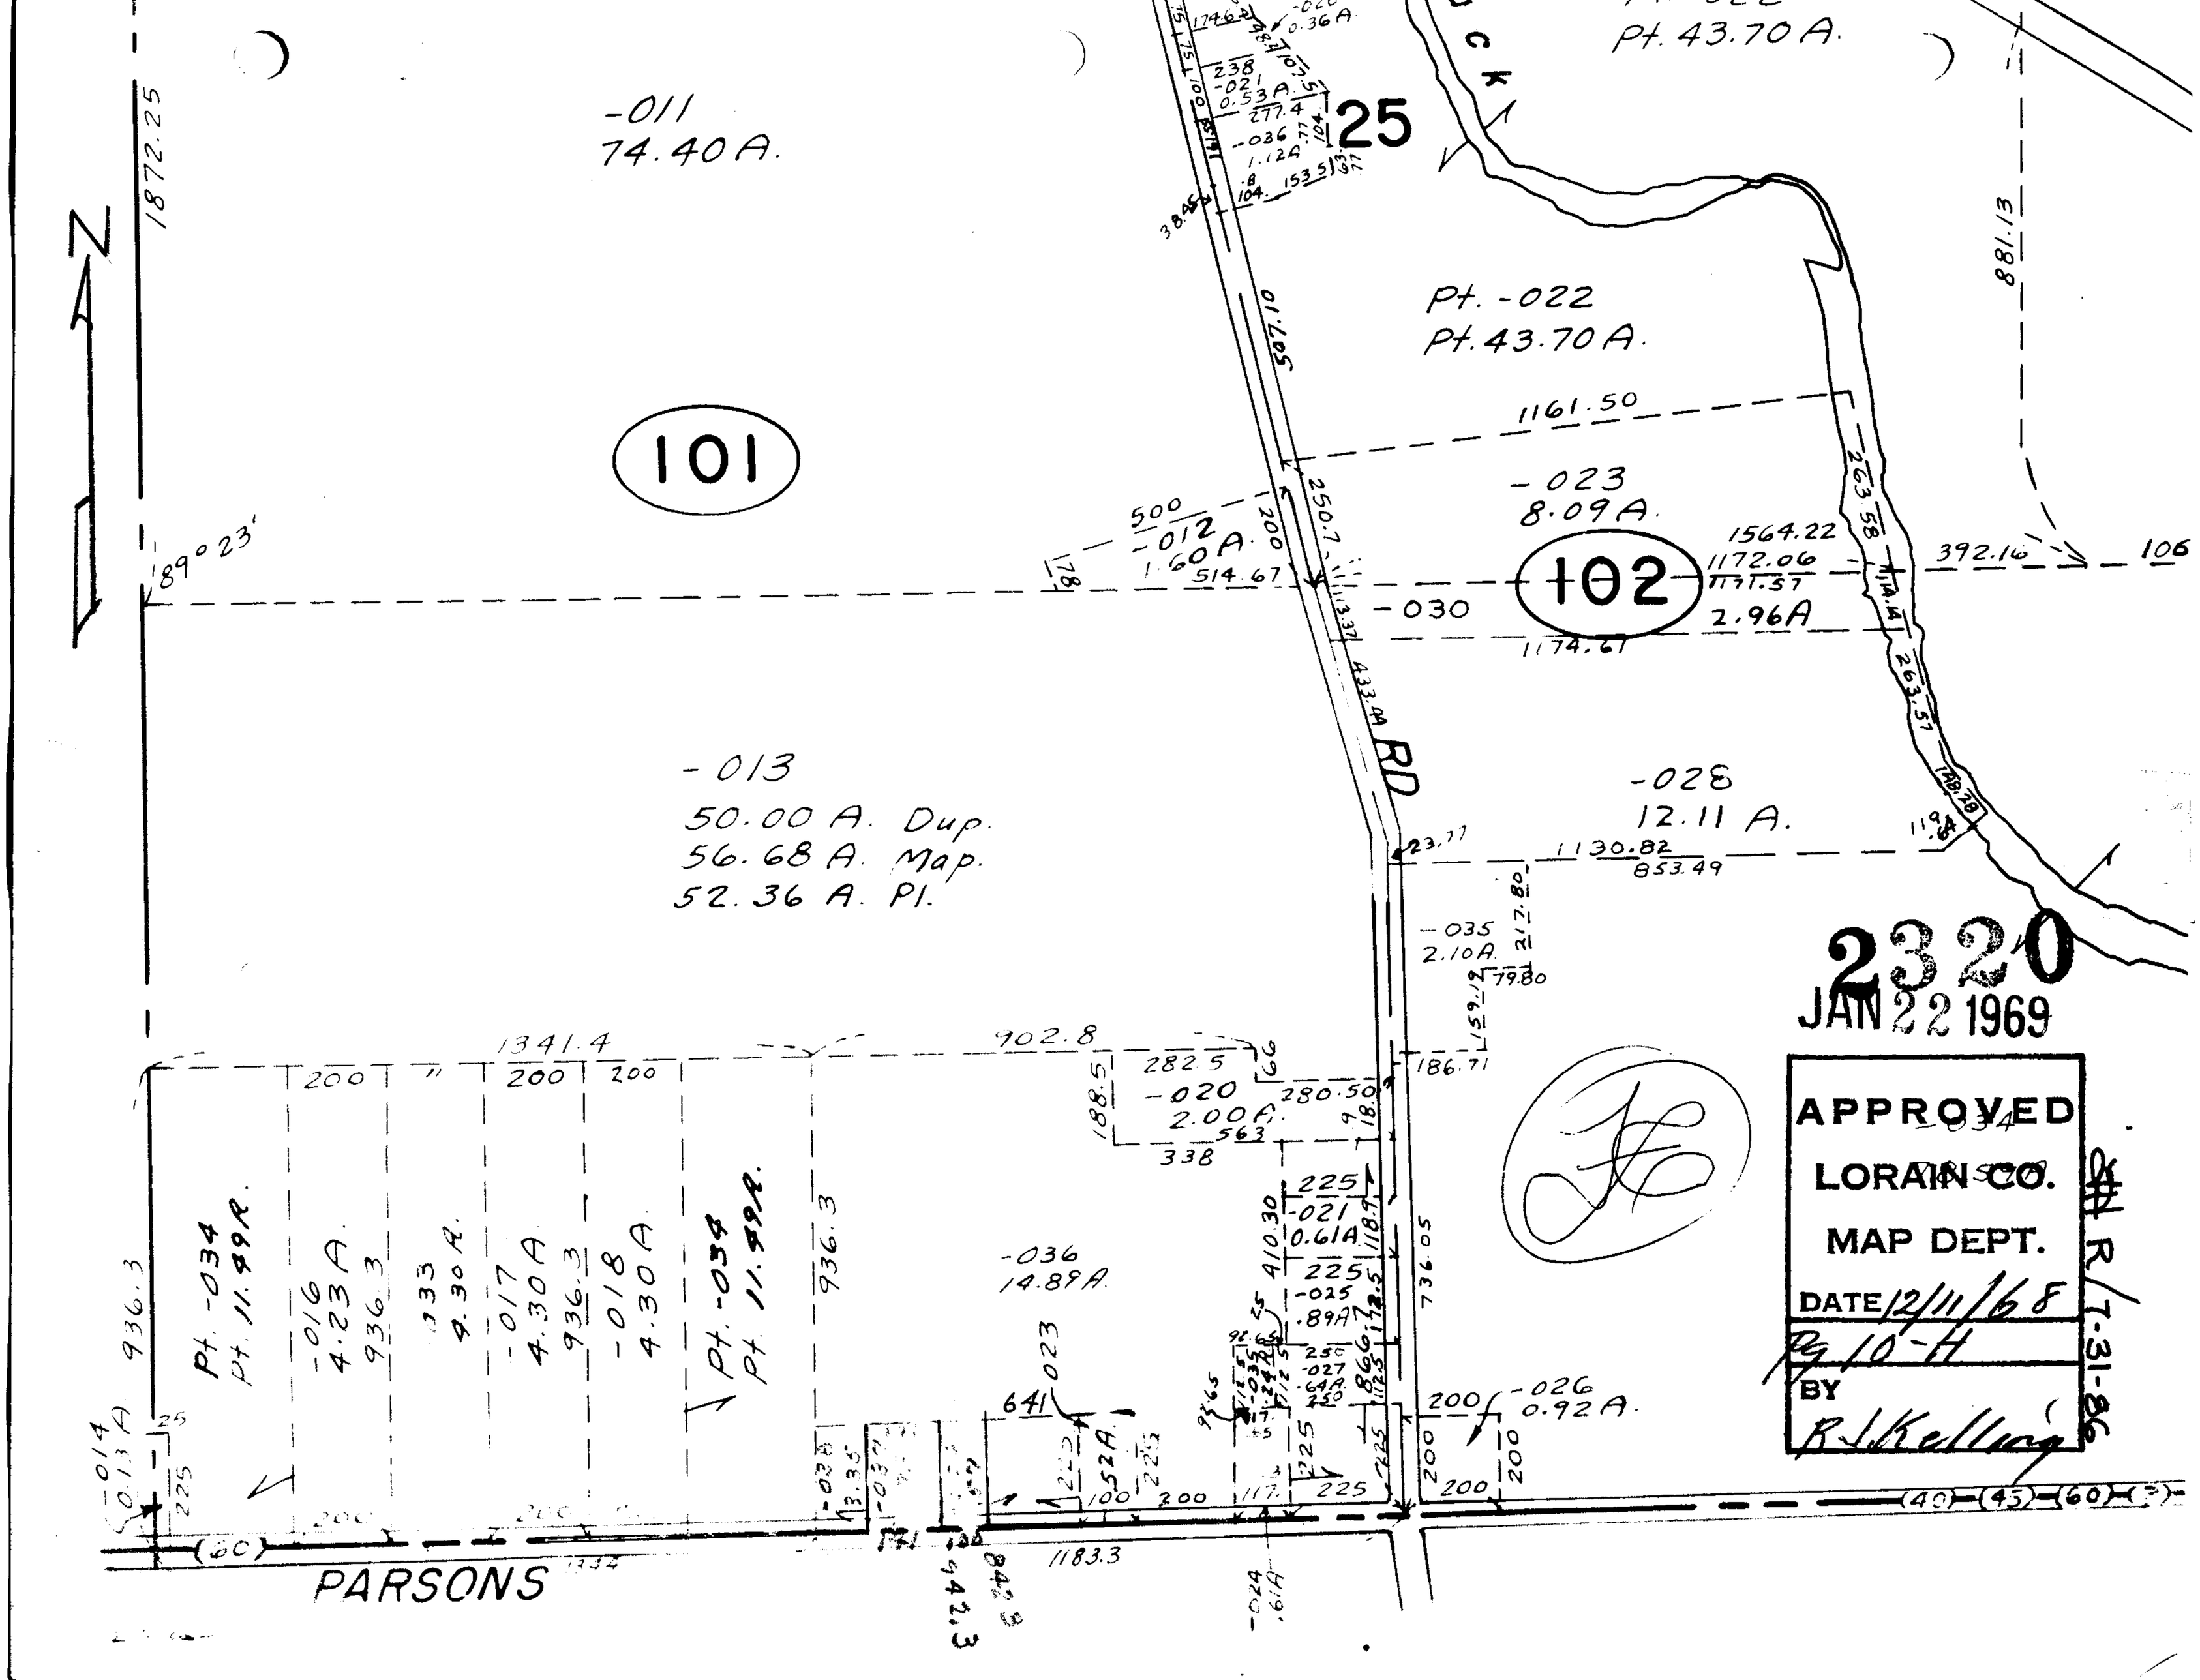

2320
JAN 22 1969

APPROVED
LORAIN CO.
MAP DEPT.
DATE 12/11/68
Pg 10-H
BY R.J. Kelling

R/7-31-86