


EE 18-00-028-D

18

2322 2323

W. MAIN ST.

AVL.

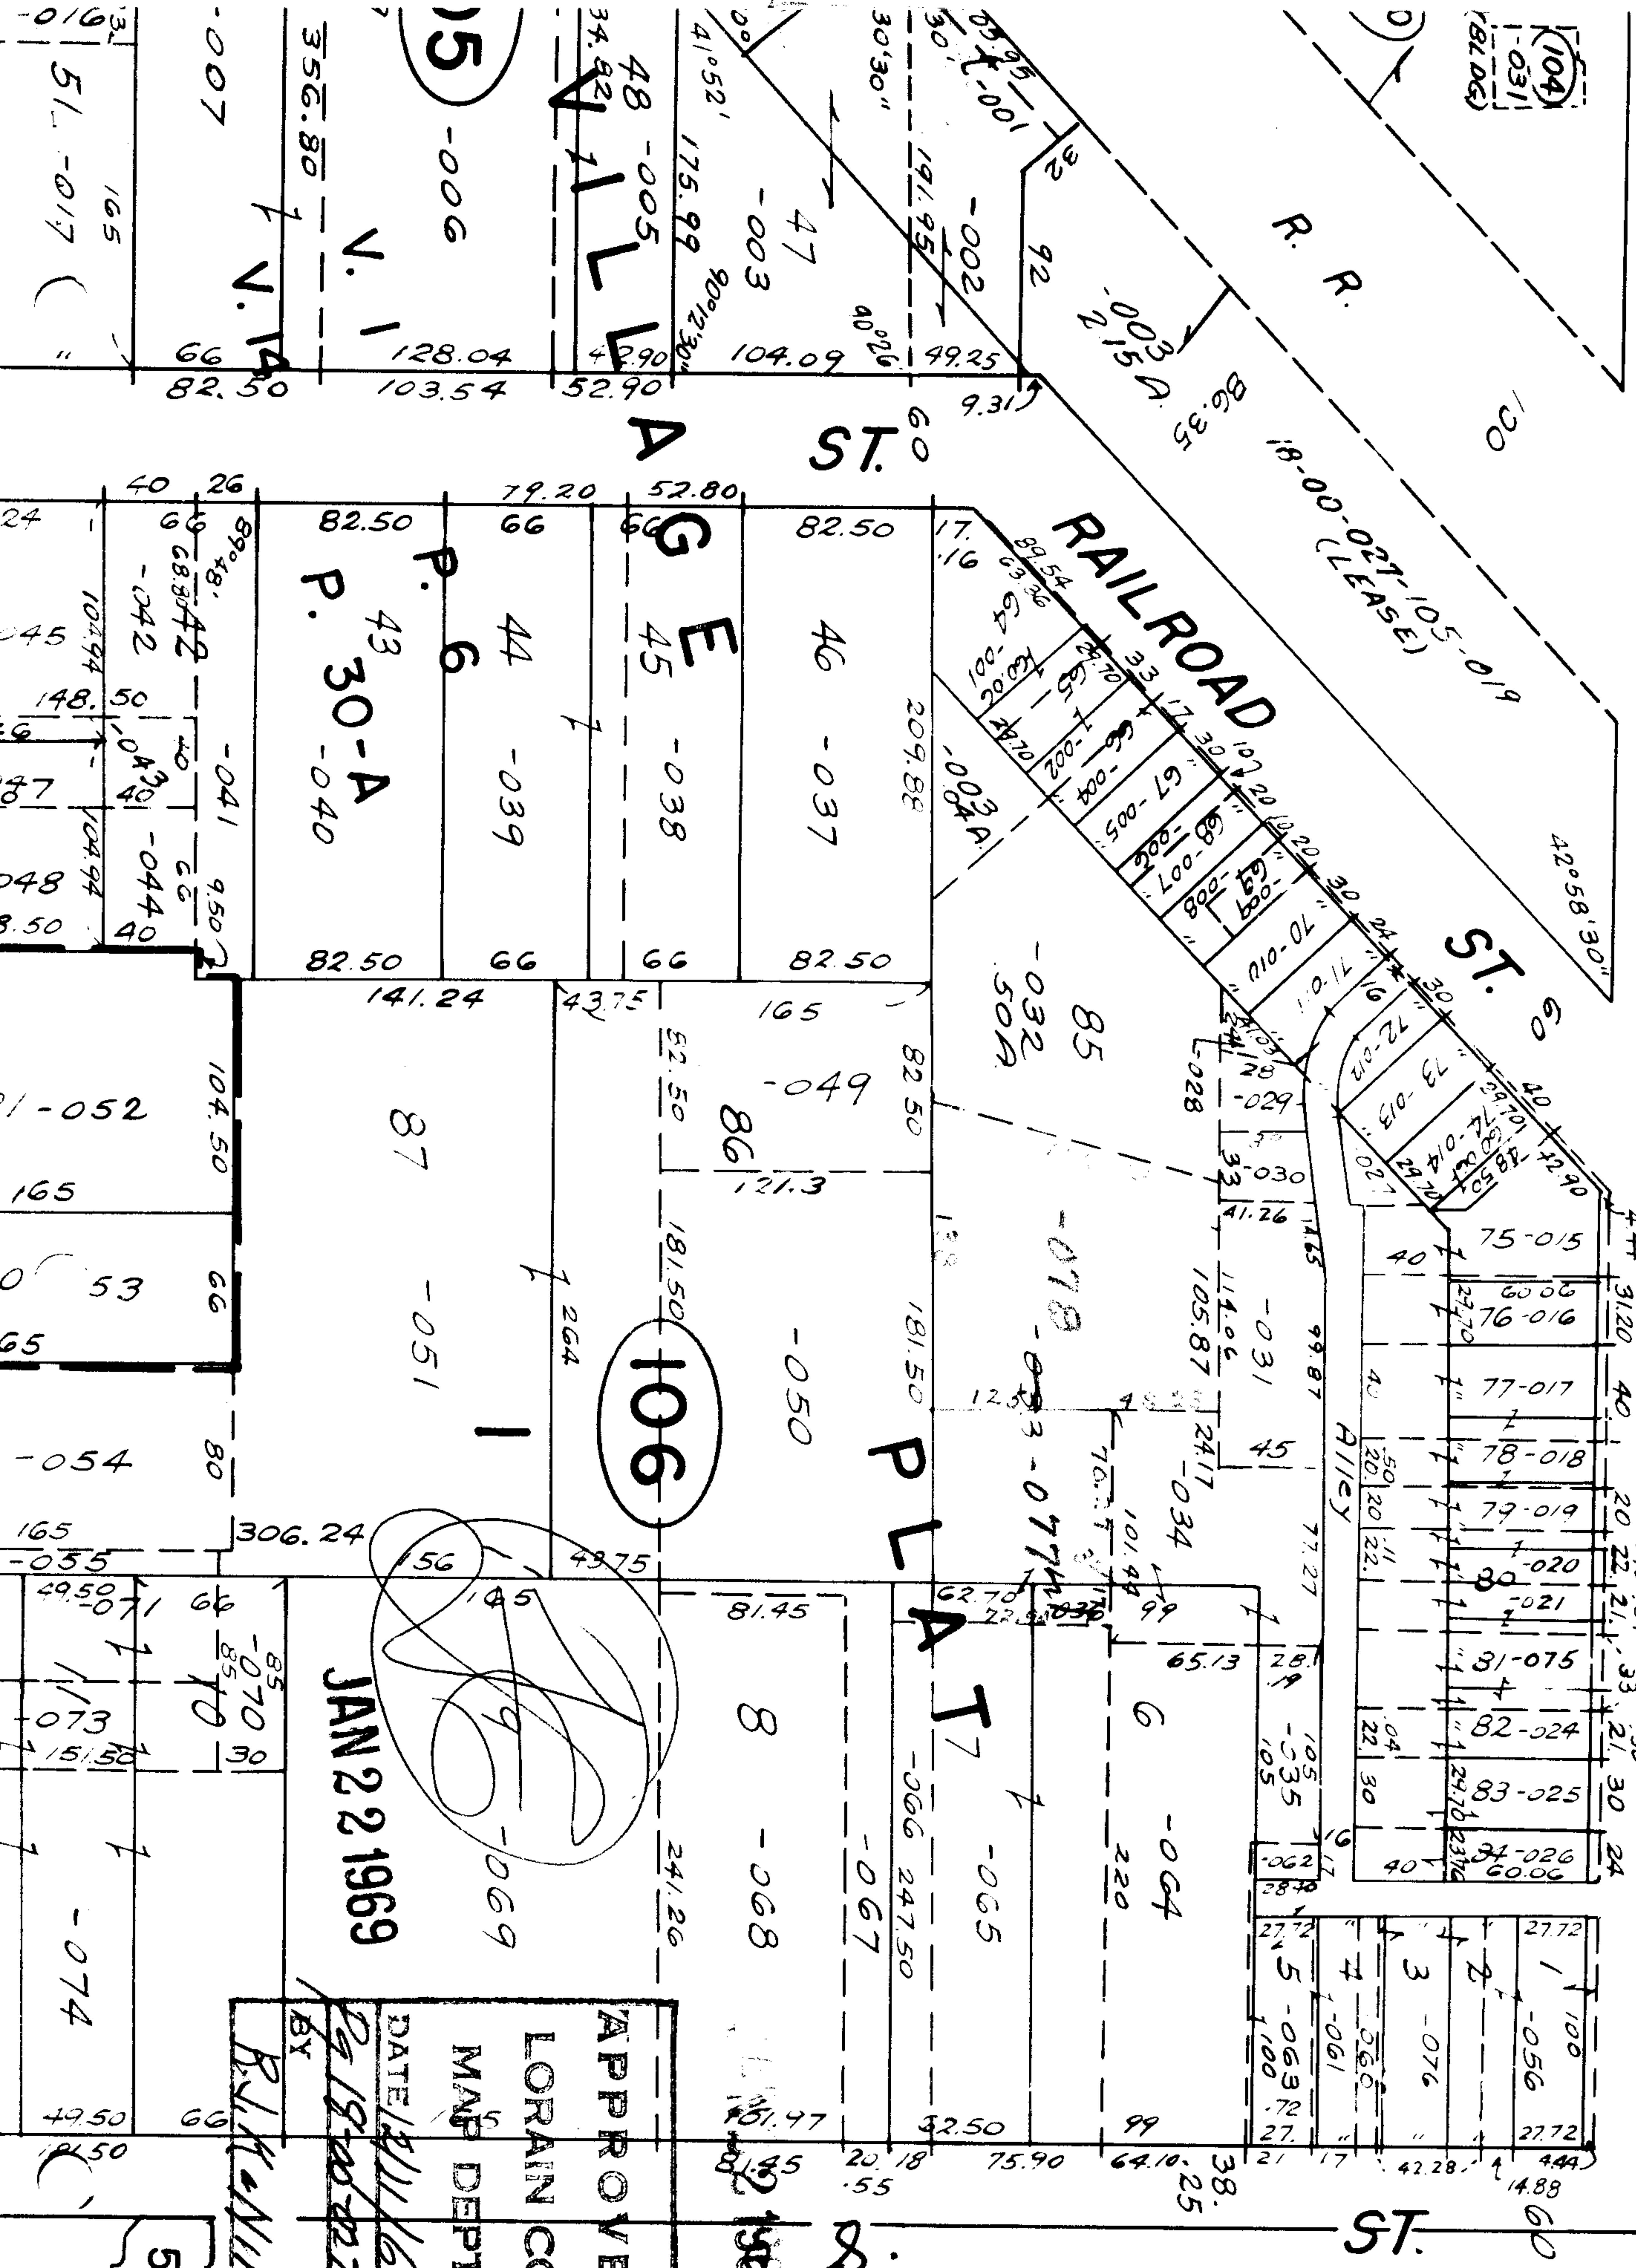

JAN 22 1969

APPROVED
 LORAIN CO.
 MAP DEPT.
 DATE 1/21/68
 BY [Signature]

8-28-68

58

2-A