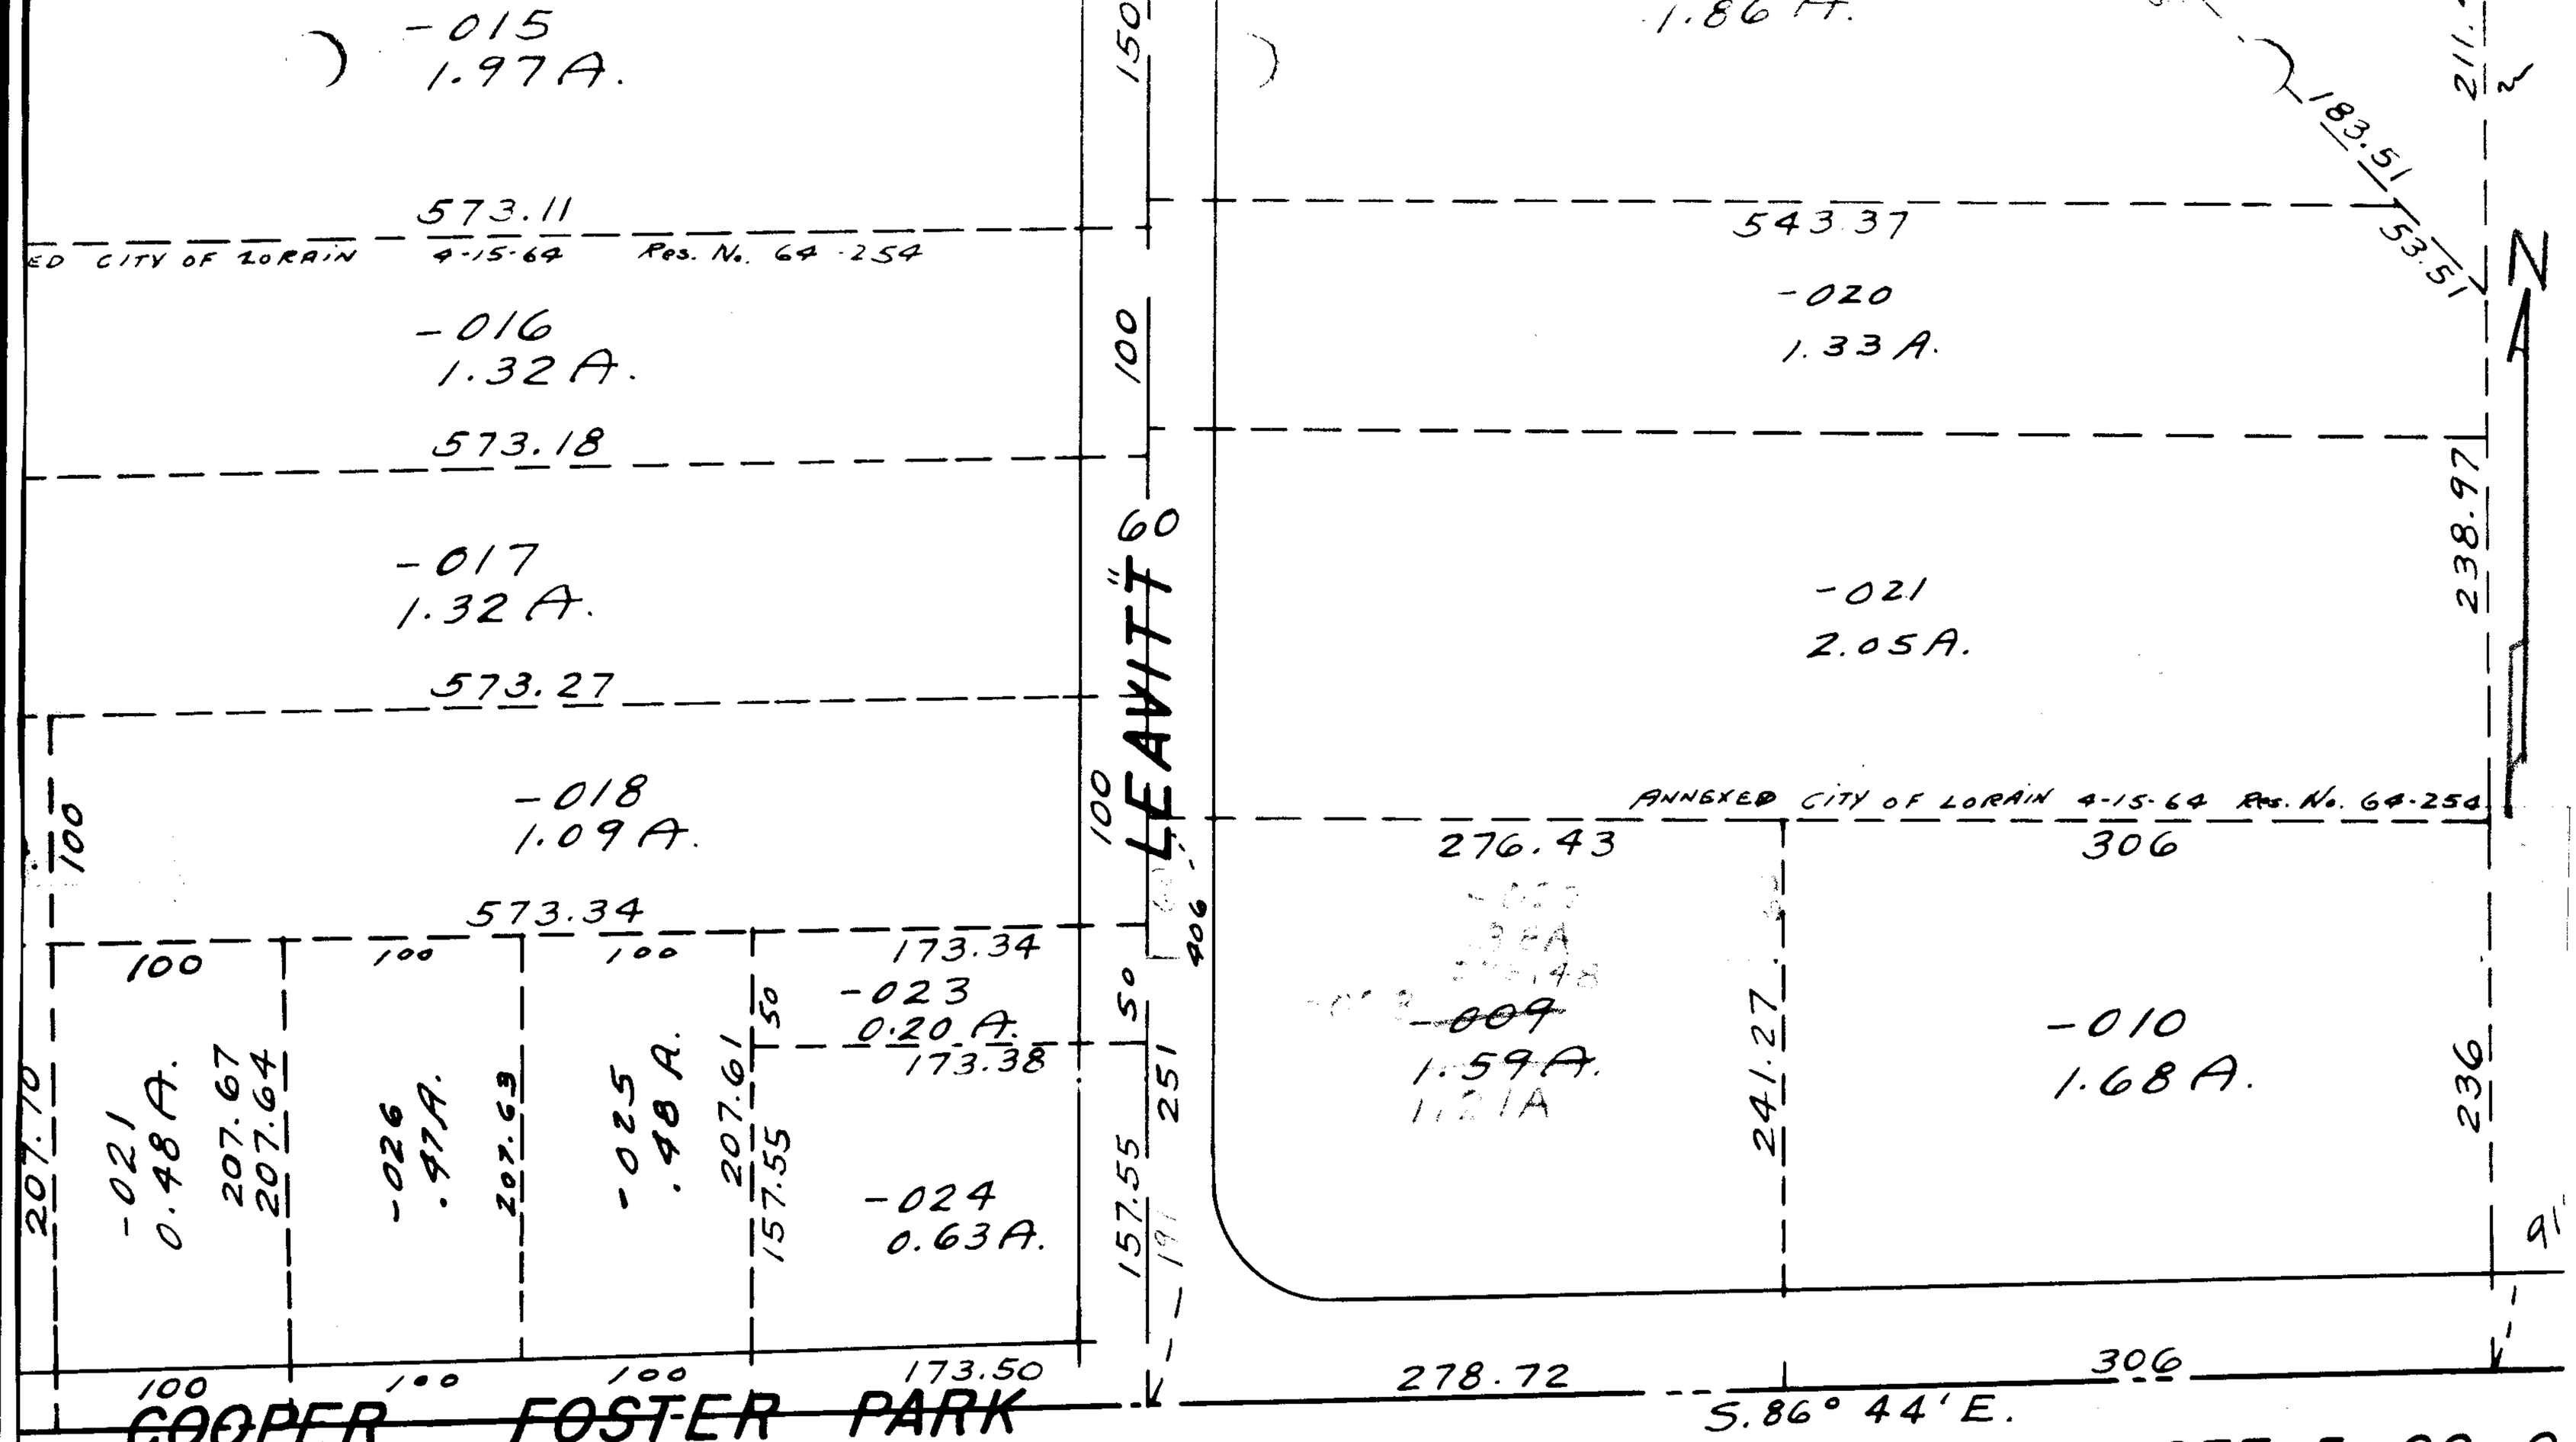

SEE 5-00-0

JAN 16 1969

2336

APPROVED
LORAIN CO.
MAP DEPT.
DATE 12/17/68
Pg 2-02-003
BY R.J. Kelling

S.S. 7-15-86

BLACK RIVER TWP.

SCALE: 1" = 100'