


101

JAN 16 1969

2349

APPROVED
 LORAIN CO.
 MAP DEPT.
 DATE 12/26/68
 22-02-023-A
 BY R. J. Kelling

7-15-86 S.S.

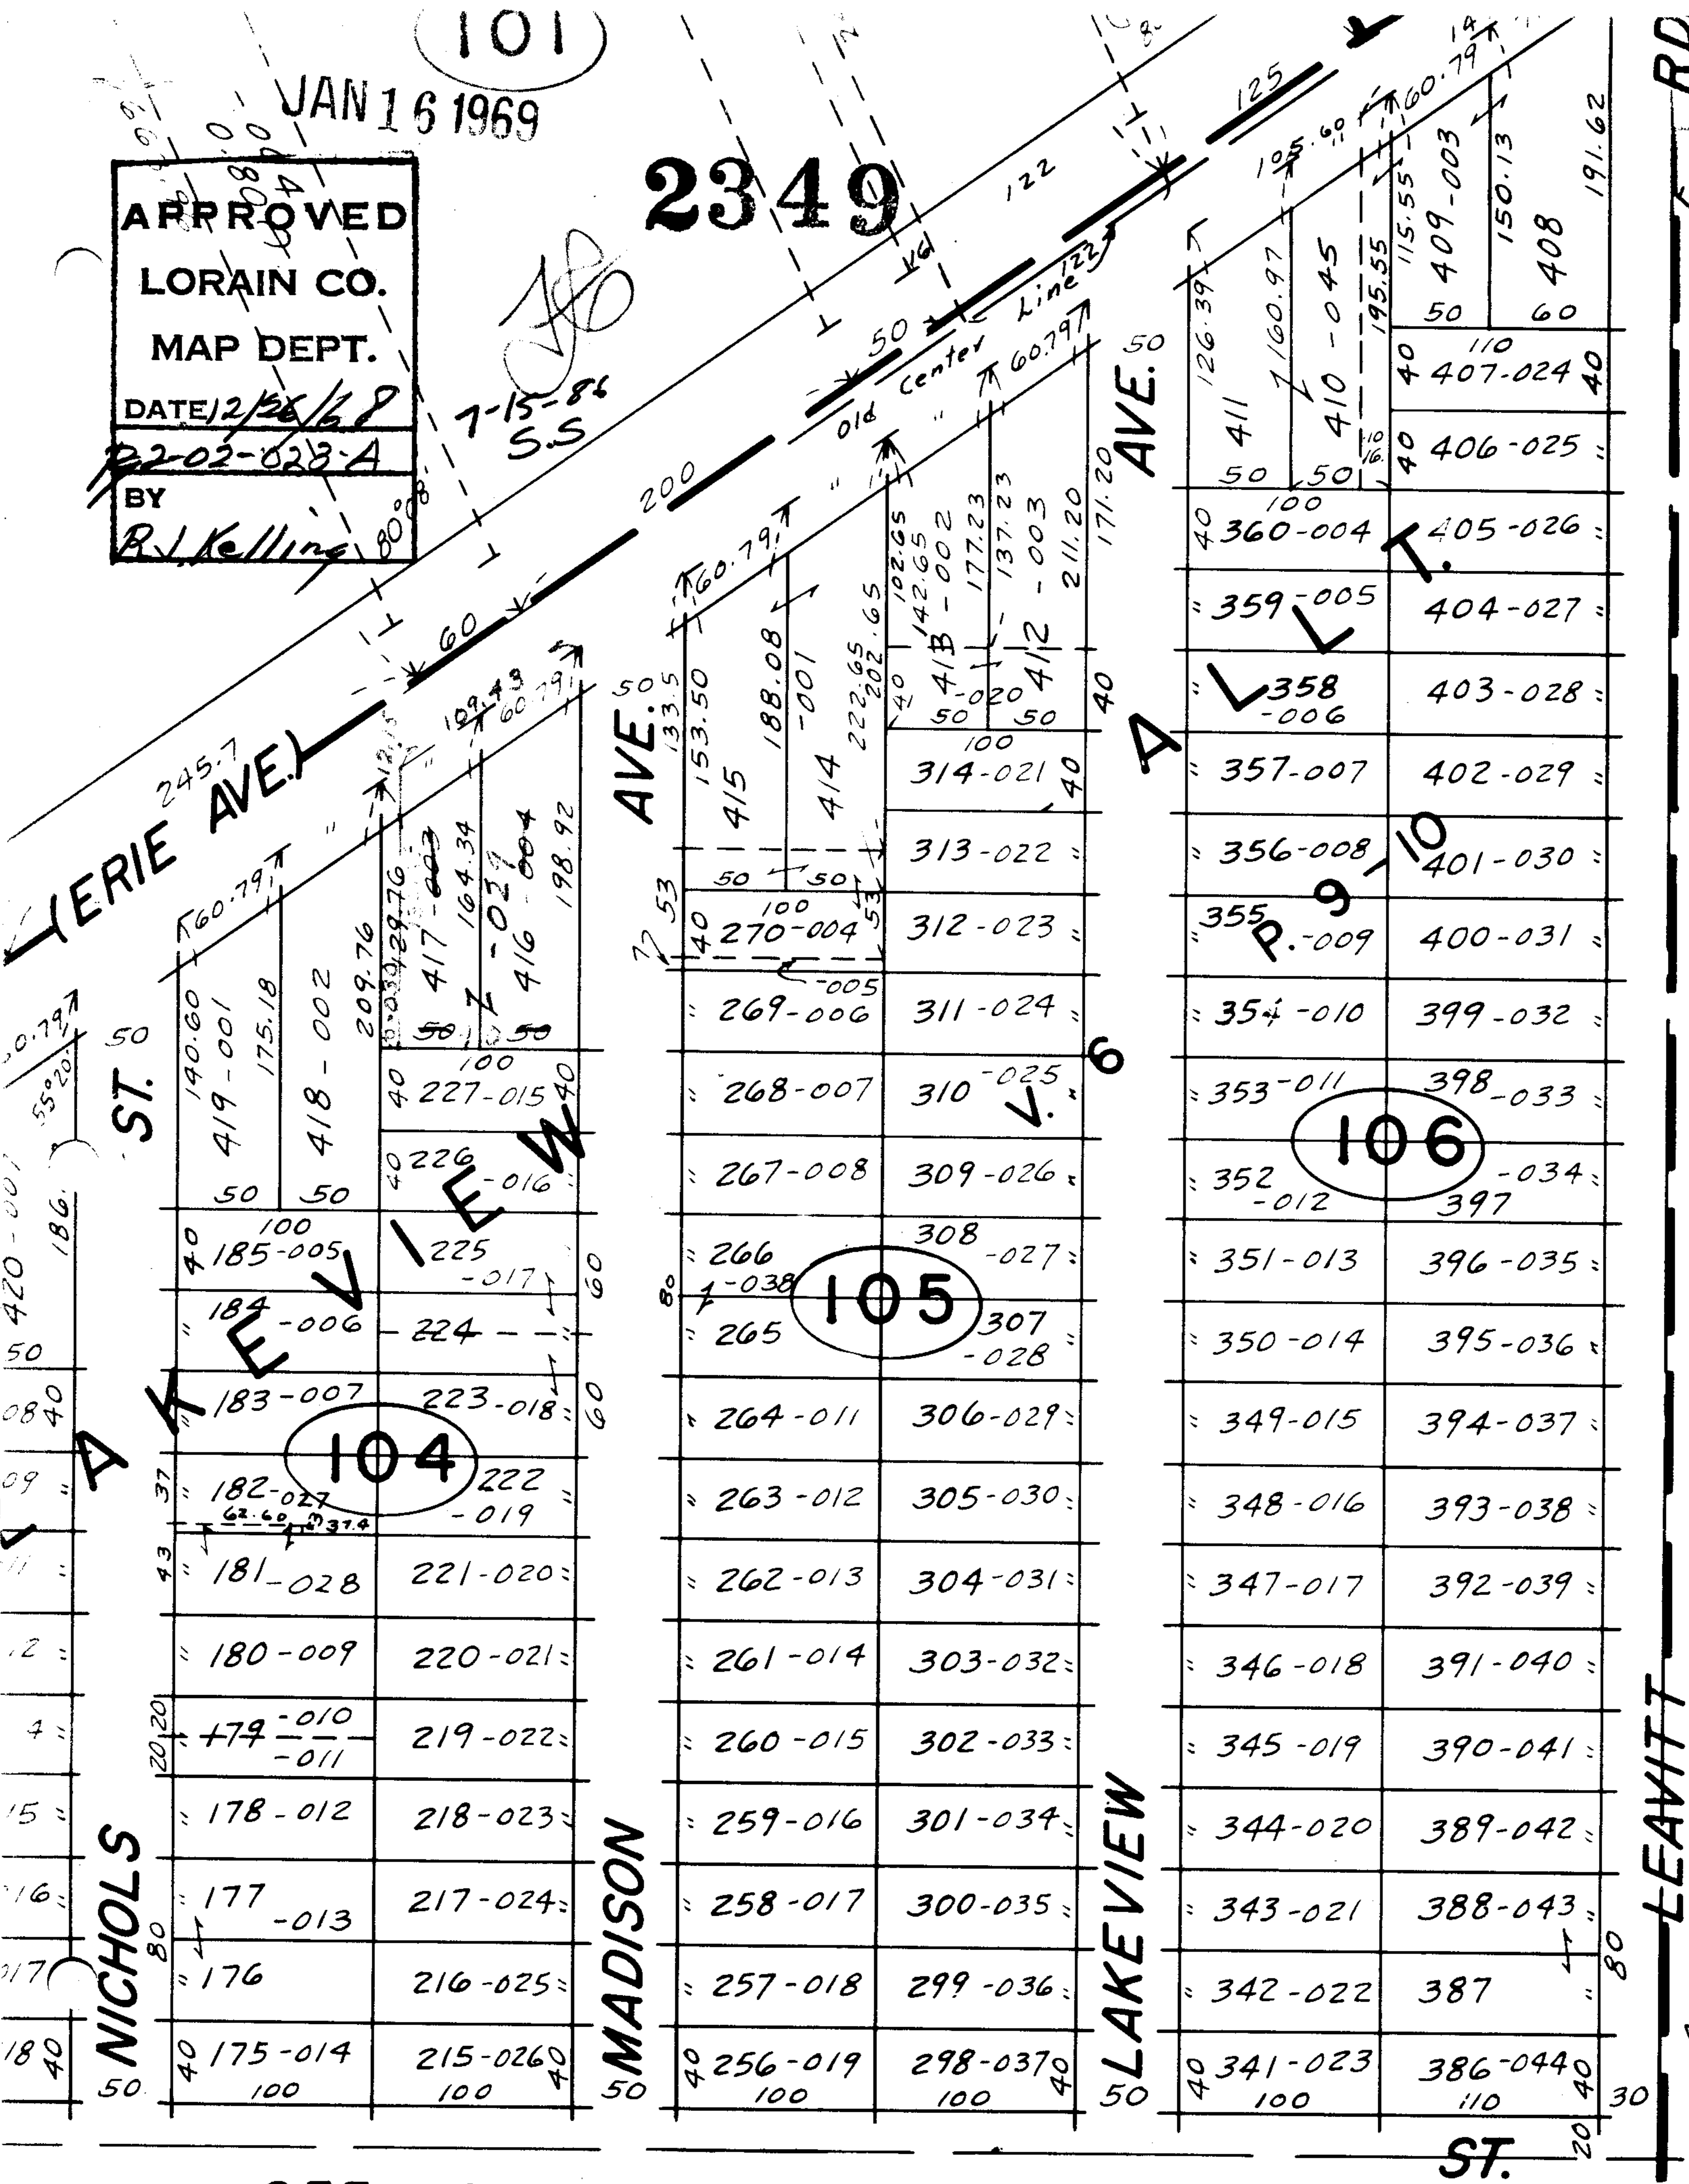

SEE 2-02-023-B

ST.