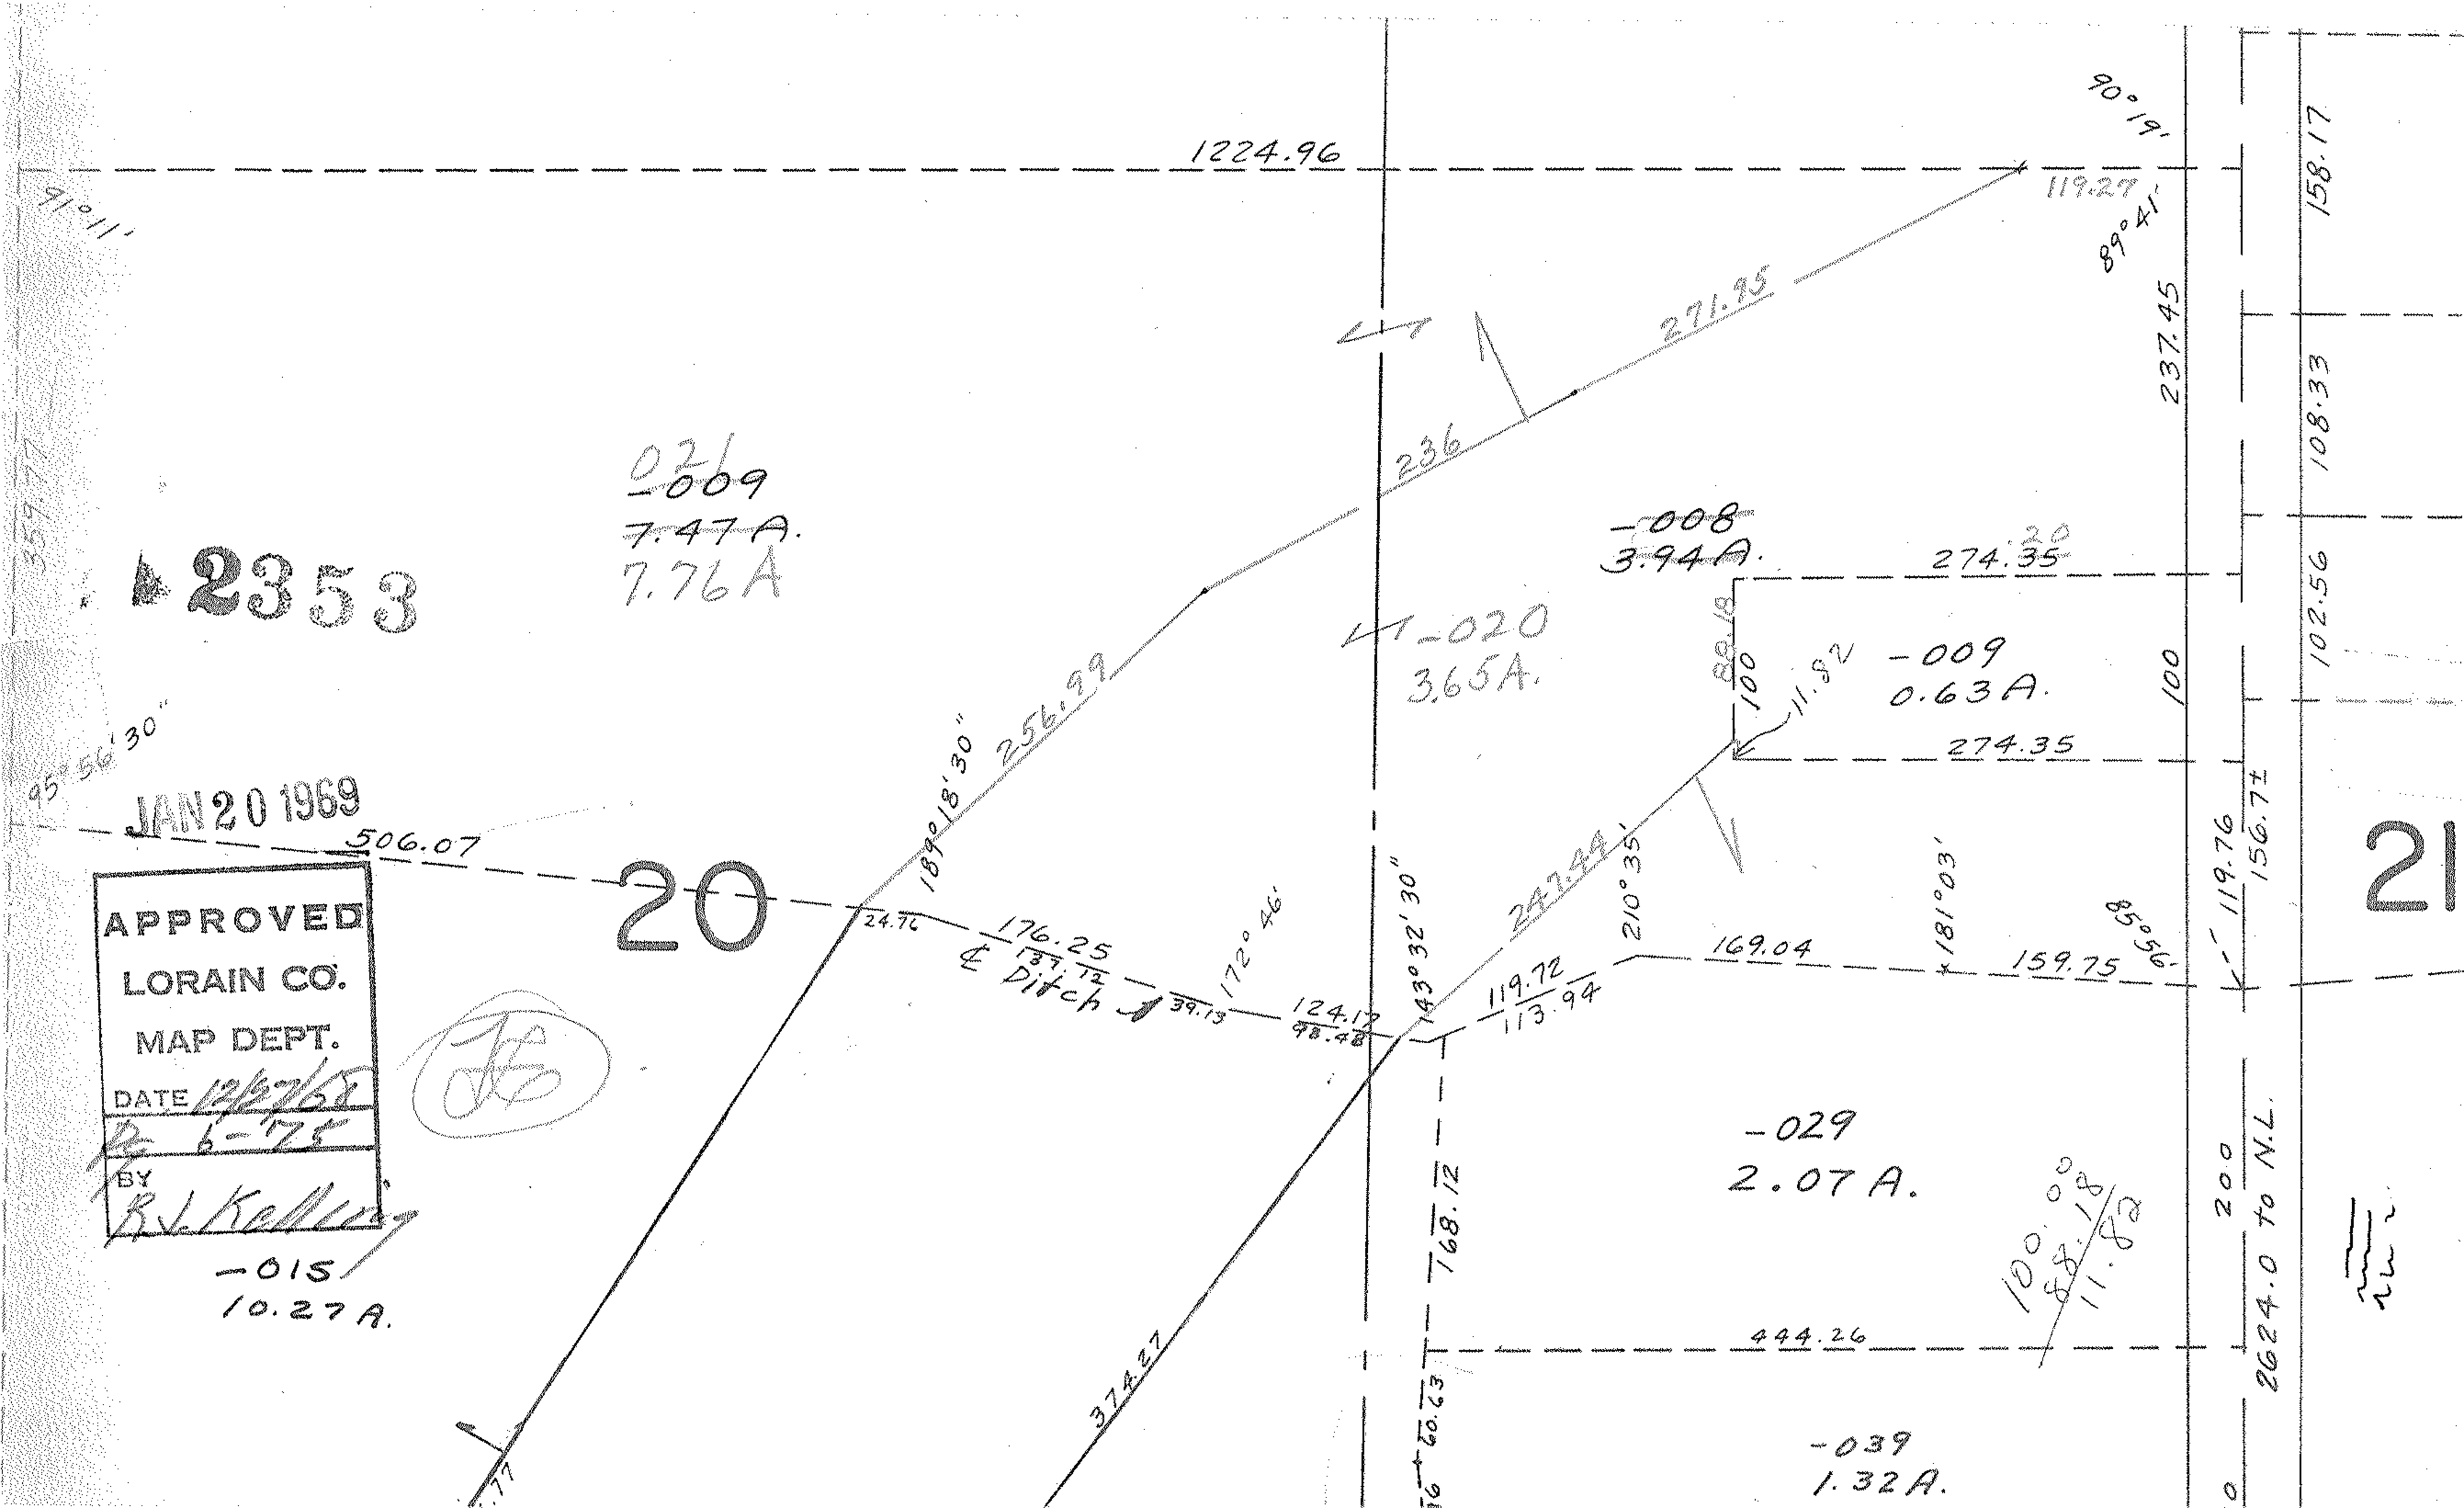

1224.96
90°19'
119.27
89°41'
158.17
91°11'
271.95
237.45
108.33
236
021
-009
7.47 A.
7.76 A
2353
-008
3.94 A.
274.35
102.56
-020
3.65 A.
88.18
100
11.82
-009
0.63 A.
100
274.35
95°56'30"
256.99
189°18'30"
JAN 20 1969
506.07
20
24.76
176.25
137.12
℄ Ditch
172°46'
39.13
124.17
98.48
143°32'30"
247.44
210°35'
119.72
113.94
169.04
181°03'
159.75
85°56'
119.76
156.7±
21
APPROVED
LORAIN CO.
MAP DEPT.
DATE 12/27/68
6-75
BY
R.J. Kelling
-015
10.27 A.
-029
2.07 A.
168.12
100.00
88.18
11.82
200
2624.0 to N.L.
444.26
374.27
60.63
-039
1.32 A.