


SEE

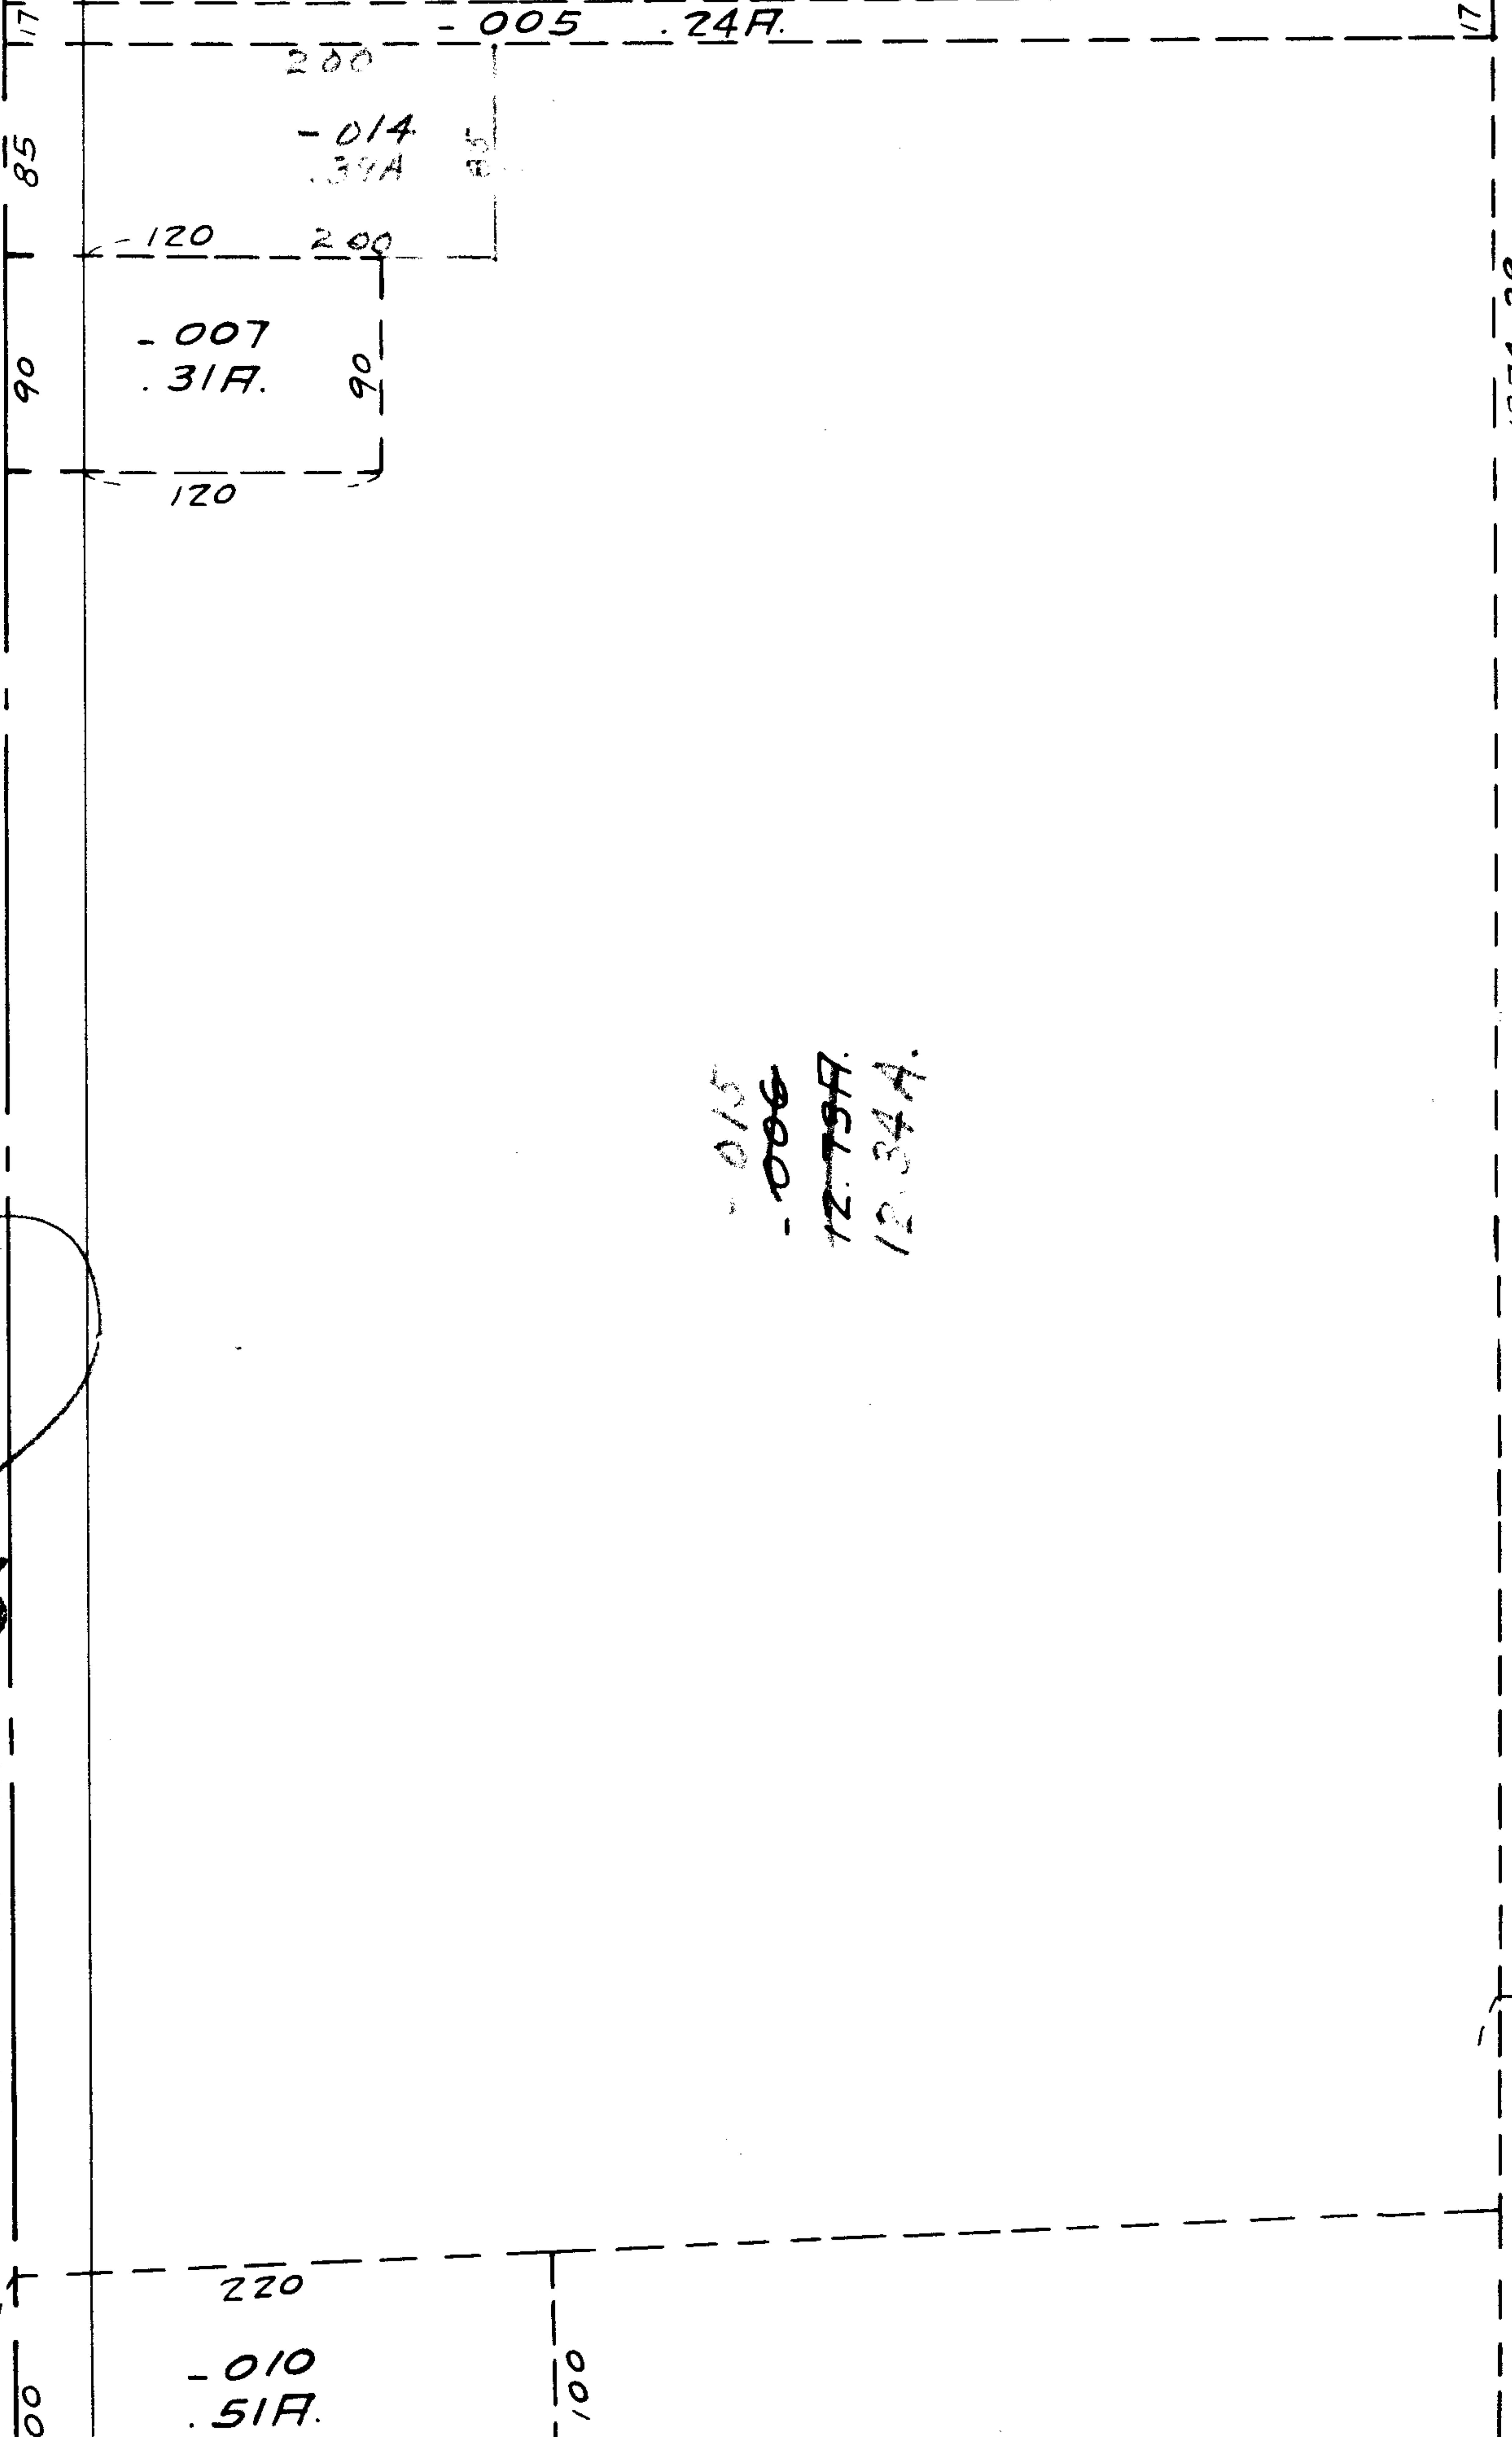

-015
 -006
 12.79F.
 12.34A.

[Handwritten signature]

2375

JAN 20 1969

APPROVED

LORAIN CO.

MAP DEPT.

DATE *1/7/69*

By *6-143*

BY *R.J. Kelling*

300.14