


544.50
164.42
380.08
524.98
113.80
167.09
380.41

2383

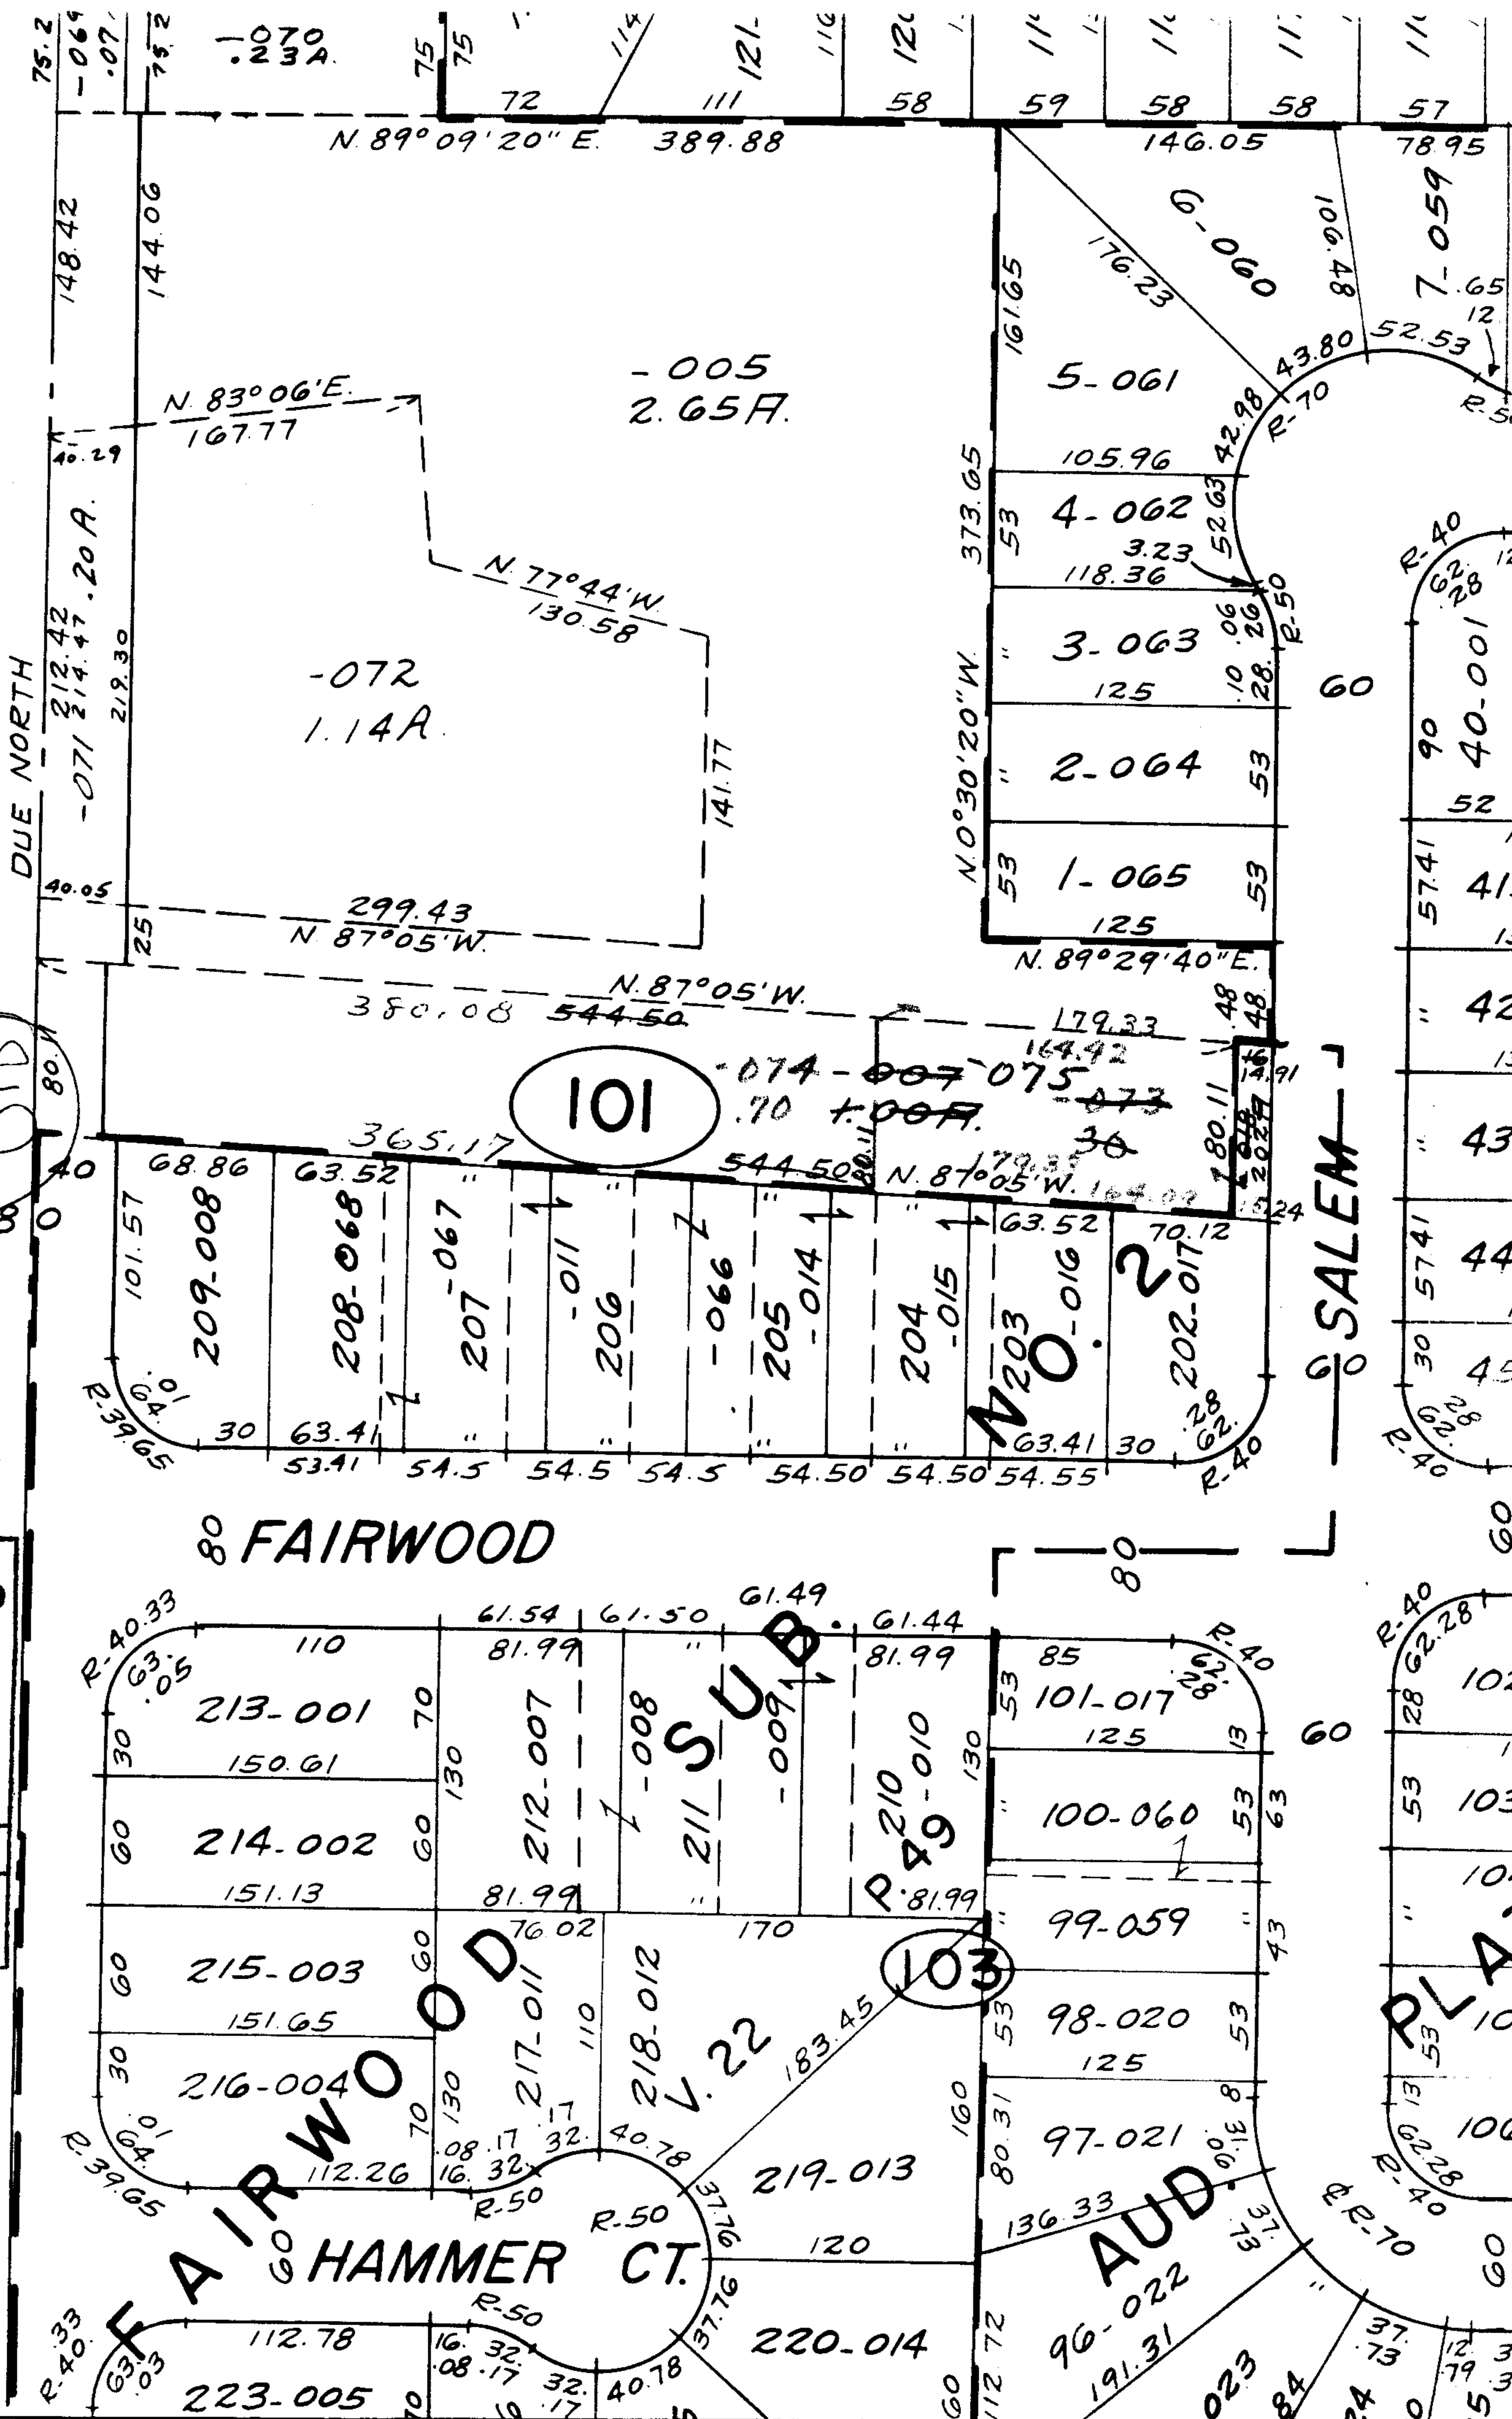

JAN 13 1969

APPROVED
LORAIN CO.
MAP DEPT.
DATE 1/13/69
BY R. W. Kelling

MAR 4 1969

SEE 6-523

AUD.