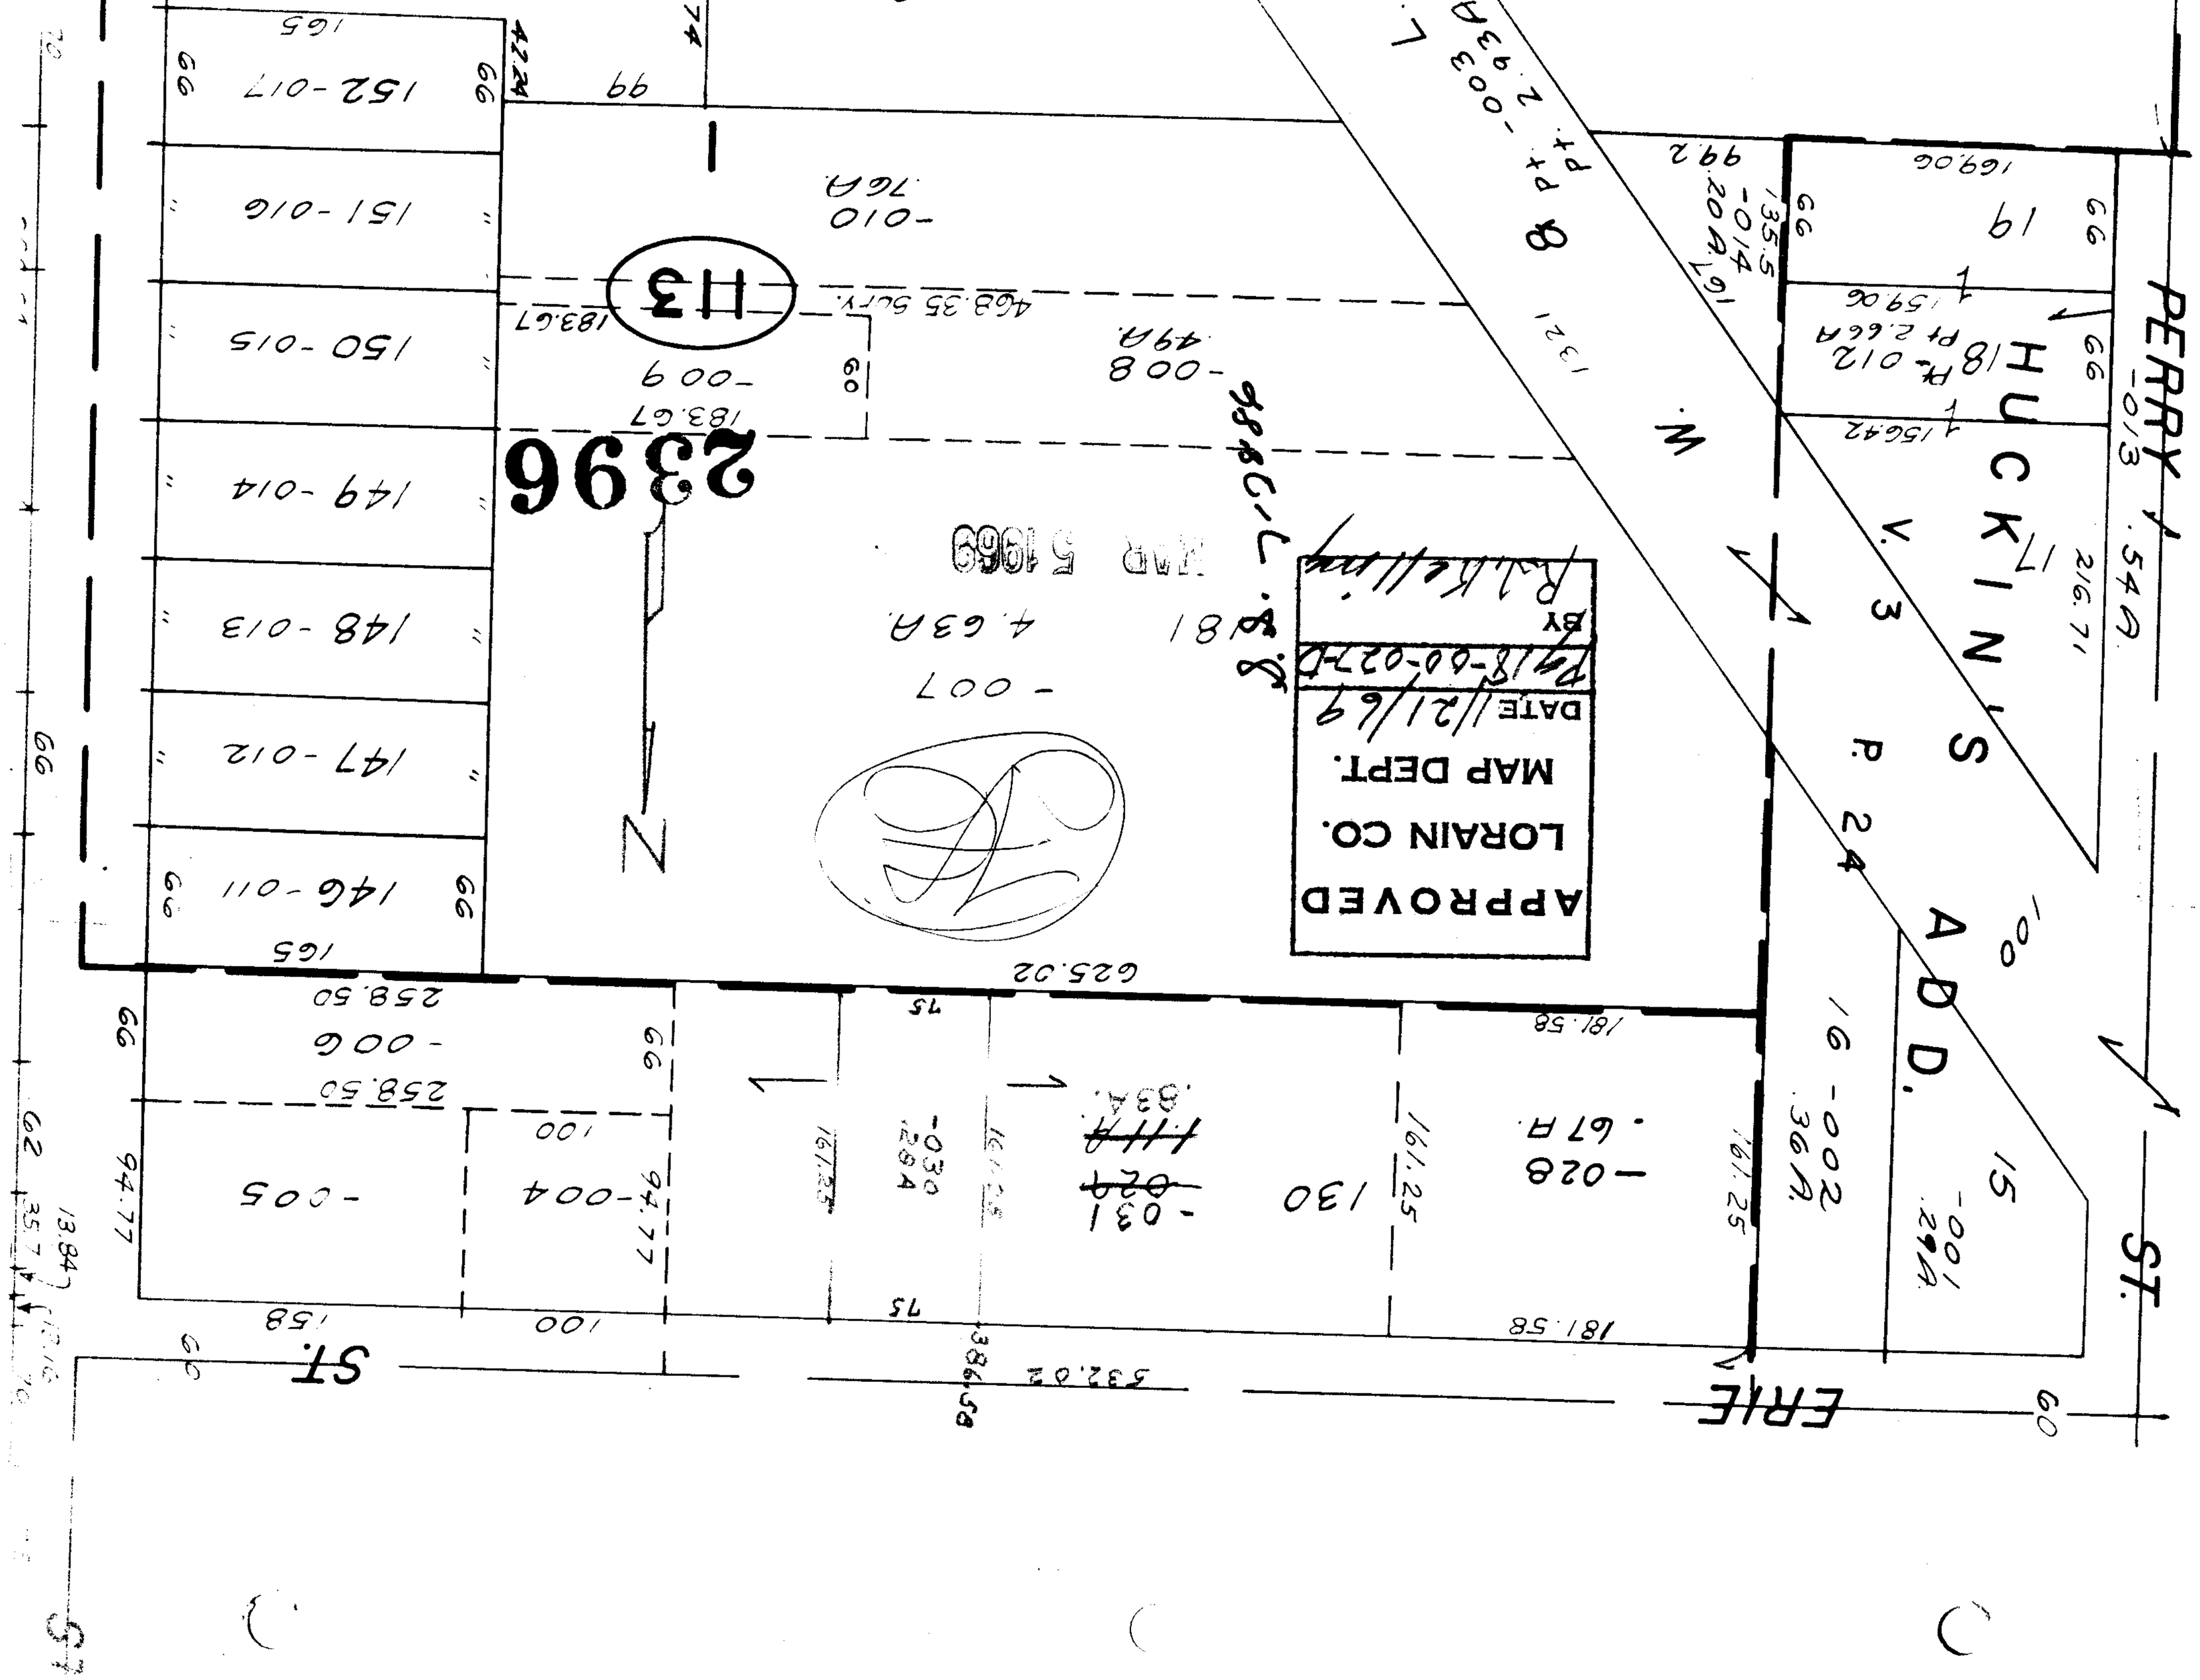

PERRY ST.
HUCKINS ADD.
V. 3 P. 24
ERIE ST.
2396
113
APPROVED
LORAIN CO.
MAP DEPT.
DATE 1/21/69
BY
MAR 5 1969