


63.49
190.47

2403

APPROVED
LORAIN CO.
MAP DEPT.
DATE 1-23-69
3-00-108-B
BY *Holler*

MAR 1 1969
SEE 3-00-108-A
7-14-88
S.S.

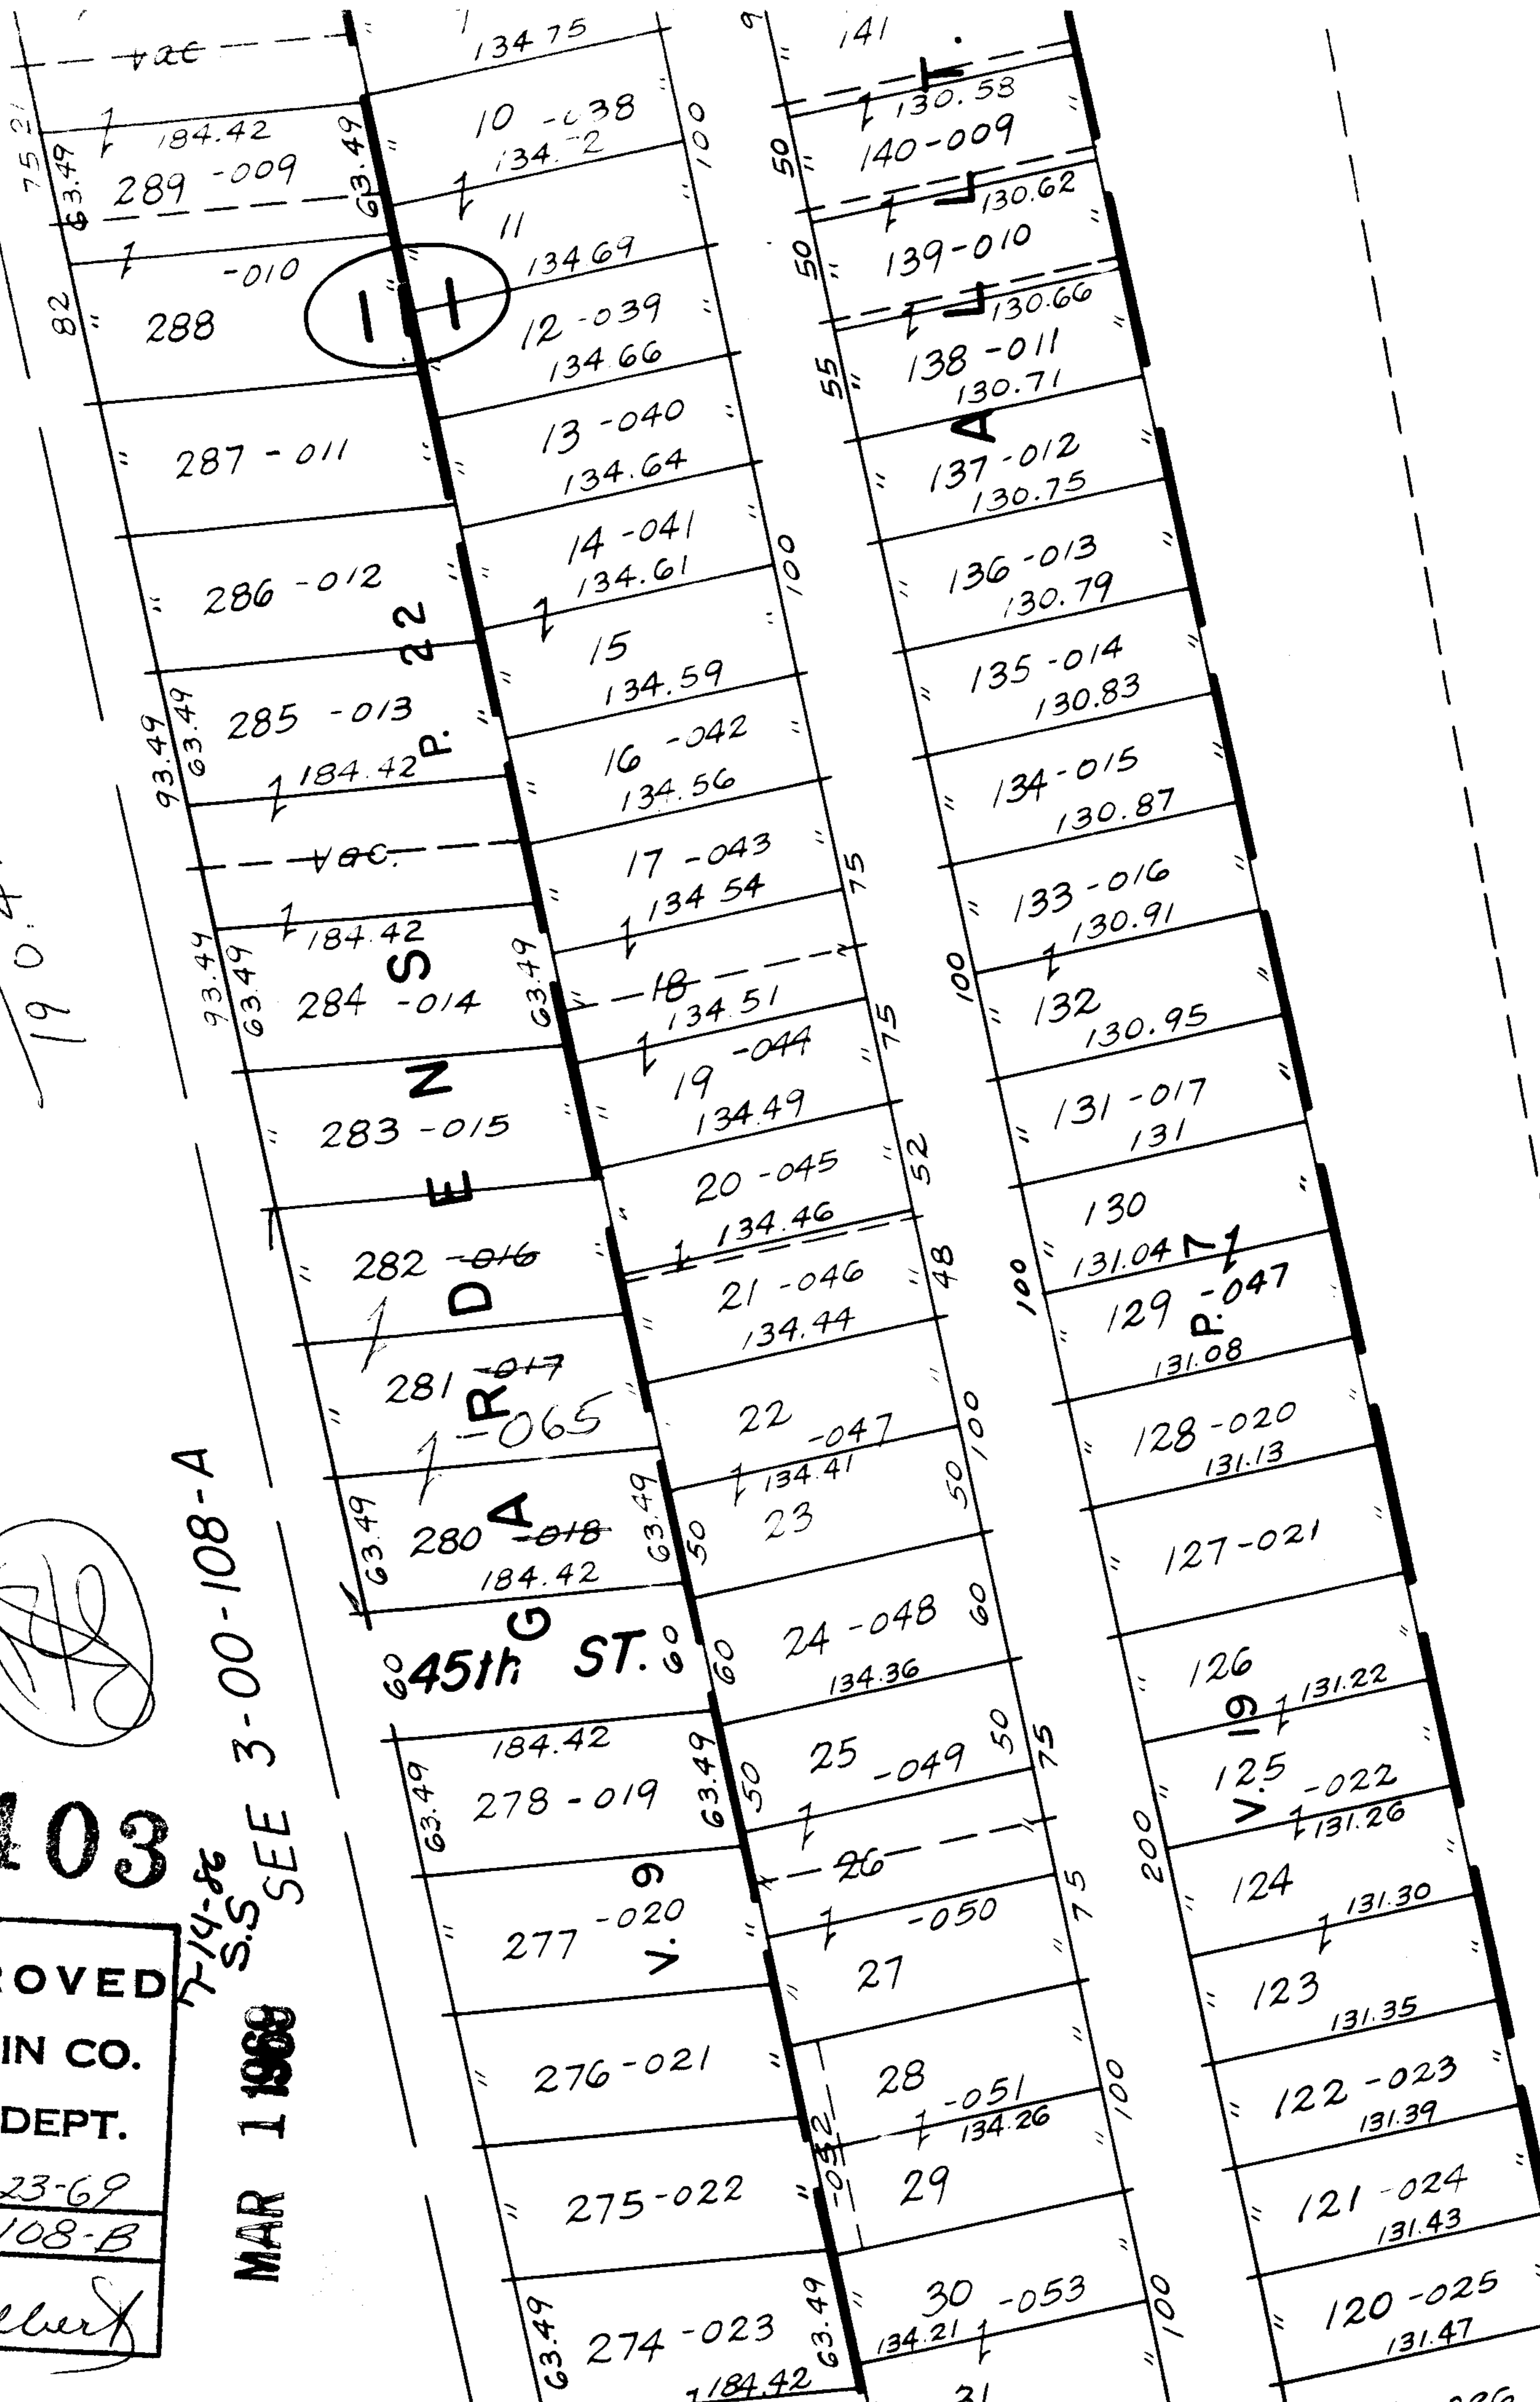

040