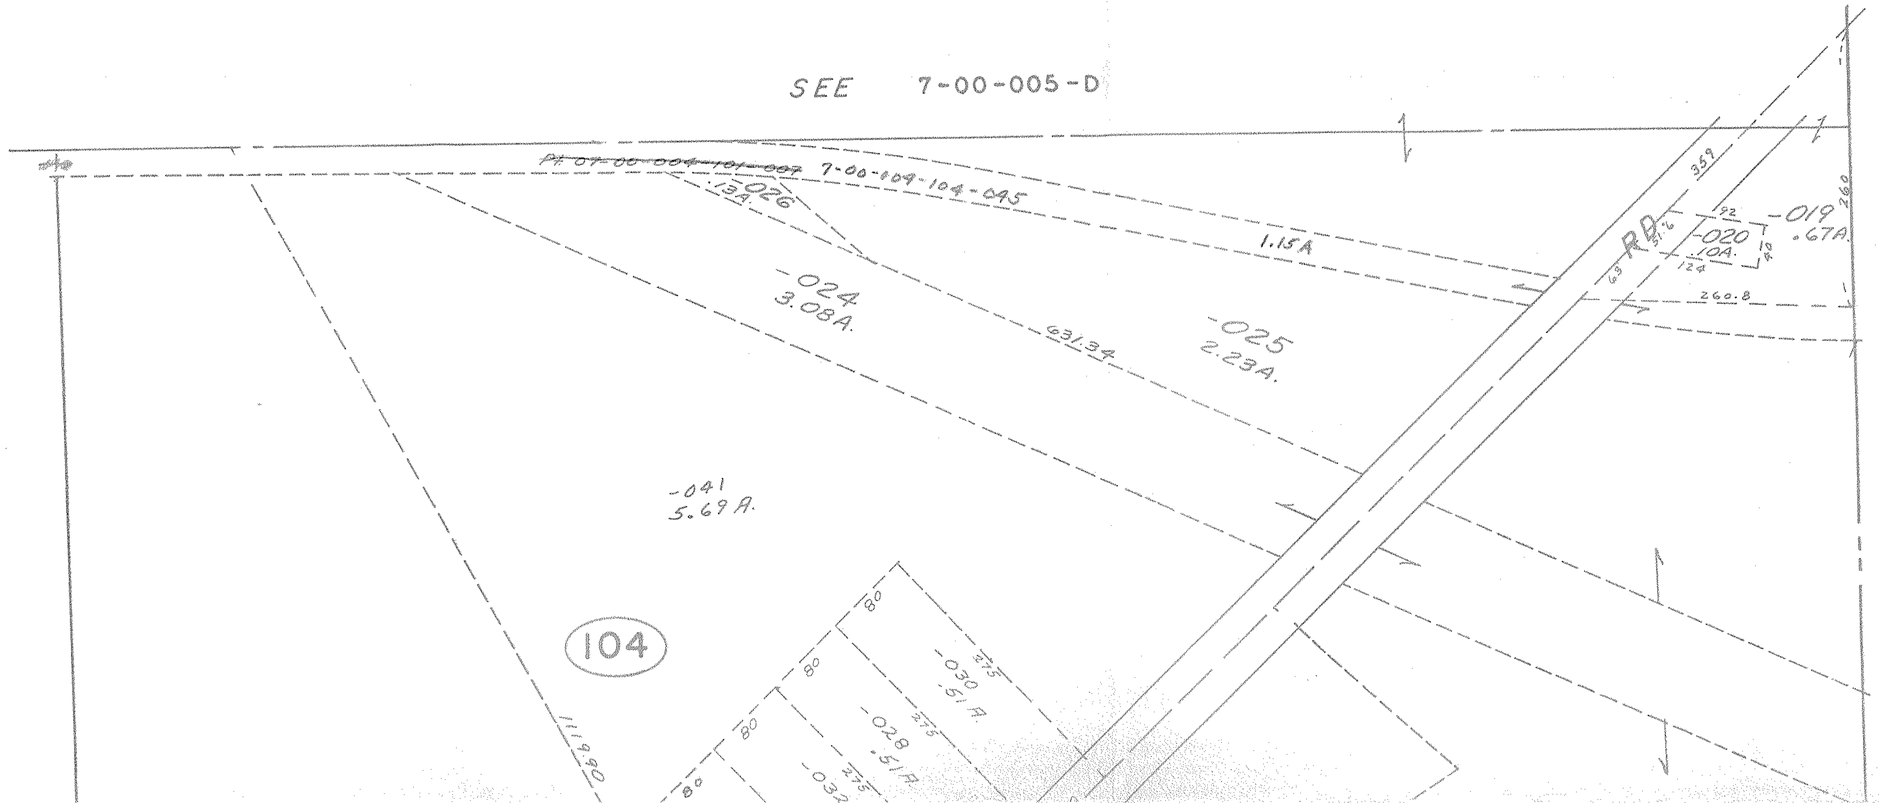

7-00-004 B

2404

MAR 26 1969

2405
APPROVED
LORAIN CO.
MAP DEPT.
DATE 1-25-69
BY L W Hall