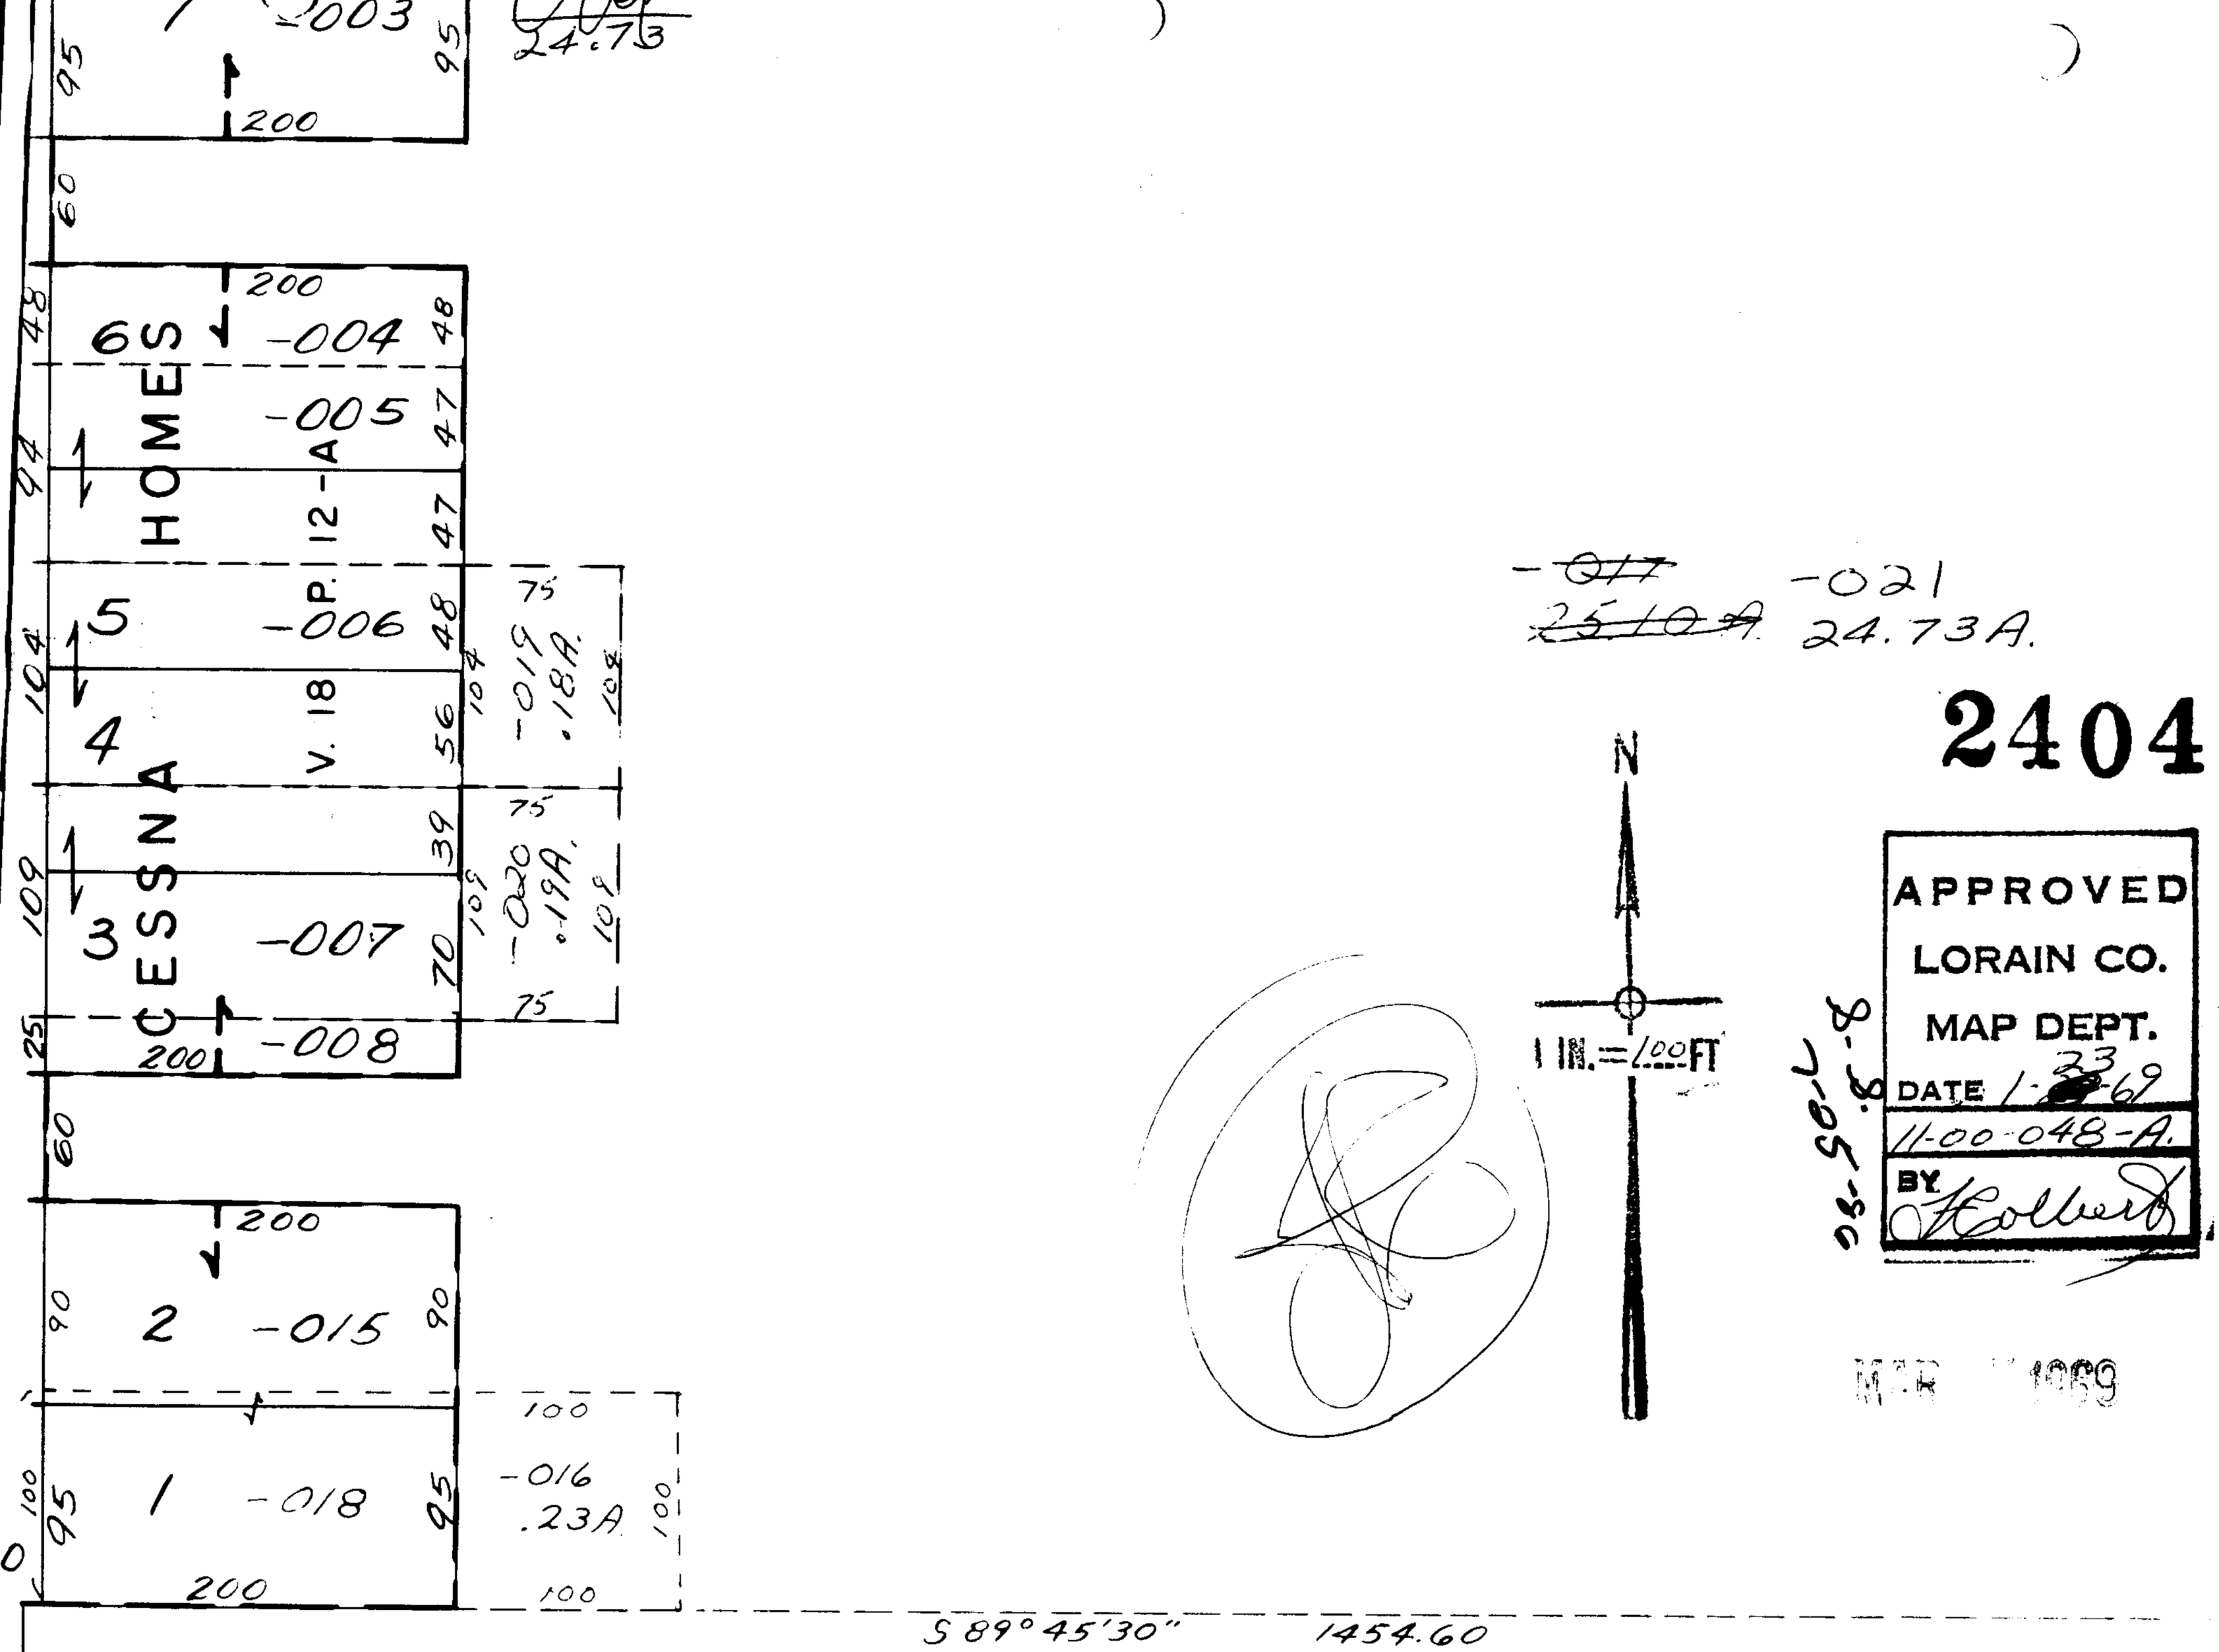
-003
24.73
95
95
200
60
200
6
-004
48
48
-005
47
47
94
94
HOMES
P. 12-A
5
-006
48
48
104
104
-019
.18A.
75
V. 18
4
56
39
109
109
-020
.19A.
75
3
-007
70
75
25
200
-008
60
200
2
-015
90
90
100
-016
.23A
100
1
-018
95
95
100
200
100
S 89° 45' 30"
1454.60
-017
25.10A.
-021
24.73A.
2404
N
1 IN. = 100 FT
APPROVED
LORAIN CO.
MAP DEPT.
DATE 1-23-69
11-00-048-A.
BY
MAR 1969