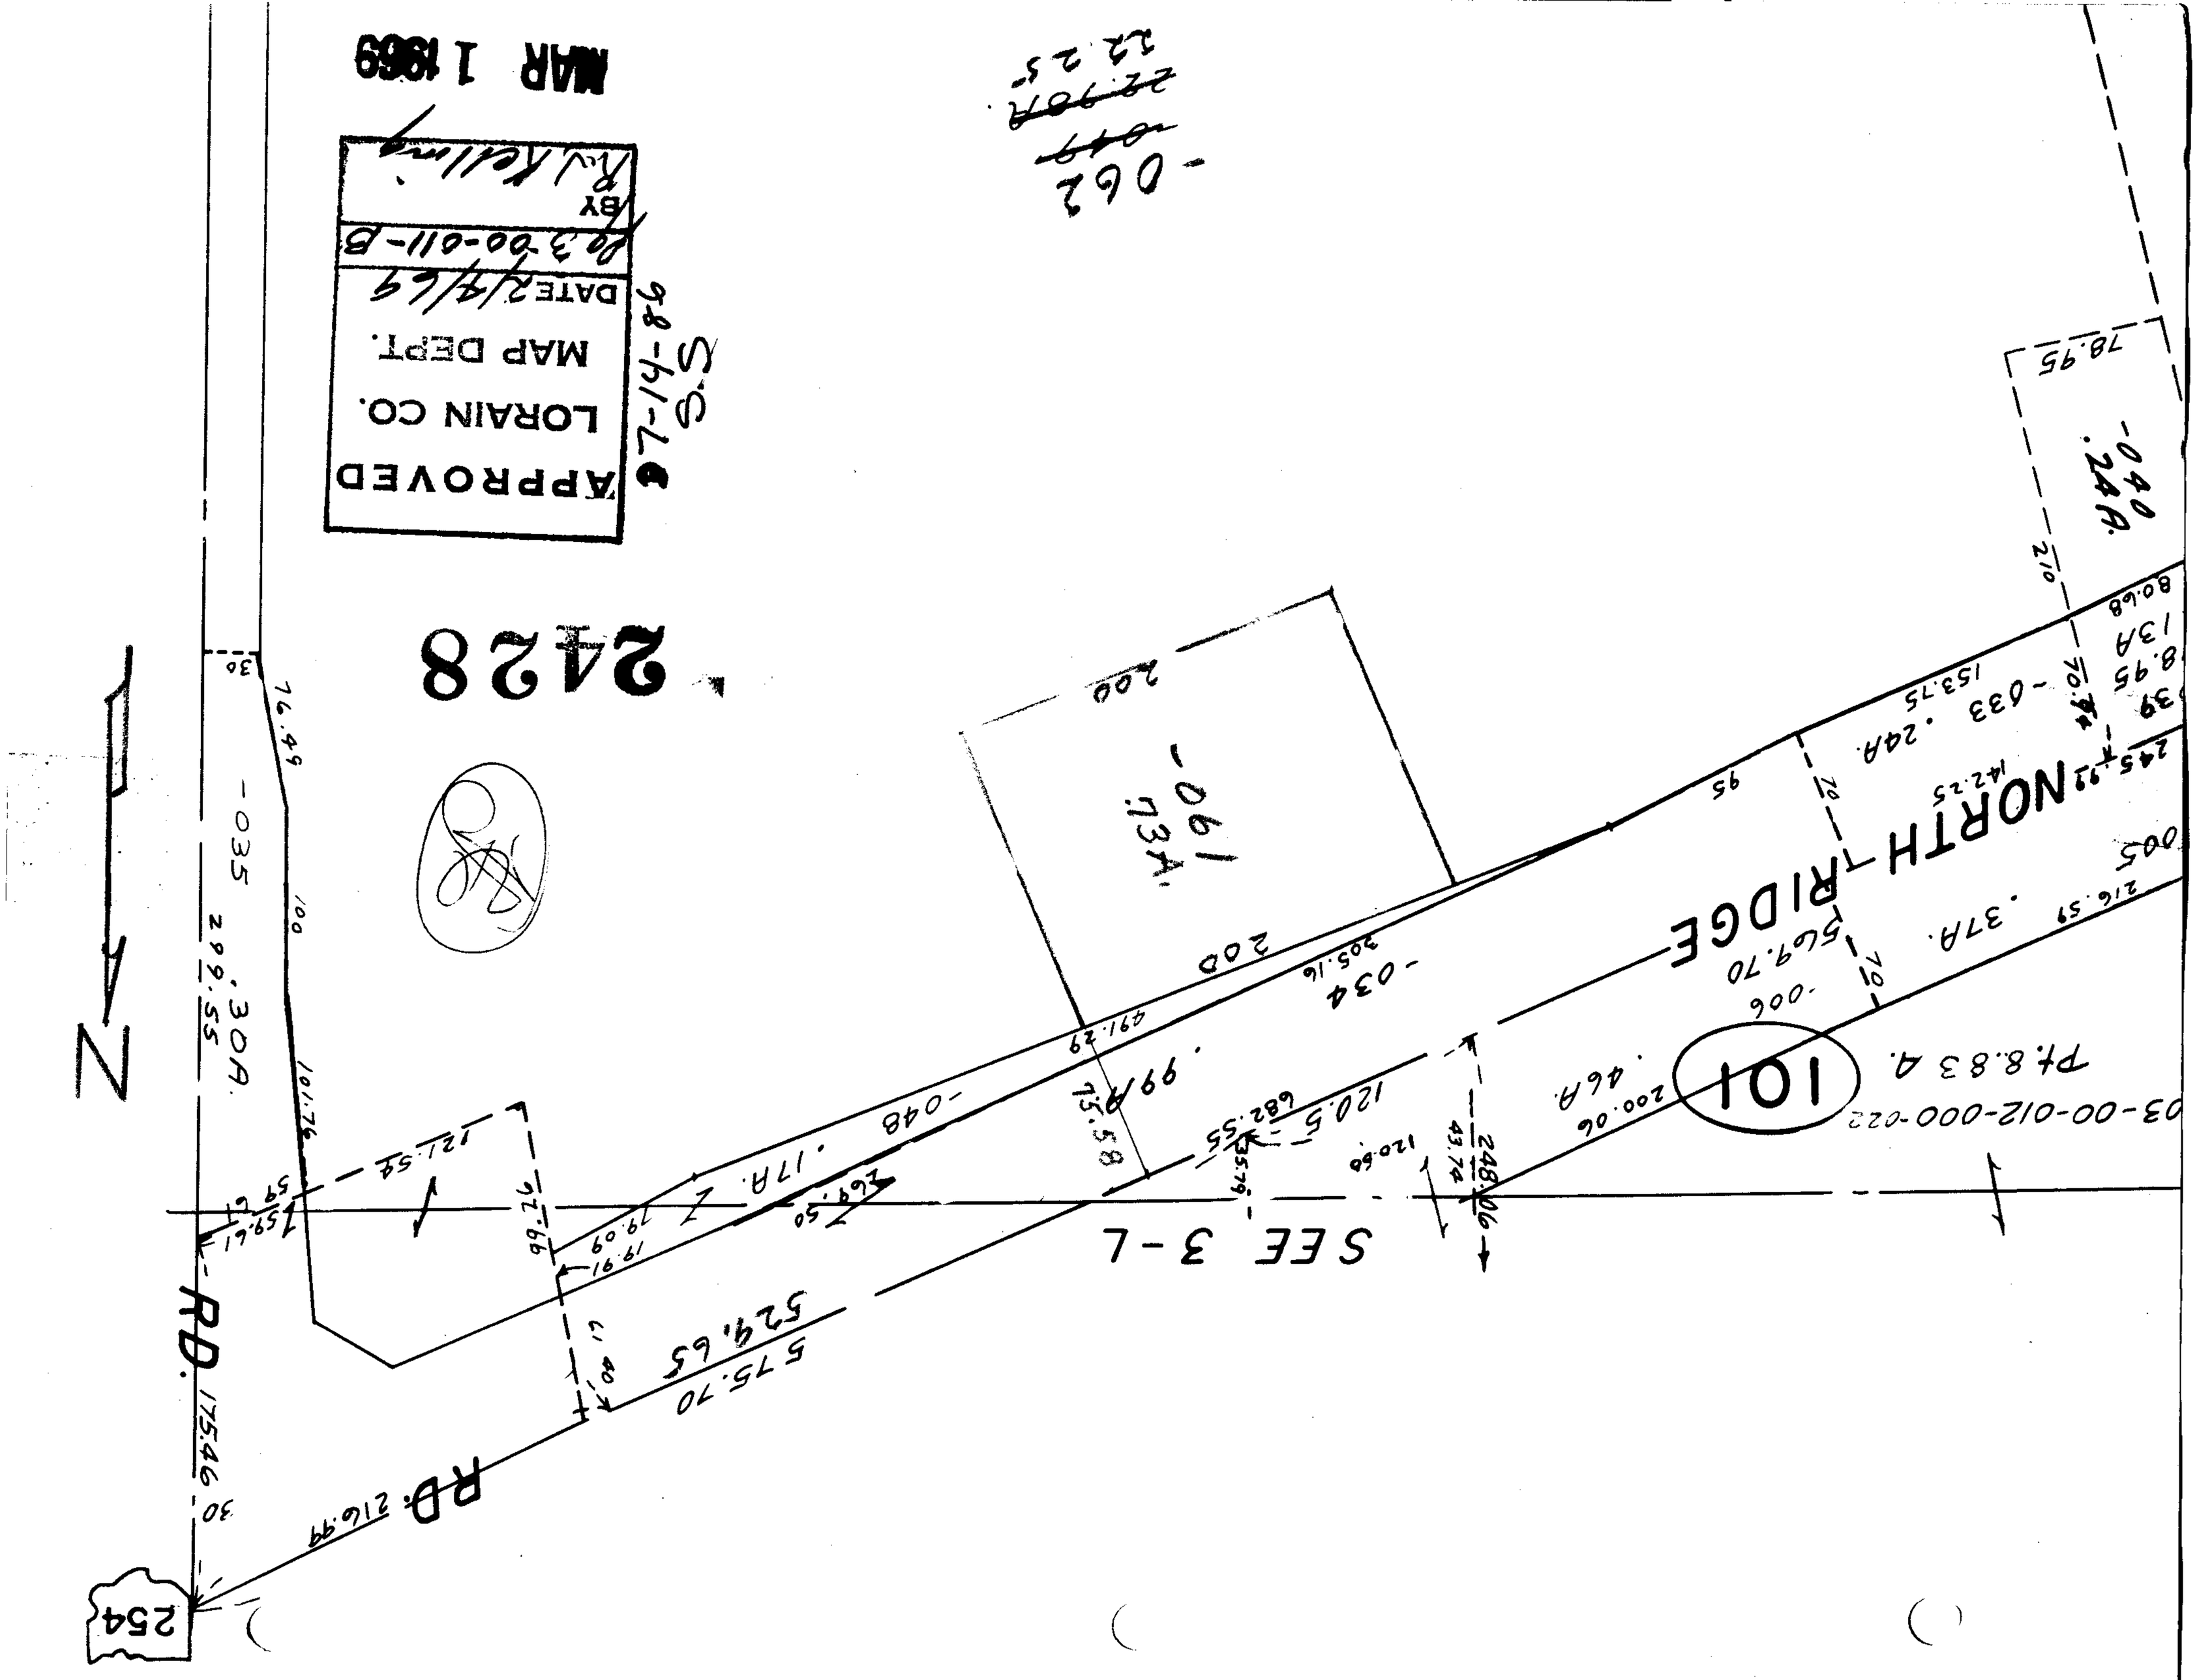

MAR 1 1969
APPROVED
LORAIN CO.
MAP DEPT.
DATE 2/4/69
BY
2428
NORTH RIDGE
101
SEE 3-L
RD.
254
N