

- 004
44.54 A.

120.04
560.60
- 003 1.53 A.
552.66

165.33
252.50
253.50
671.33

12

- 001
89.00 A.

114.57
252.60
253.60
620.77

Handwritten signature or scribble

2429

APPROVED
LORAIN CO.
MAP DEPT.
DATE 2/5/69
13-D
BY
R. J. Kelling


BAUMHART

- 003
122.77 A.

7-28-86 h.k.

29

MAR 5 1969

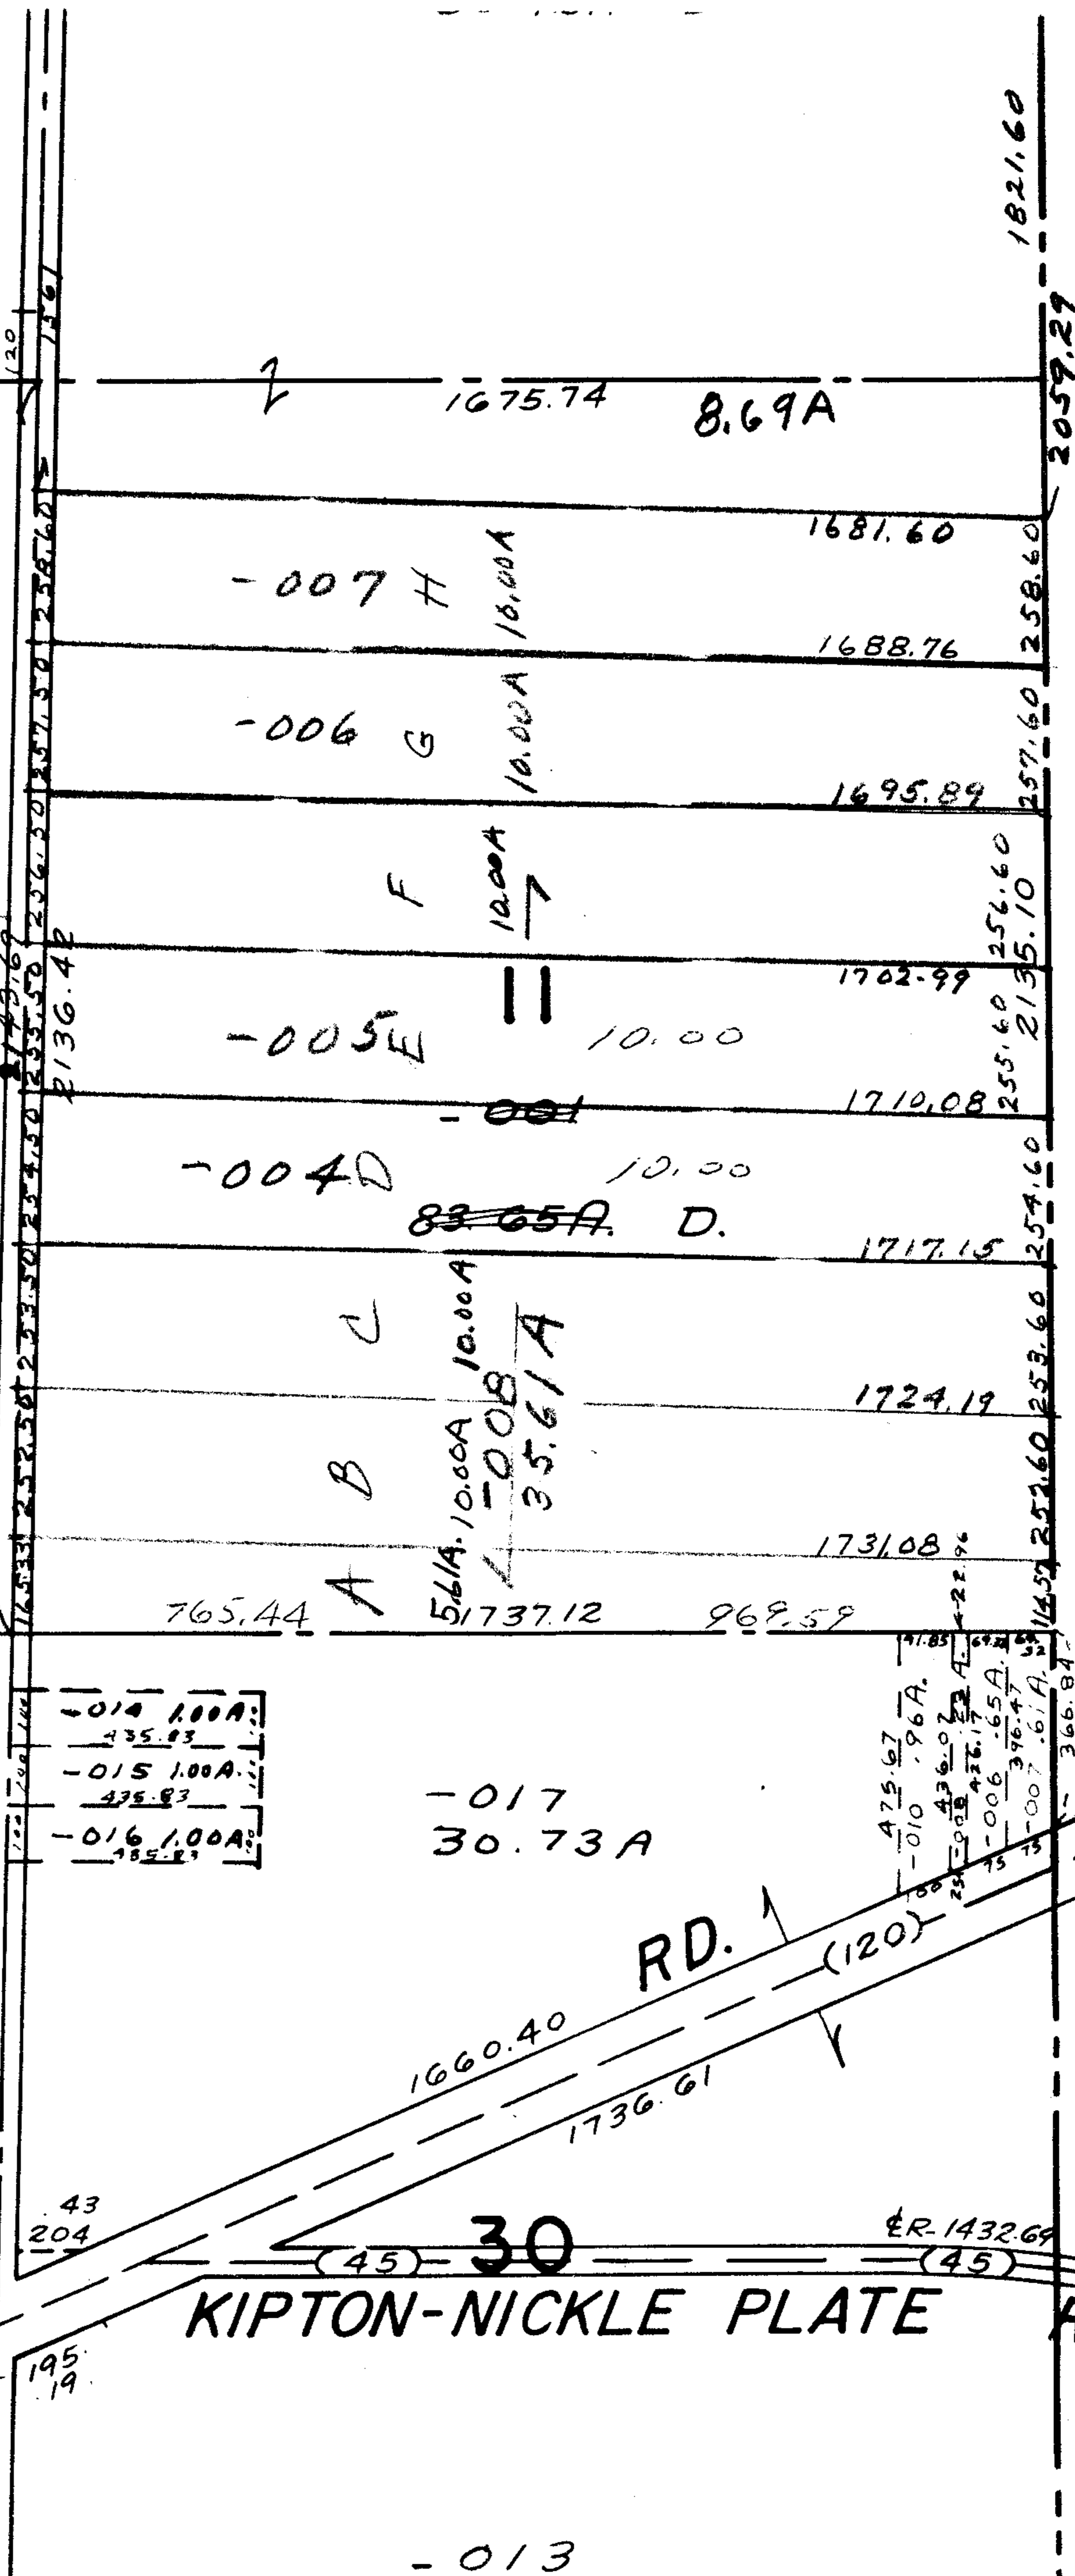

20

D
To

- 013