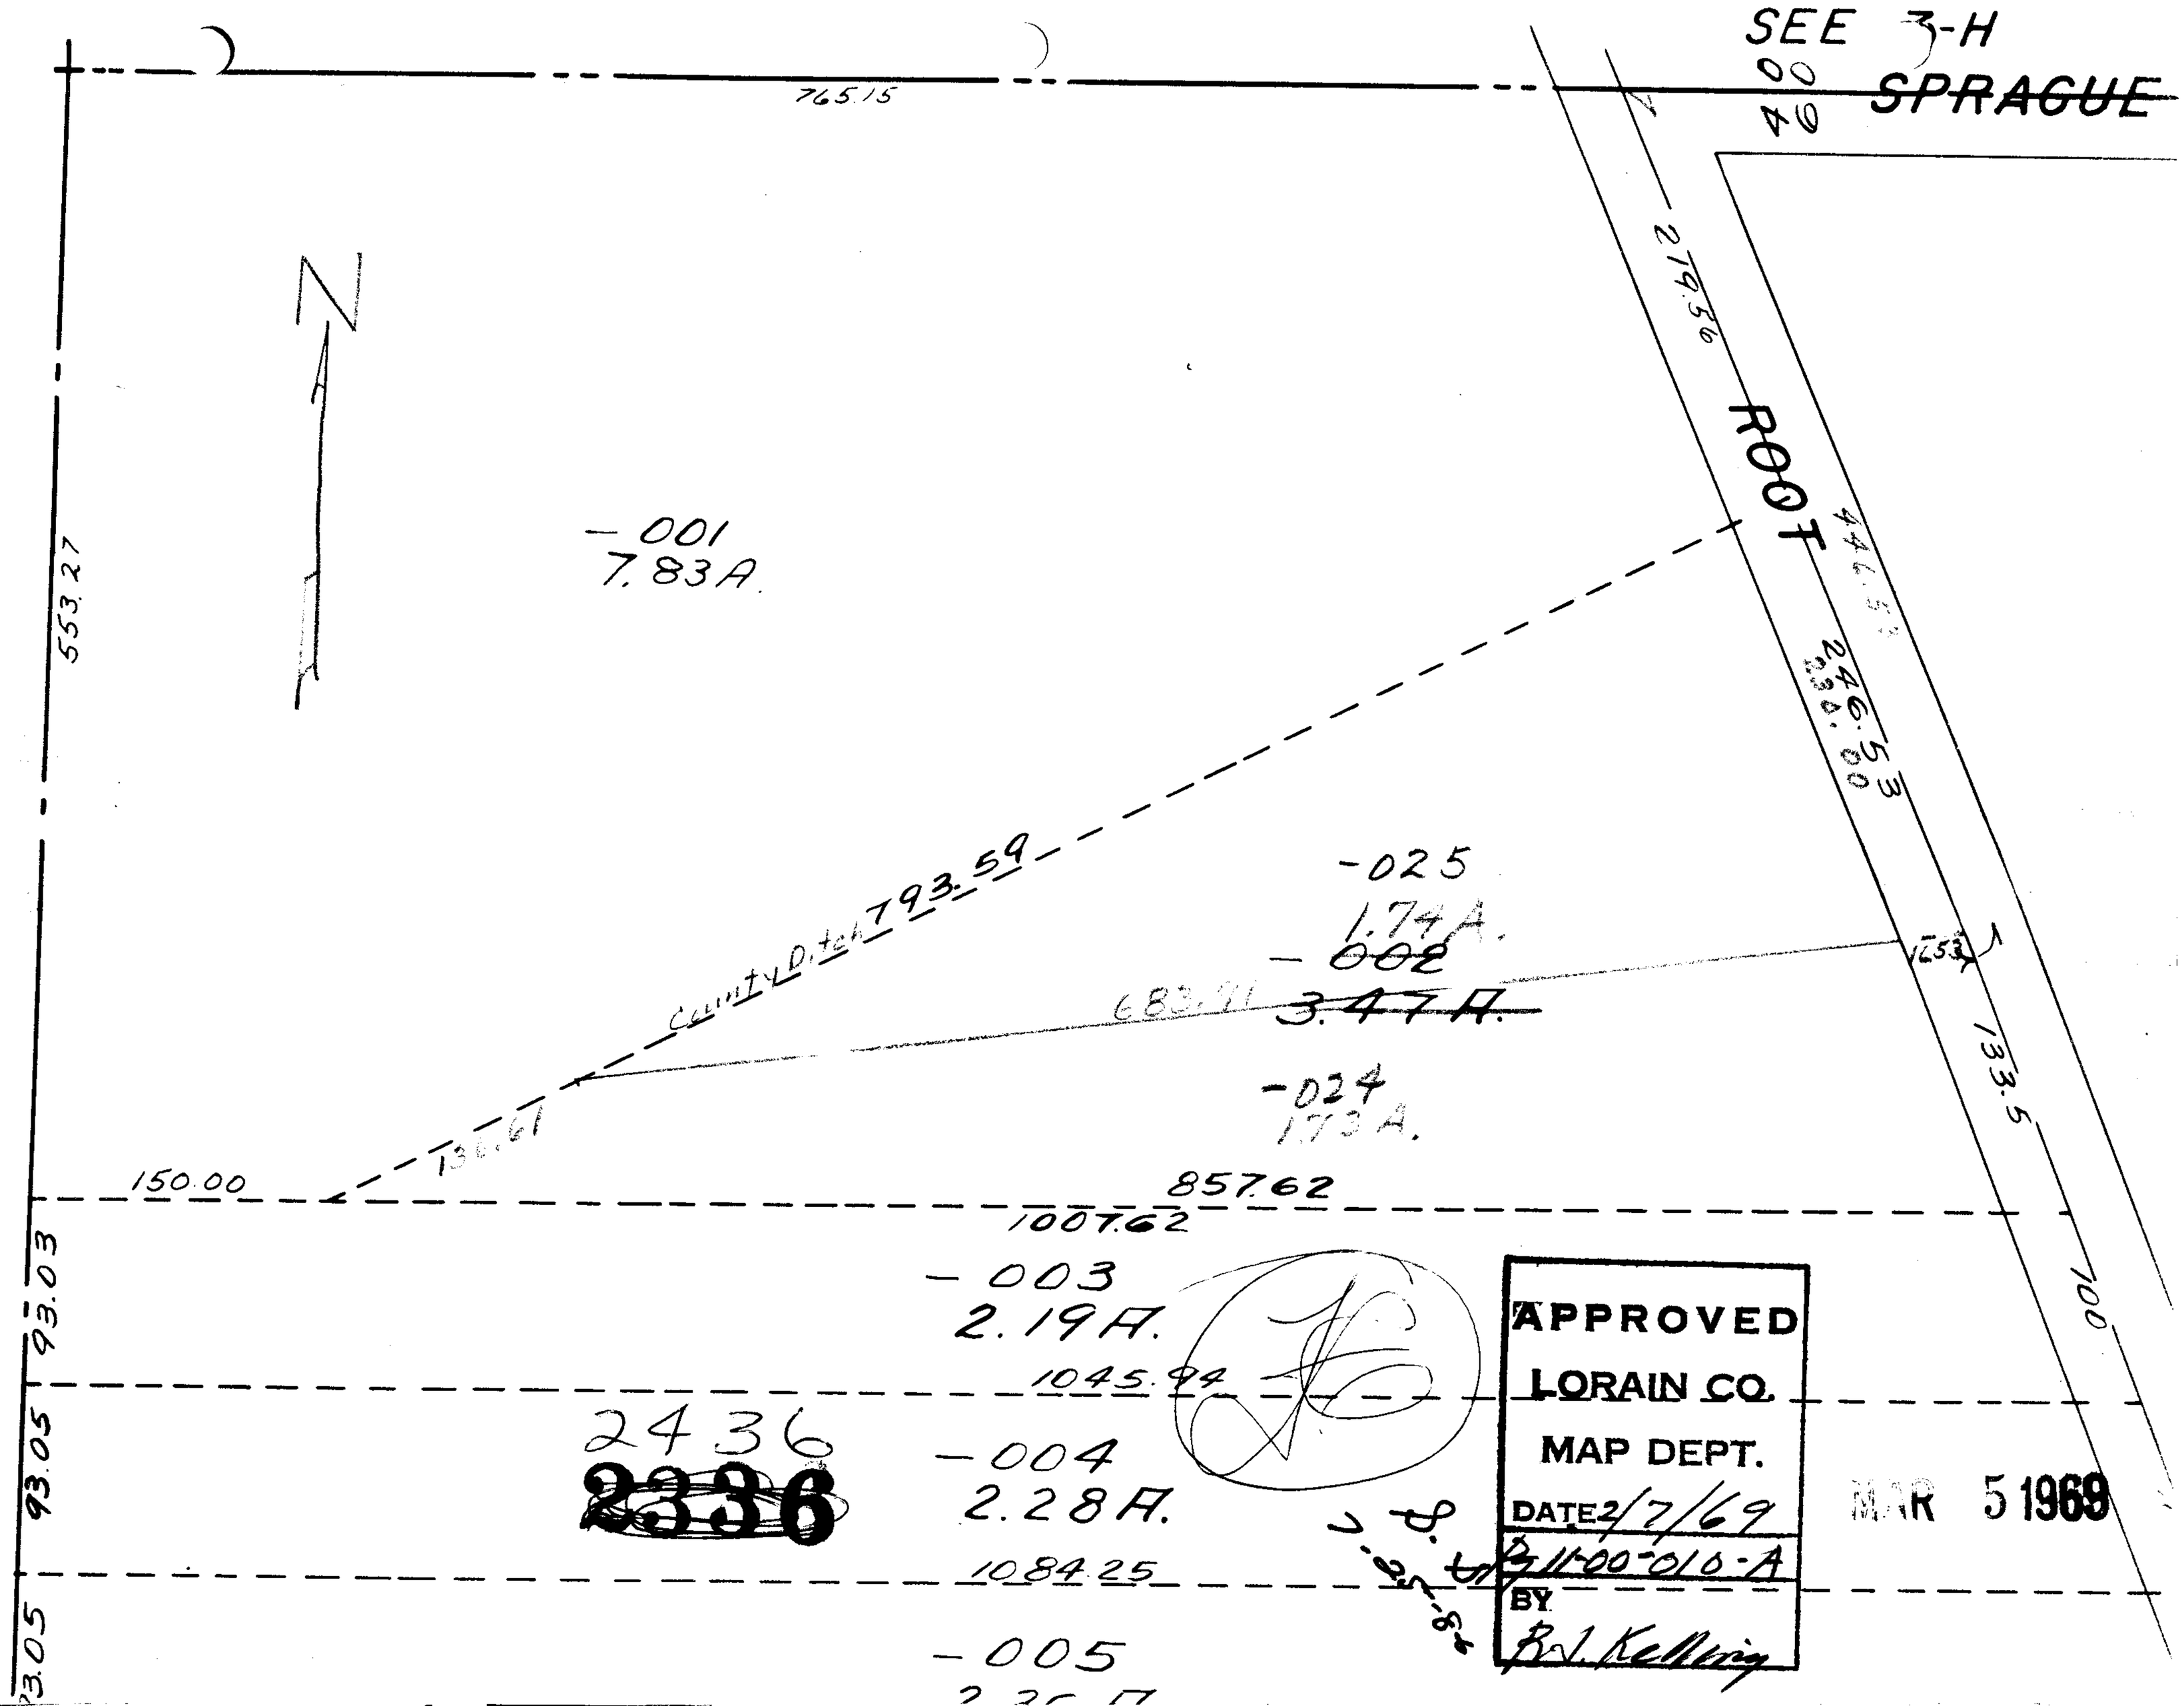
SEE 3-H
SPRAGUE
765.15
ROOT
219.56
446.53
246.53
230.00
133.5
100
553.27
-001
7.83A.
County Ditch 793.59
-025
1.74A.
-002
3.47A.
683.91
-024
1.73A.
136.61
150.00
857.62
1007.62
-003
2.19A.
1045.94
93.03
93.05
2436
2336
-004
2.28A.
1084.25
-005
APPROVED
LORAIN CO.
MAP DEPT.
DATE 2/7/69
11-00-010-A
BY
MAR 5 1969