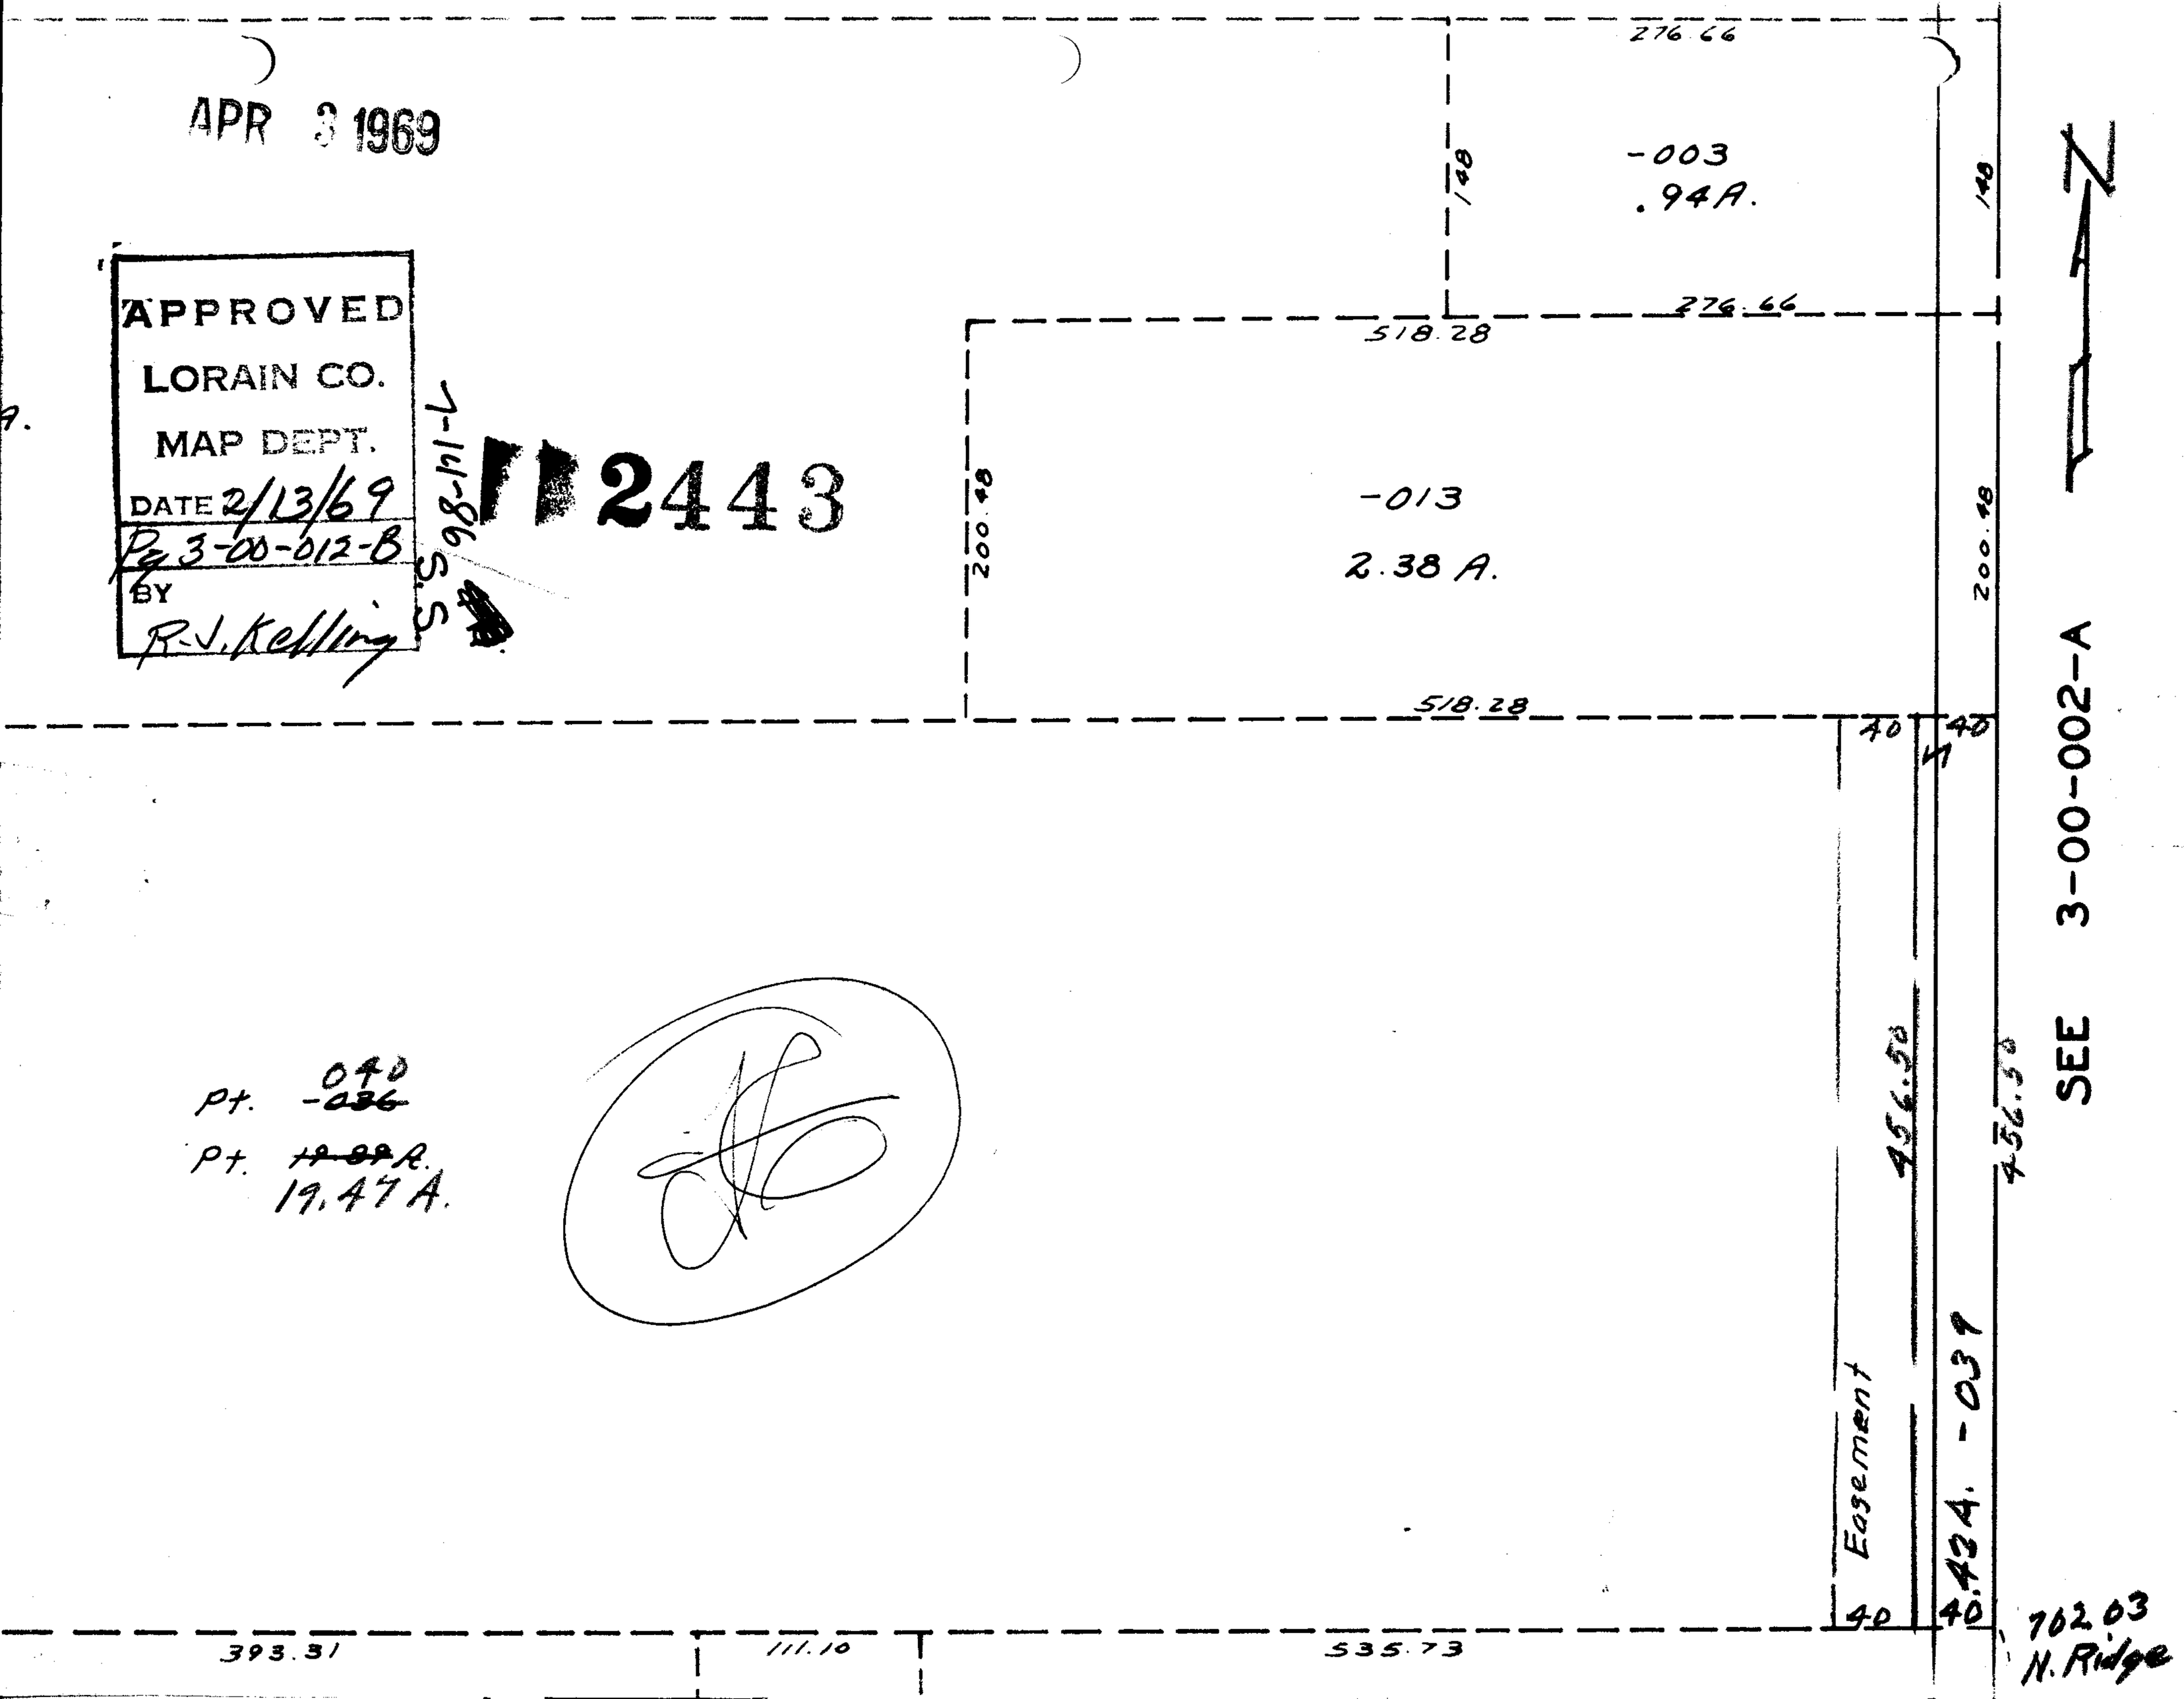
APR 3 1969
APPROVED
LORAIN CO.
MAP DEPT.
DATE 2/13/69
Pg 3-00-012-B
BY
R.J. Kelling
2443
276.66
-003
.94A.
148
518.28
-013
2.38 A.
200.48
40
456.50
Easement
.42A. -039
SEE 3-00-002-A
702.03
N. Ridge
393.31
111.10
535.73
Pt. 040
Pt. 19.47 A.