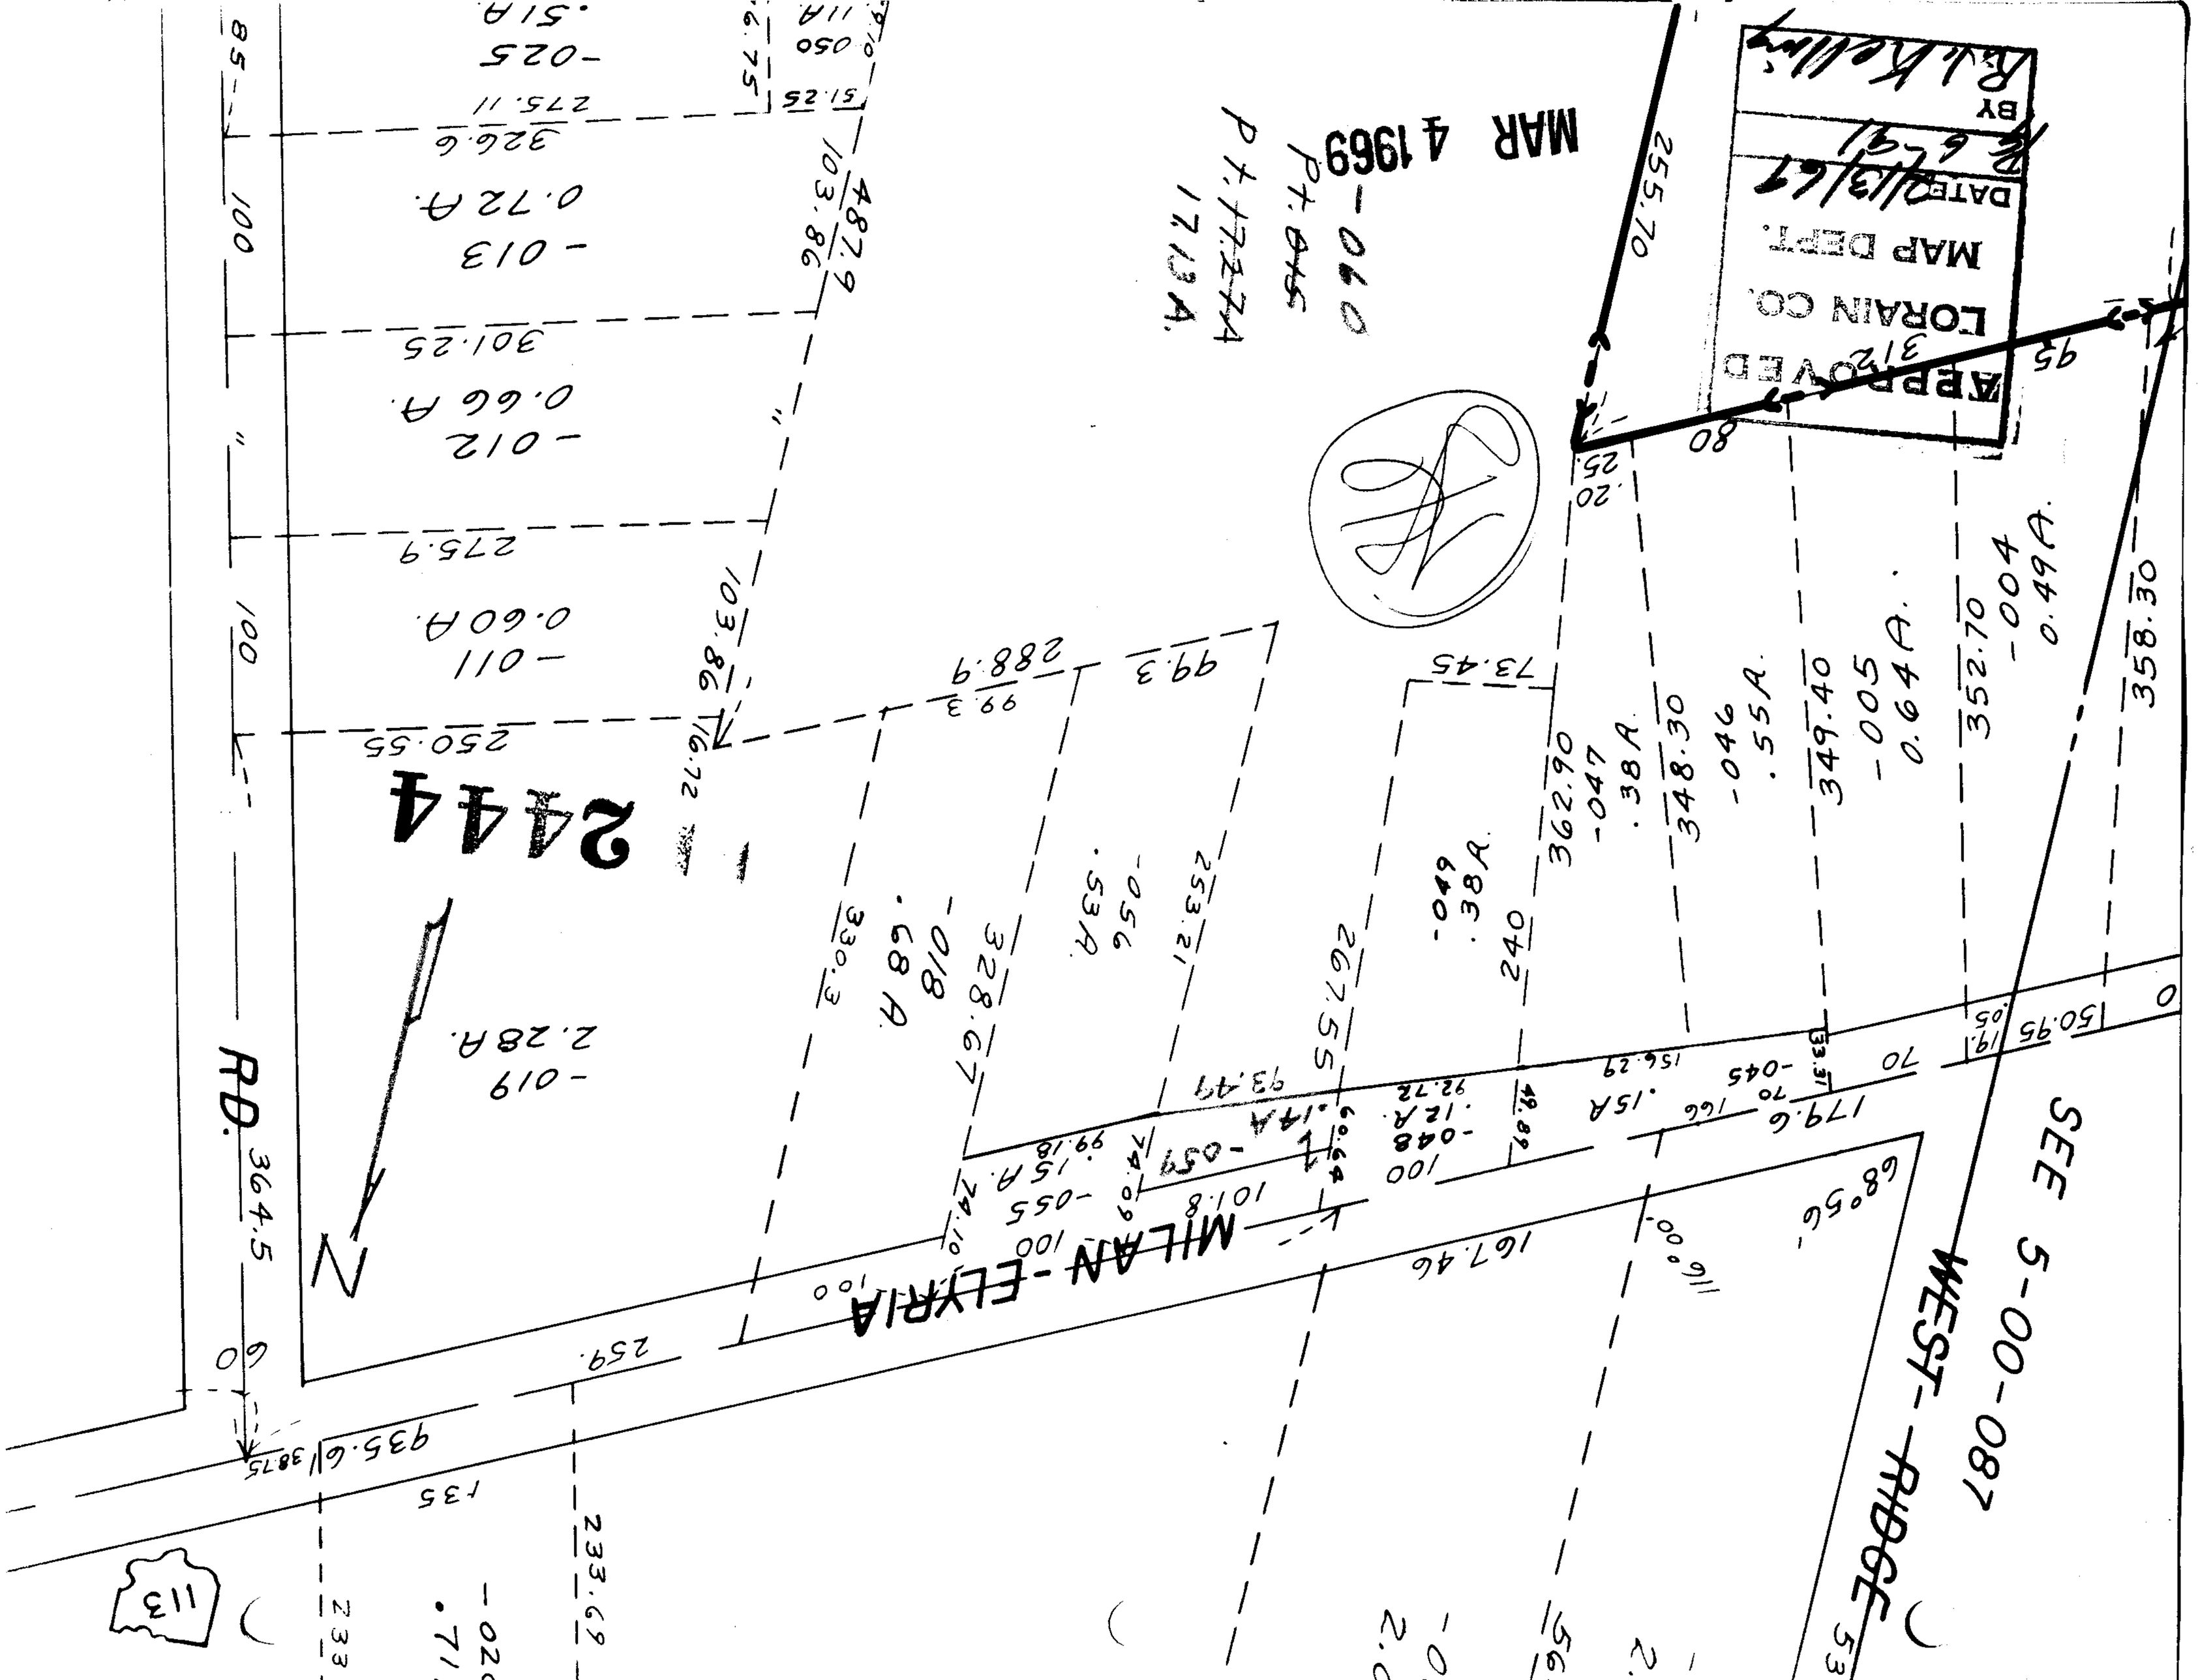

MAR 4 1969
APPROVED
LORAIN CO.
MAP DEPT.
DATE 2/13/67
BY R.J. Kelling
2444
MILAN-ELYRIA
WEST-RIDGE
SEE 5-00-087
RD.
N
113