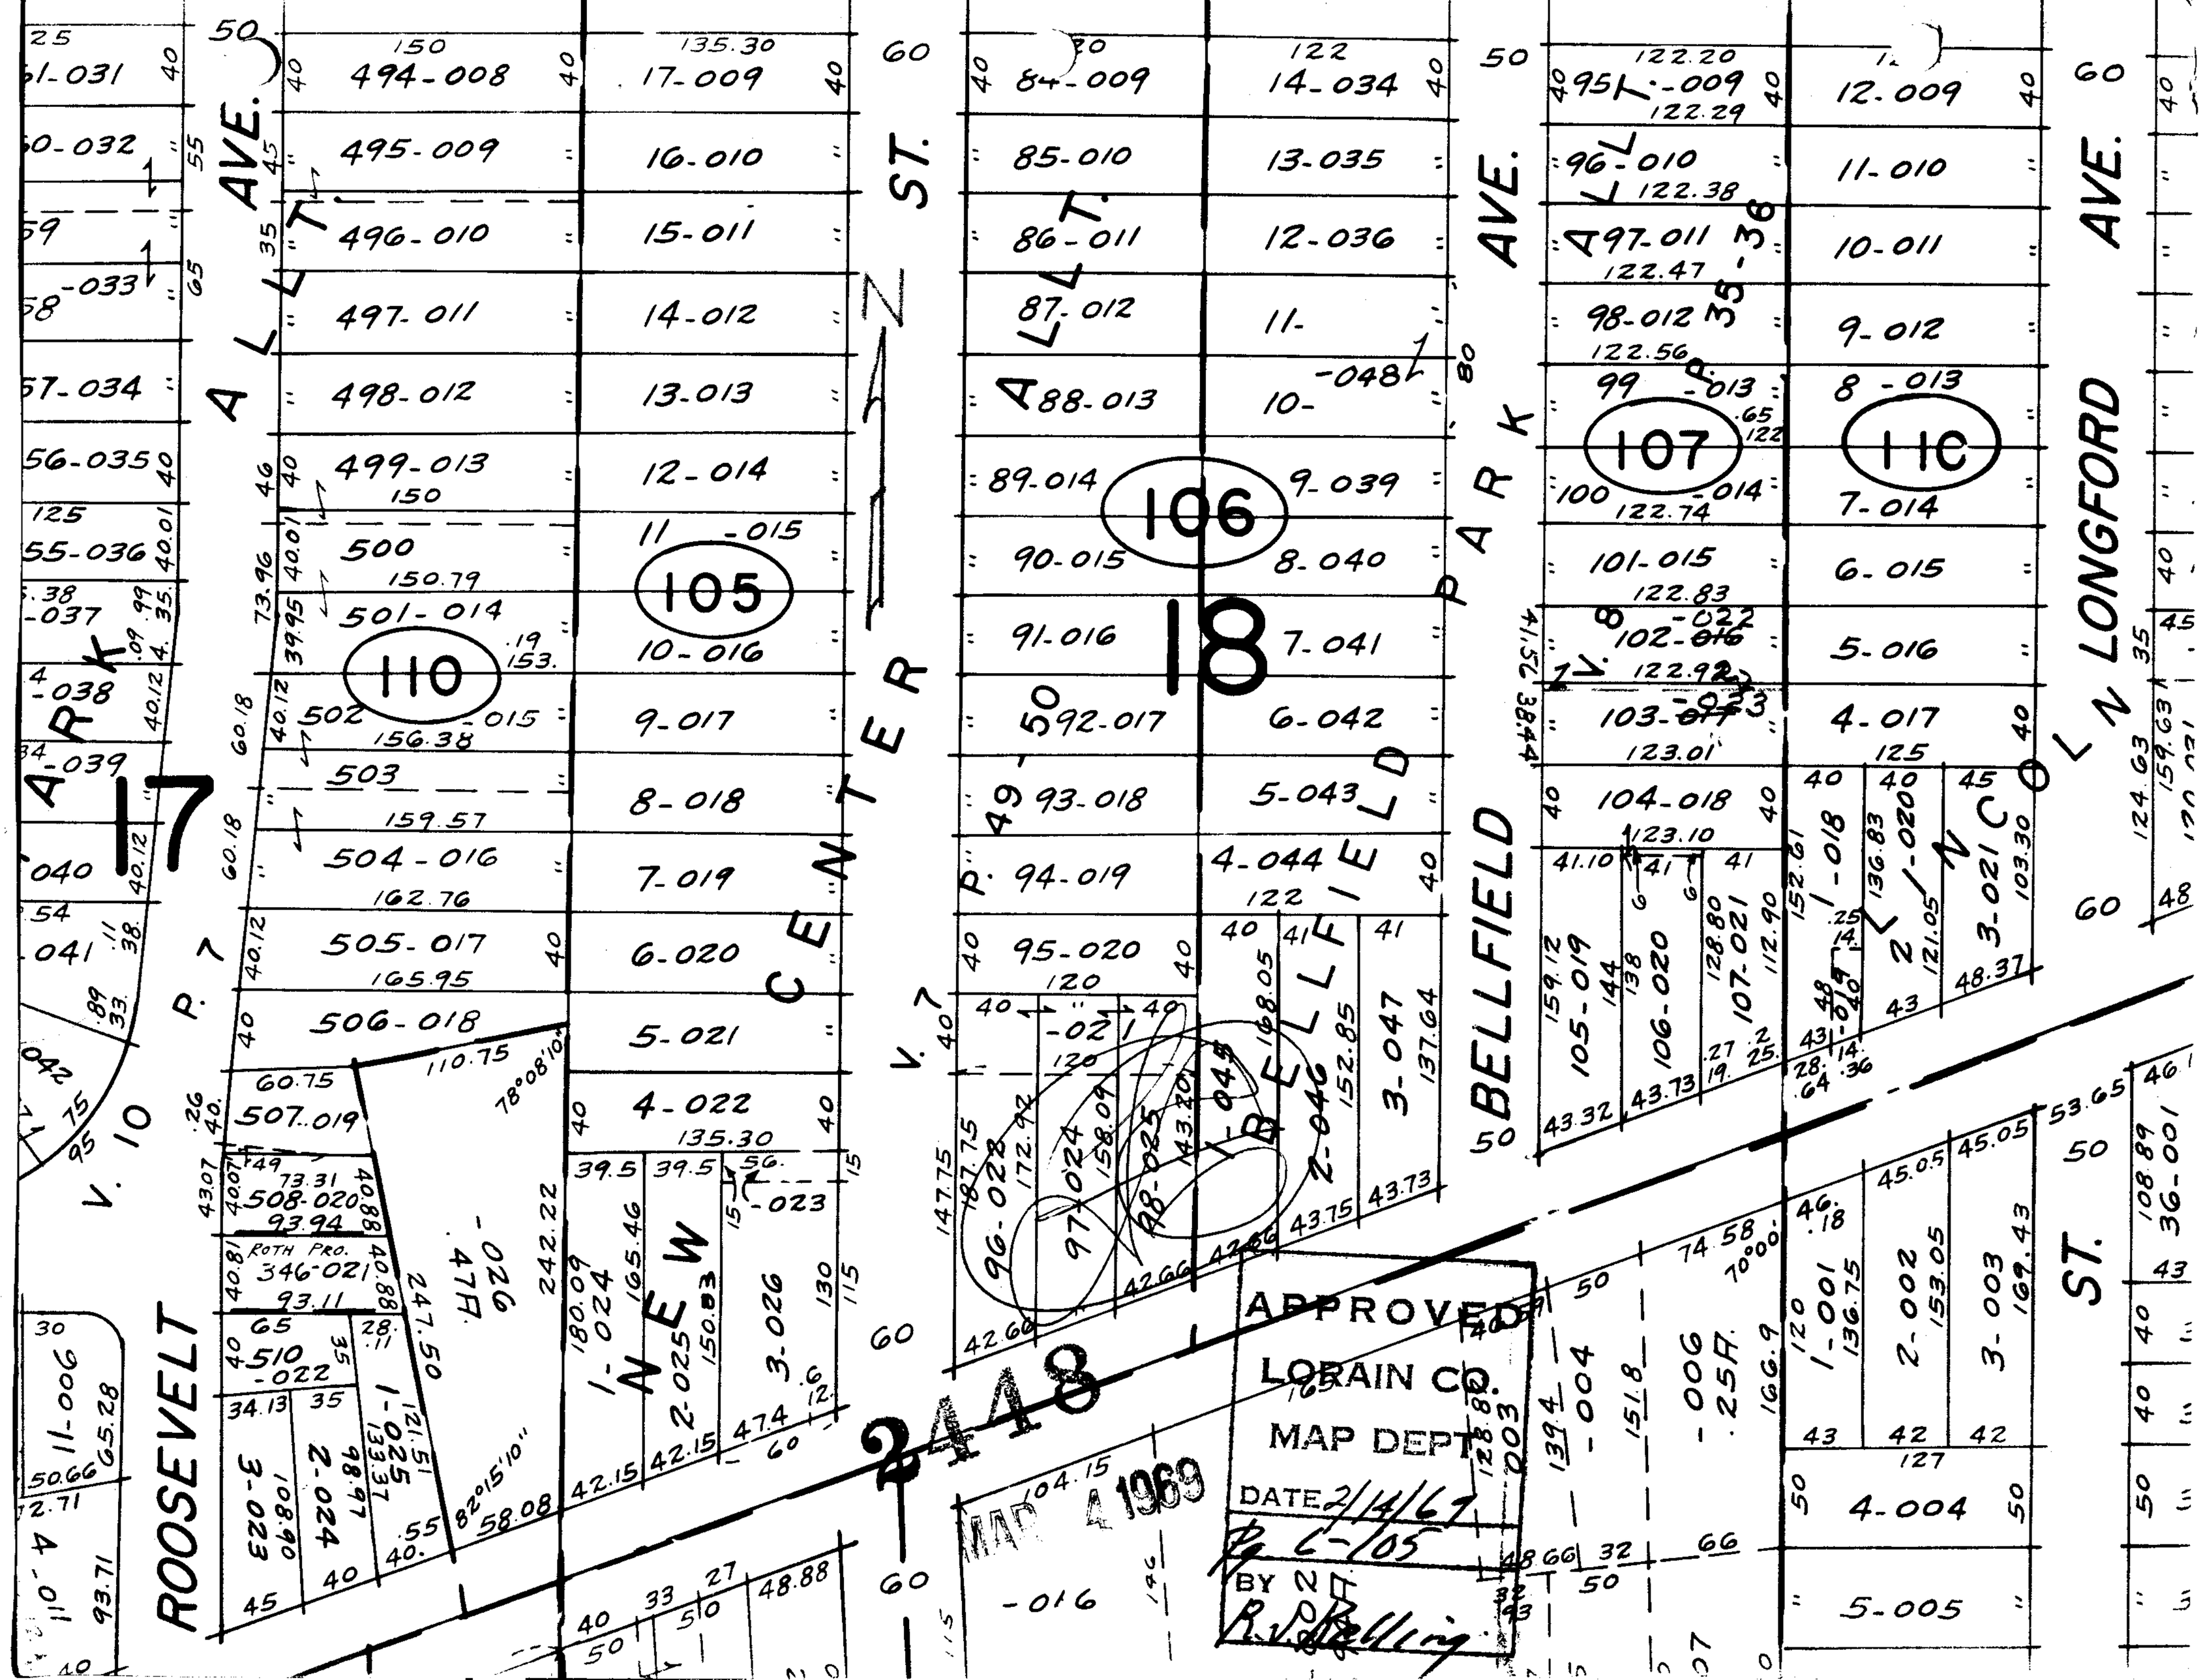

ROOSEVELT
ALLT. AVE.
CENTER ST.
NEW
BELLFIELD PARK AVE.
LONGFORD AVE.
ST.
V. 10 P. 7
V. 7 P. 49-50
V. 8 P. 35-36
17
18
106
105
110
107
110
2448
APPROVED
LORAIN CO.
MAP DEPT.
DATE 2/14/69
Pg. 6-105
BY R.V. Belling
MAR 4 1969