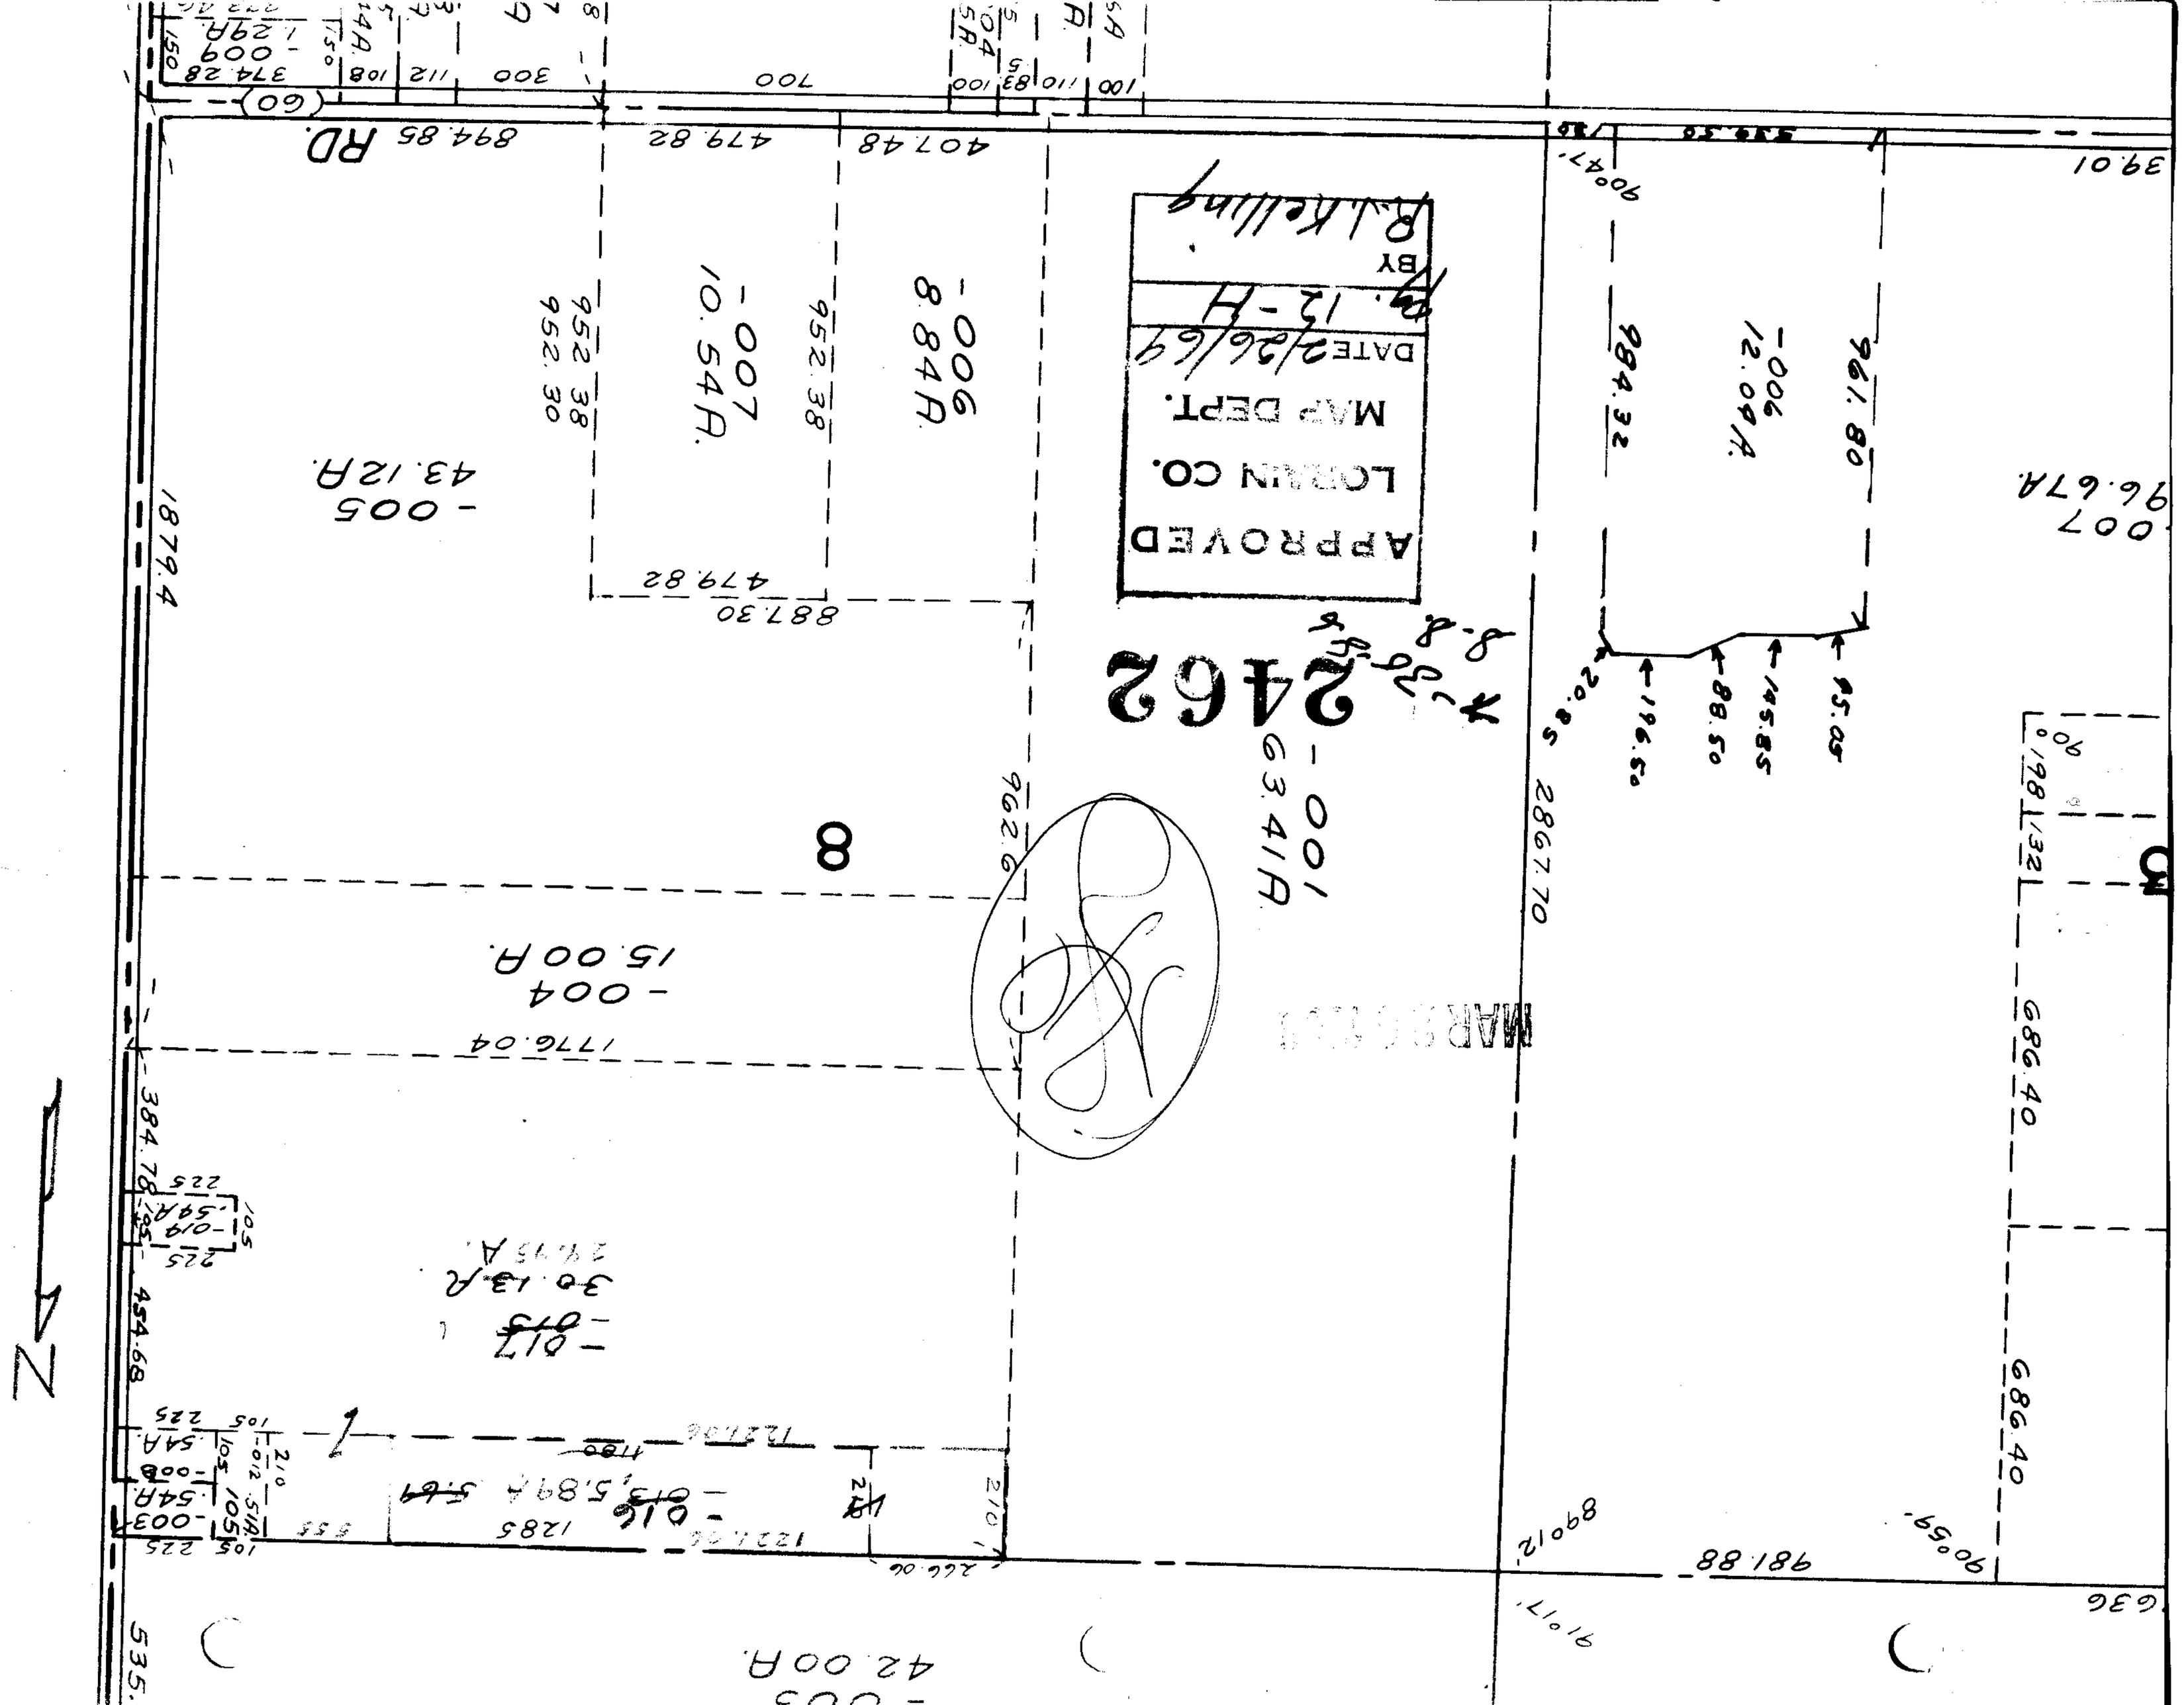

APPROVED
LORAIN CO.
MAP DEPT.
DATE 2/26/69
Pg. 12-H
BY
R.J. Kelling
2462
-001
63.41A.
-004
15.00A.
-005
43.12A.
-006
8.84A.
-007
10.54A.
-006
12.09A.
-007
96.67A.
-005
42.00A.
894.85
RD.
479.82
407.48
952.38
952.30
887.30
962.6
1776.04
1879.4
984.32
961.80
2867.70
686.40
981.88
N