


BELFIELD

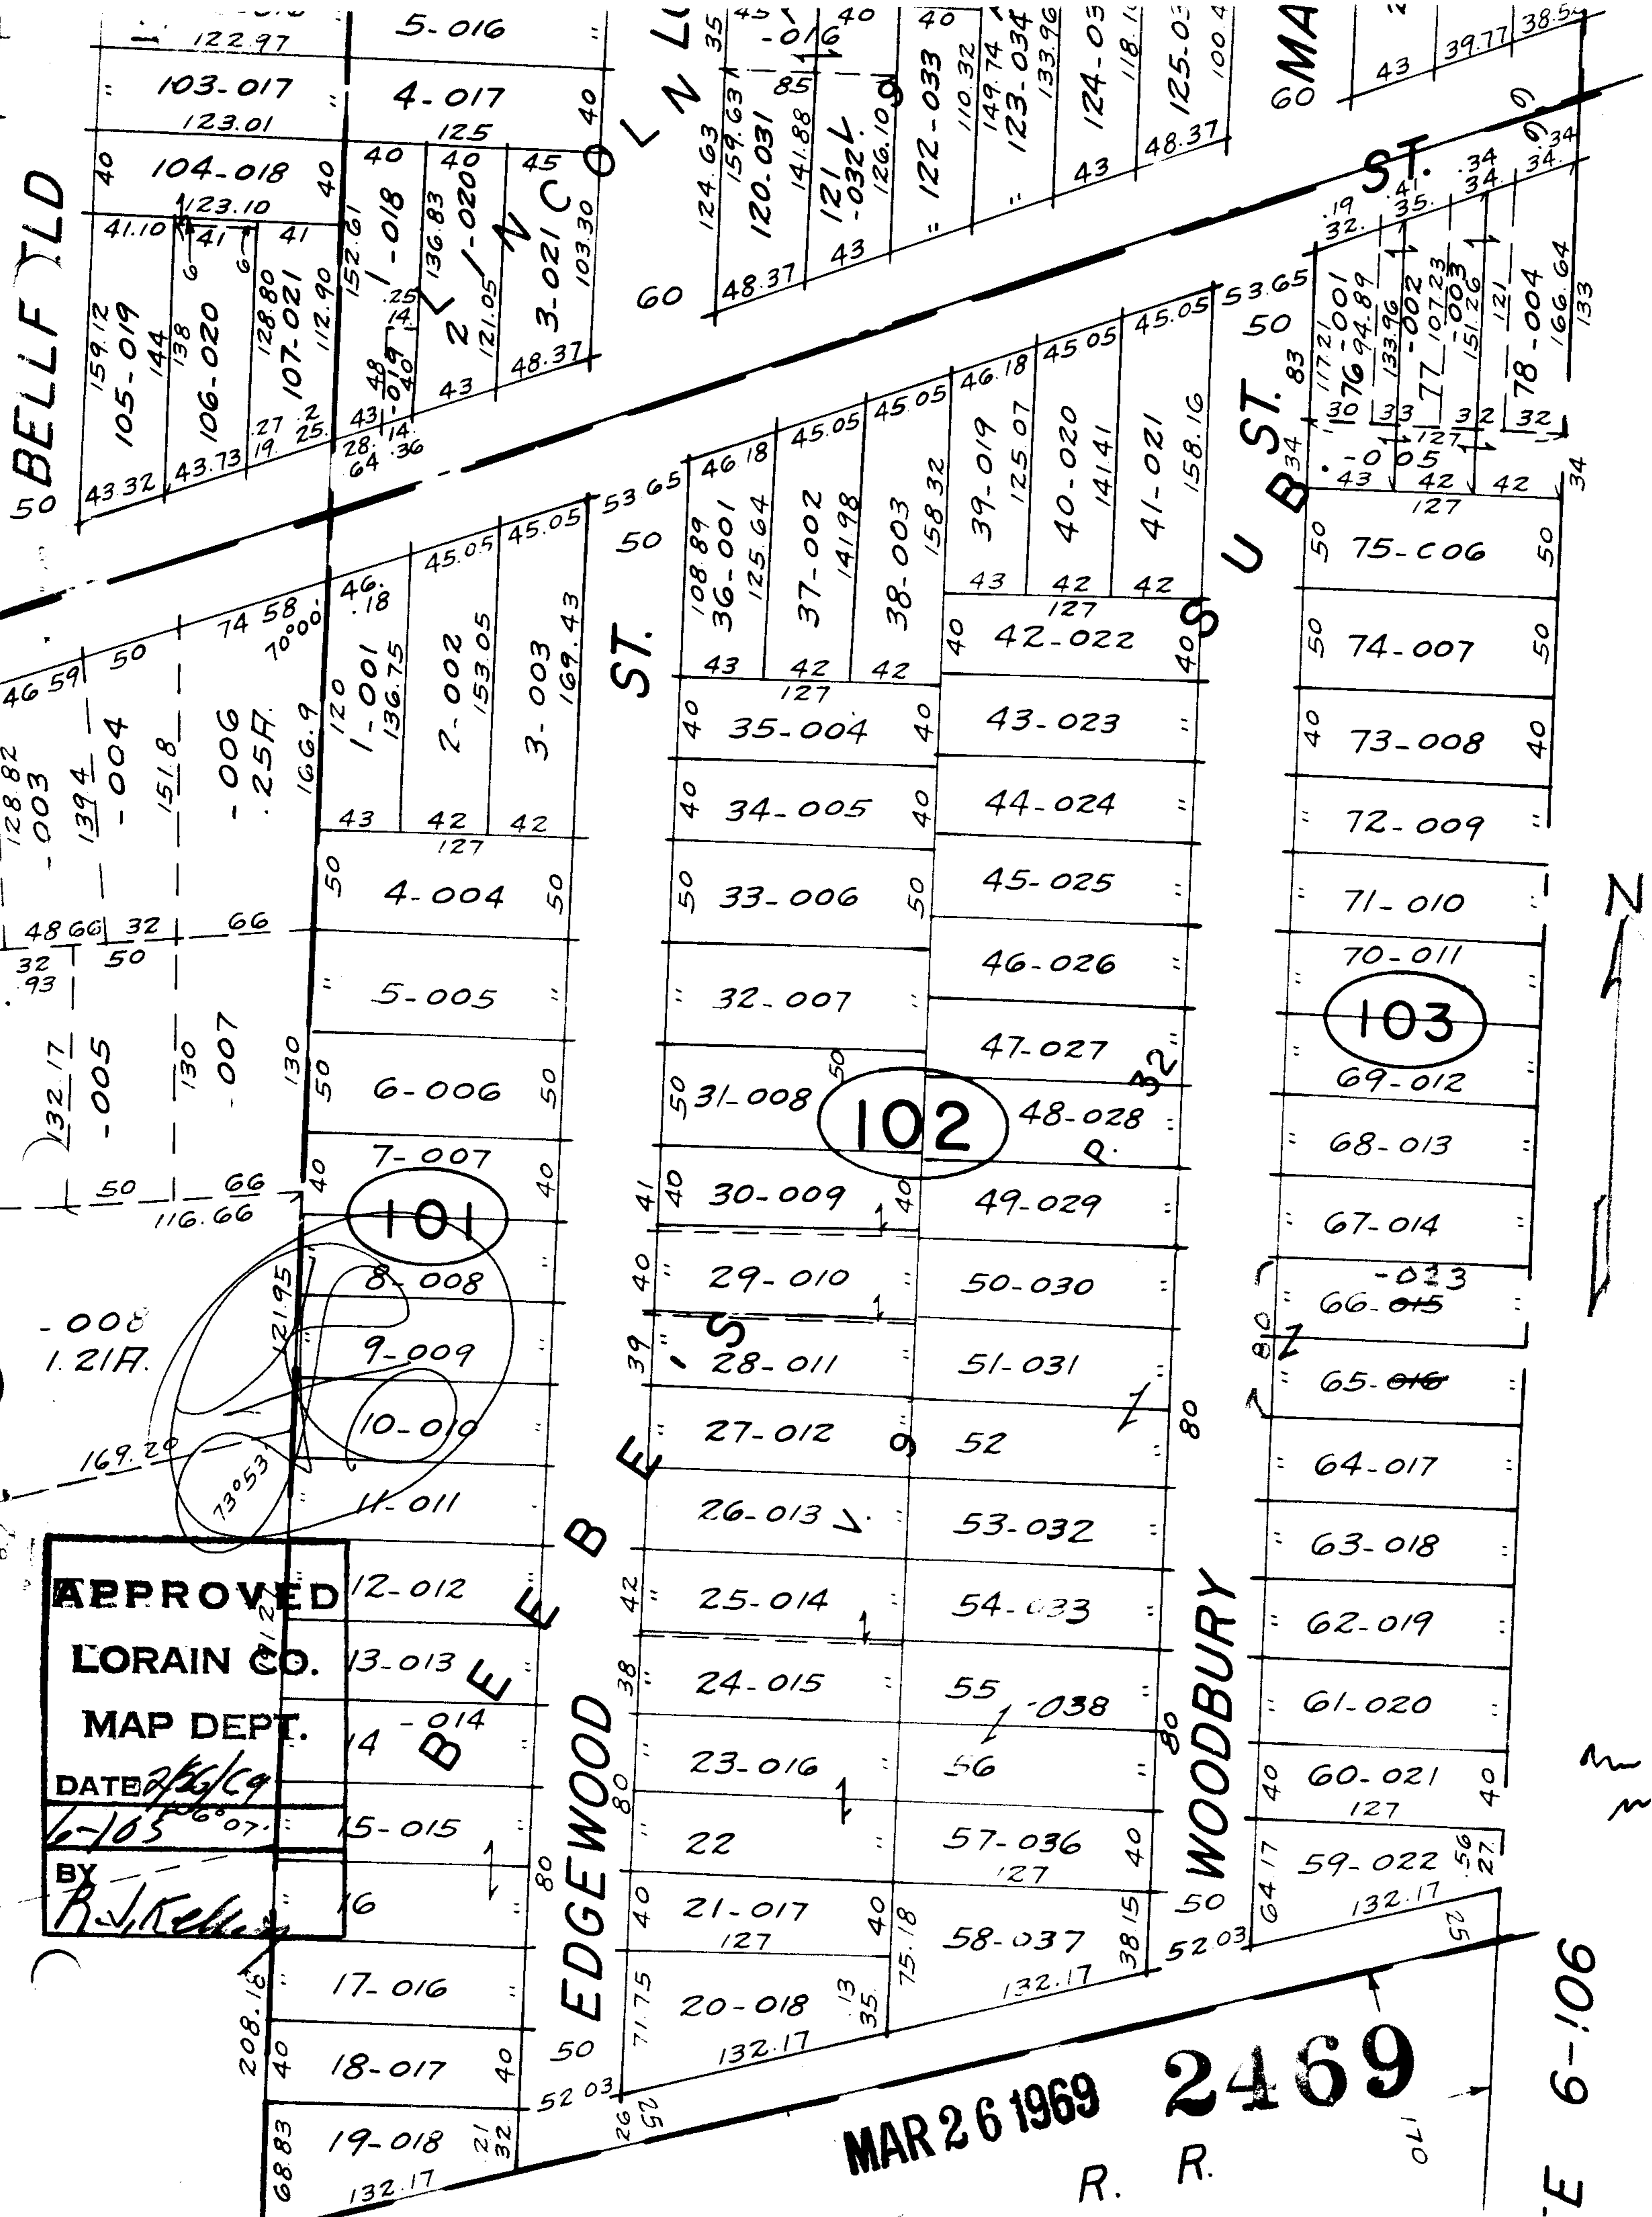

APPROVED
 LORAIN CO.
 MAP DEPT.
 DATE 2/26/69
 6-105
 BY R. J. Kelley

MAR 26 1969

2469

R. R.

E 6-106