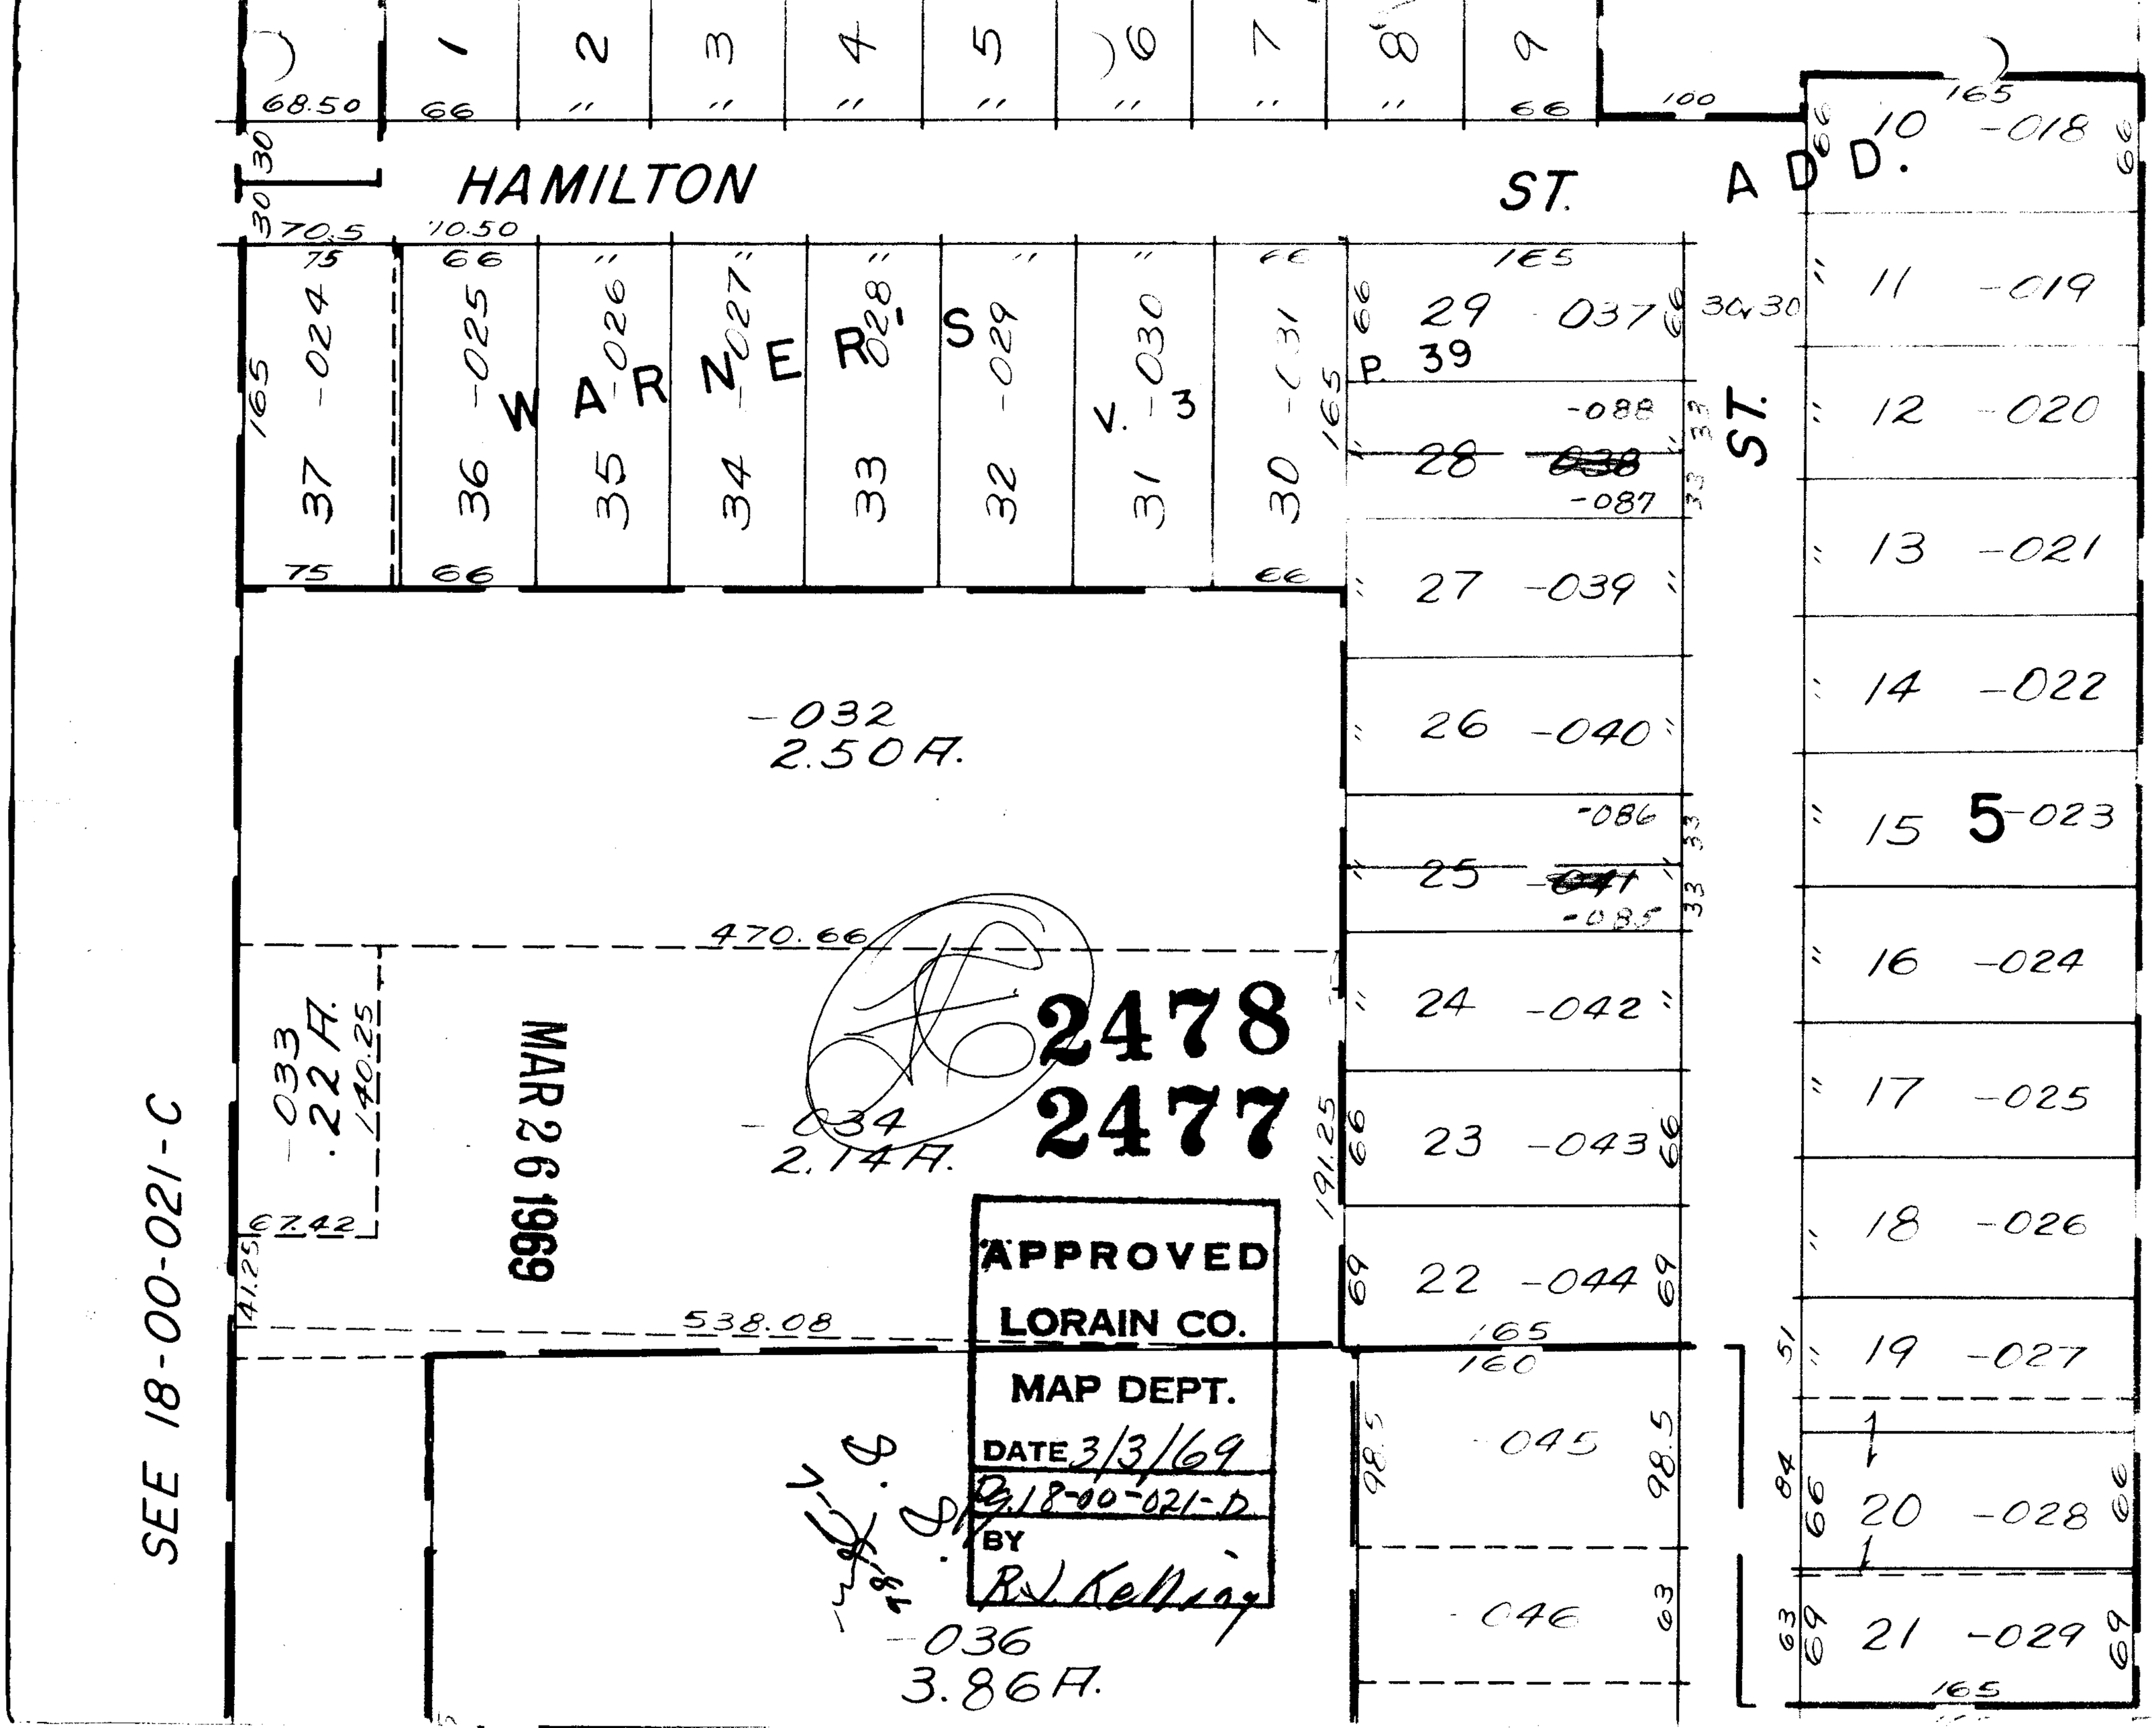
HAMILTON ST.
WARNER'S ADD.
V. 3
P. 39
-032
2.50 A.
-033
.22 A.
-034
2.14 A.
-036
3.86 A.
470.66
538.08
191.25
2478
2477
MAR 26 1969
APPROVED
LORAIN CO.
MAP DEPT.
DATE 3/3/69
Pg. 18-00-021-D
BY
R.J. Kelling
SEE 18-00-021-C
5