


MAR 26 1968

S.S. 78-41-7  
BY  
P. 100-002-B  
DATE 3/6/69  
MAP DEPT.  
LORAIN CO.  
APPROVED  
23-025  
25-026  
27-027

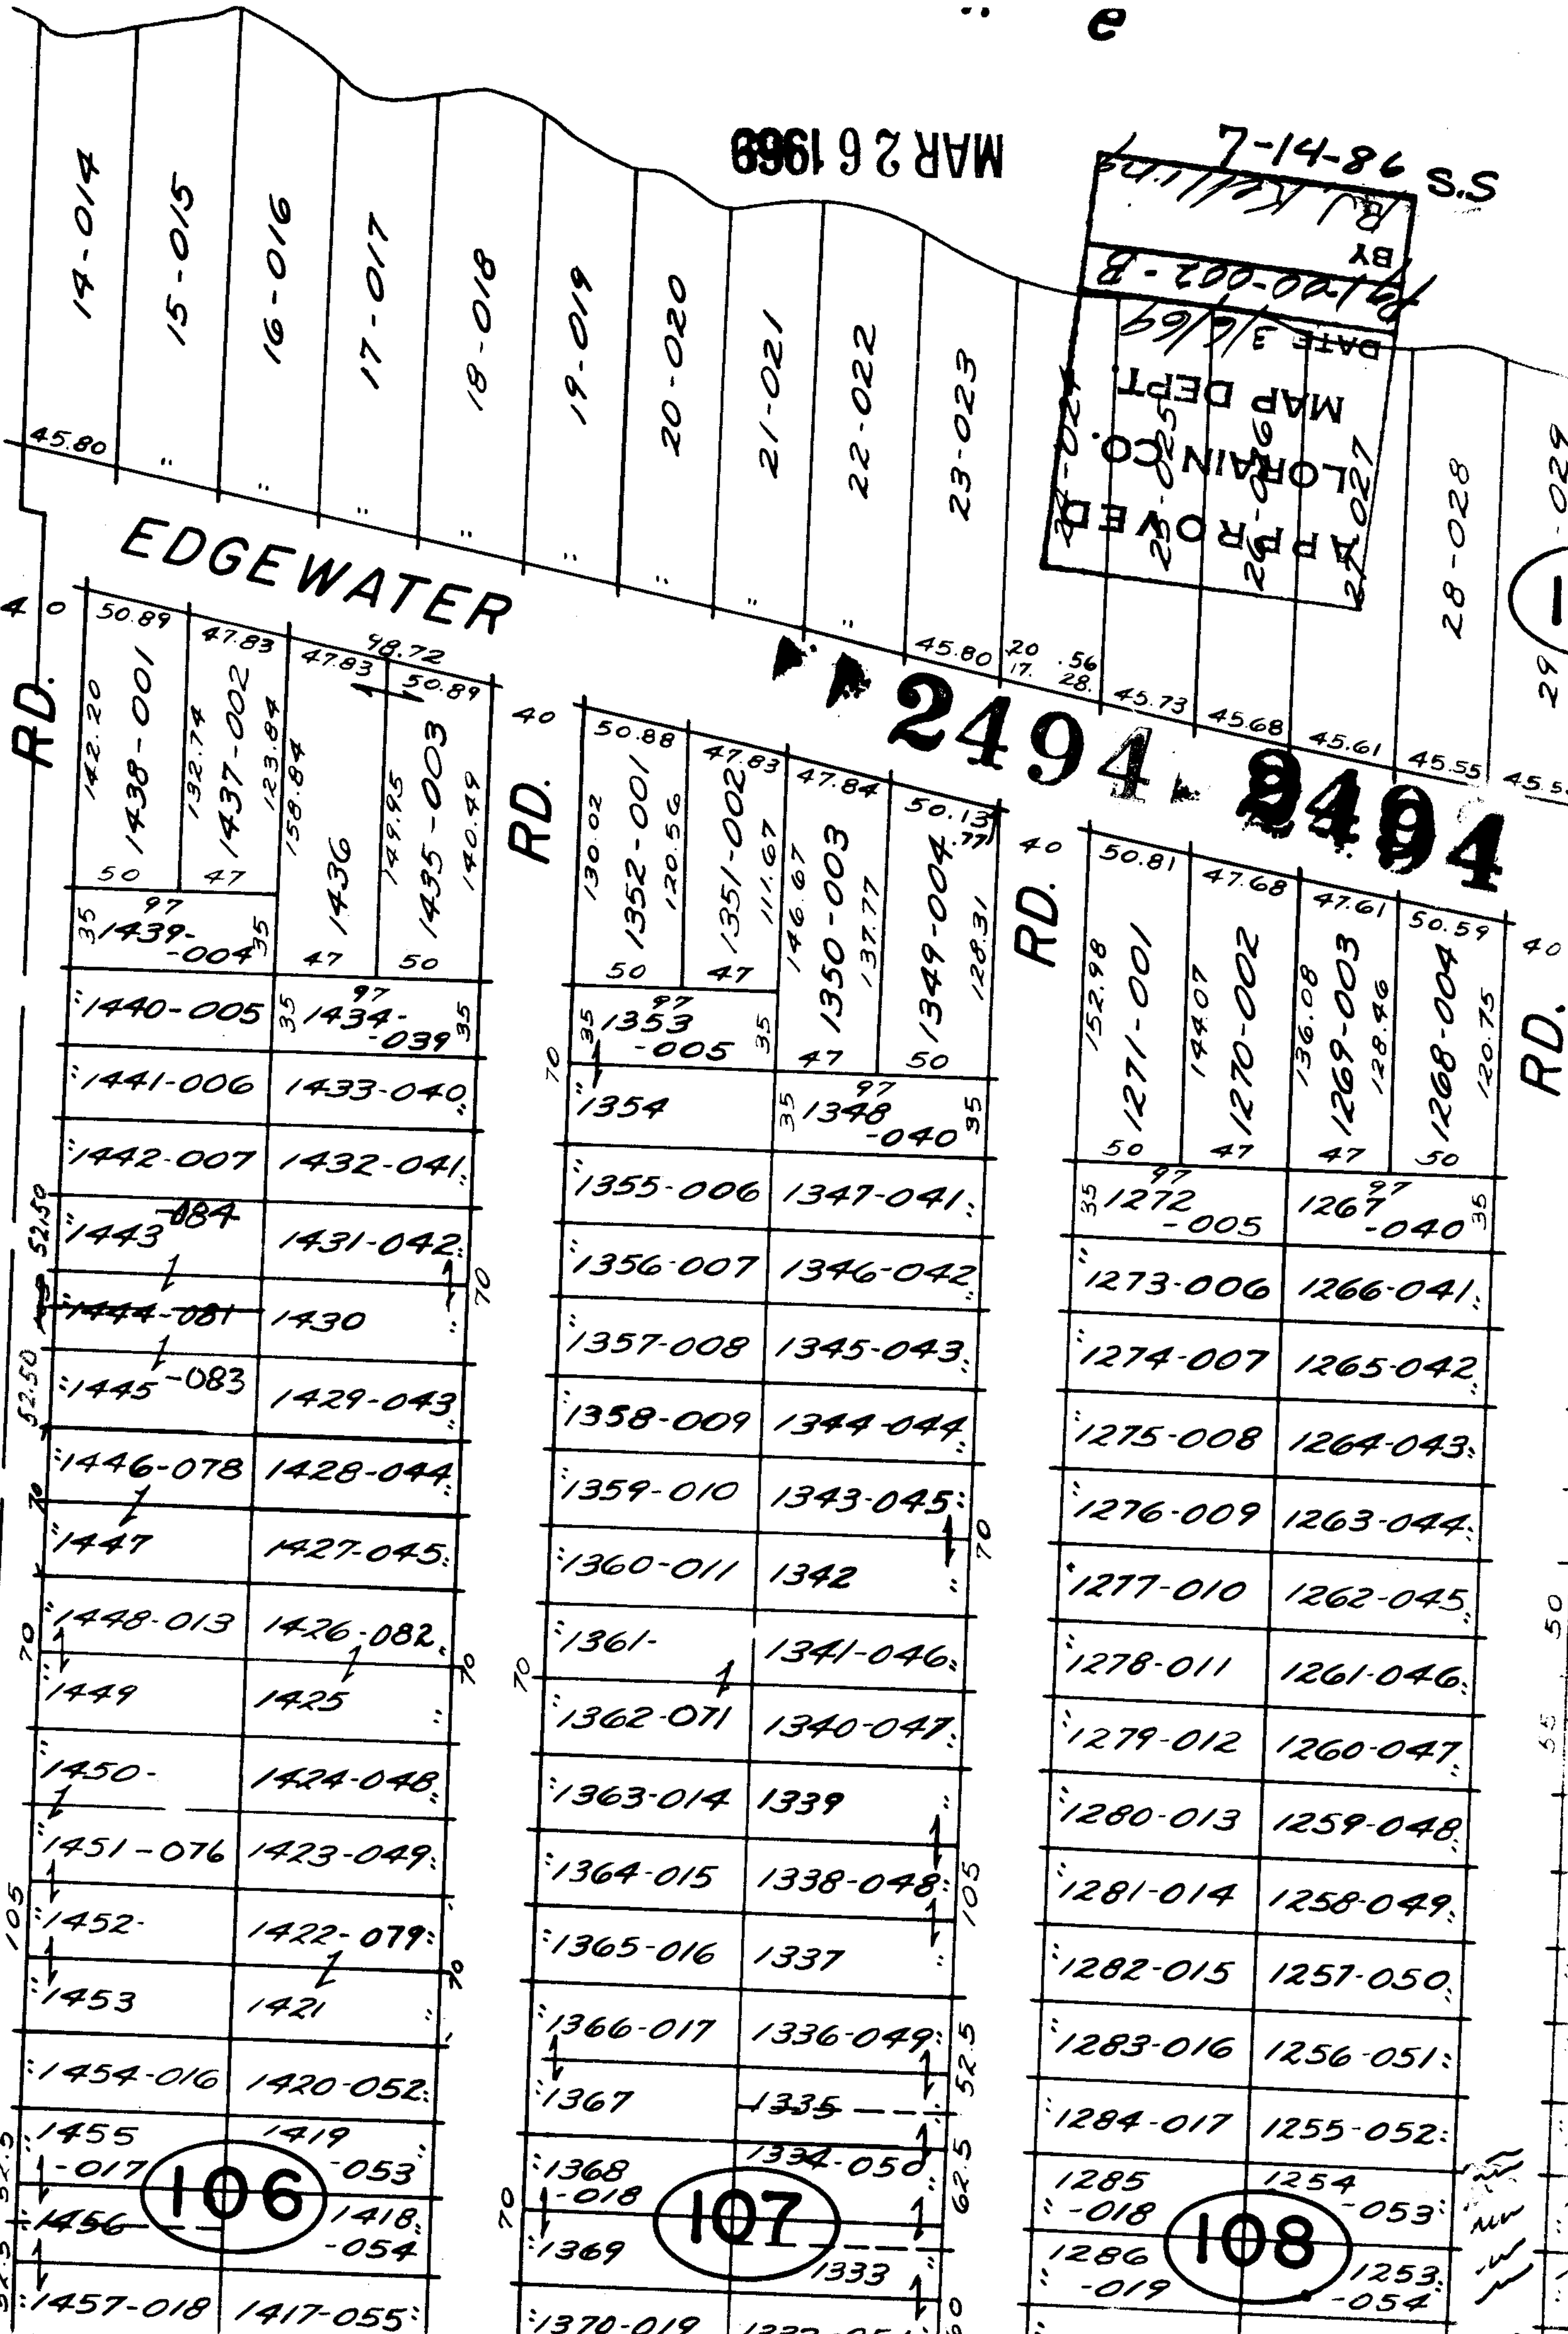

EDGEWATER

2494 9494

RD.

RD.

RD.

RD.

1-00-002-A

106

107

108

