PARENT PARCEL: 04-00-015-109-163

CHILD PARCEL: 04-00-015-109-186 & -187 6-WD LOR-SR 254-05.66

STARTING POINT: 5/8 " I.P. FD., CL OF DETROIT RD. & CL OF HEALTHWAY DR.

25-00829

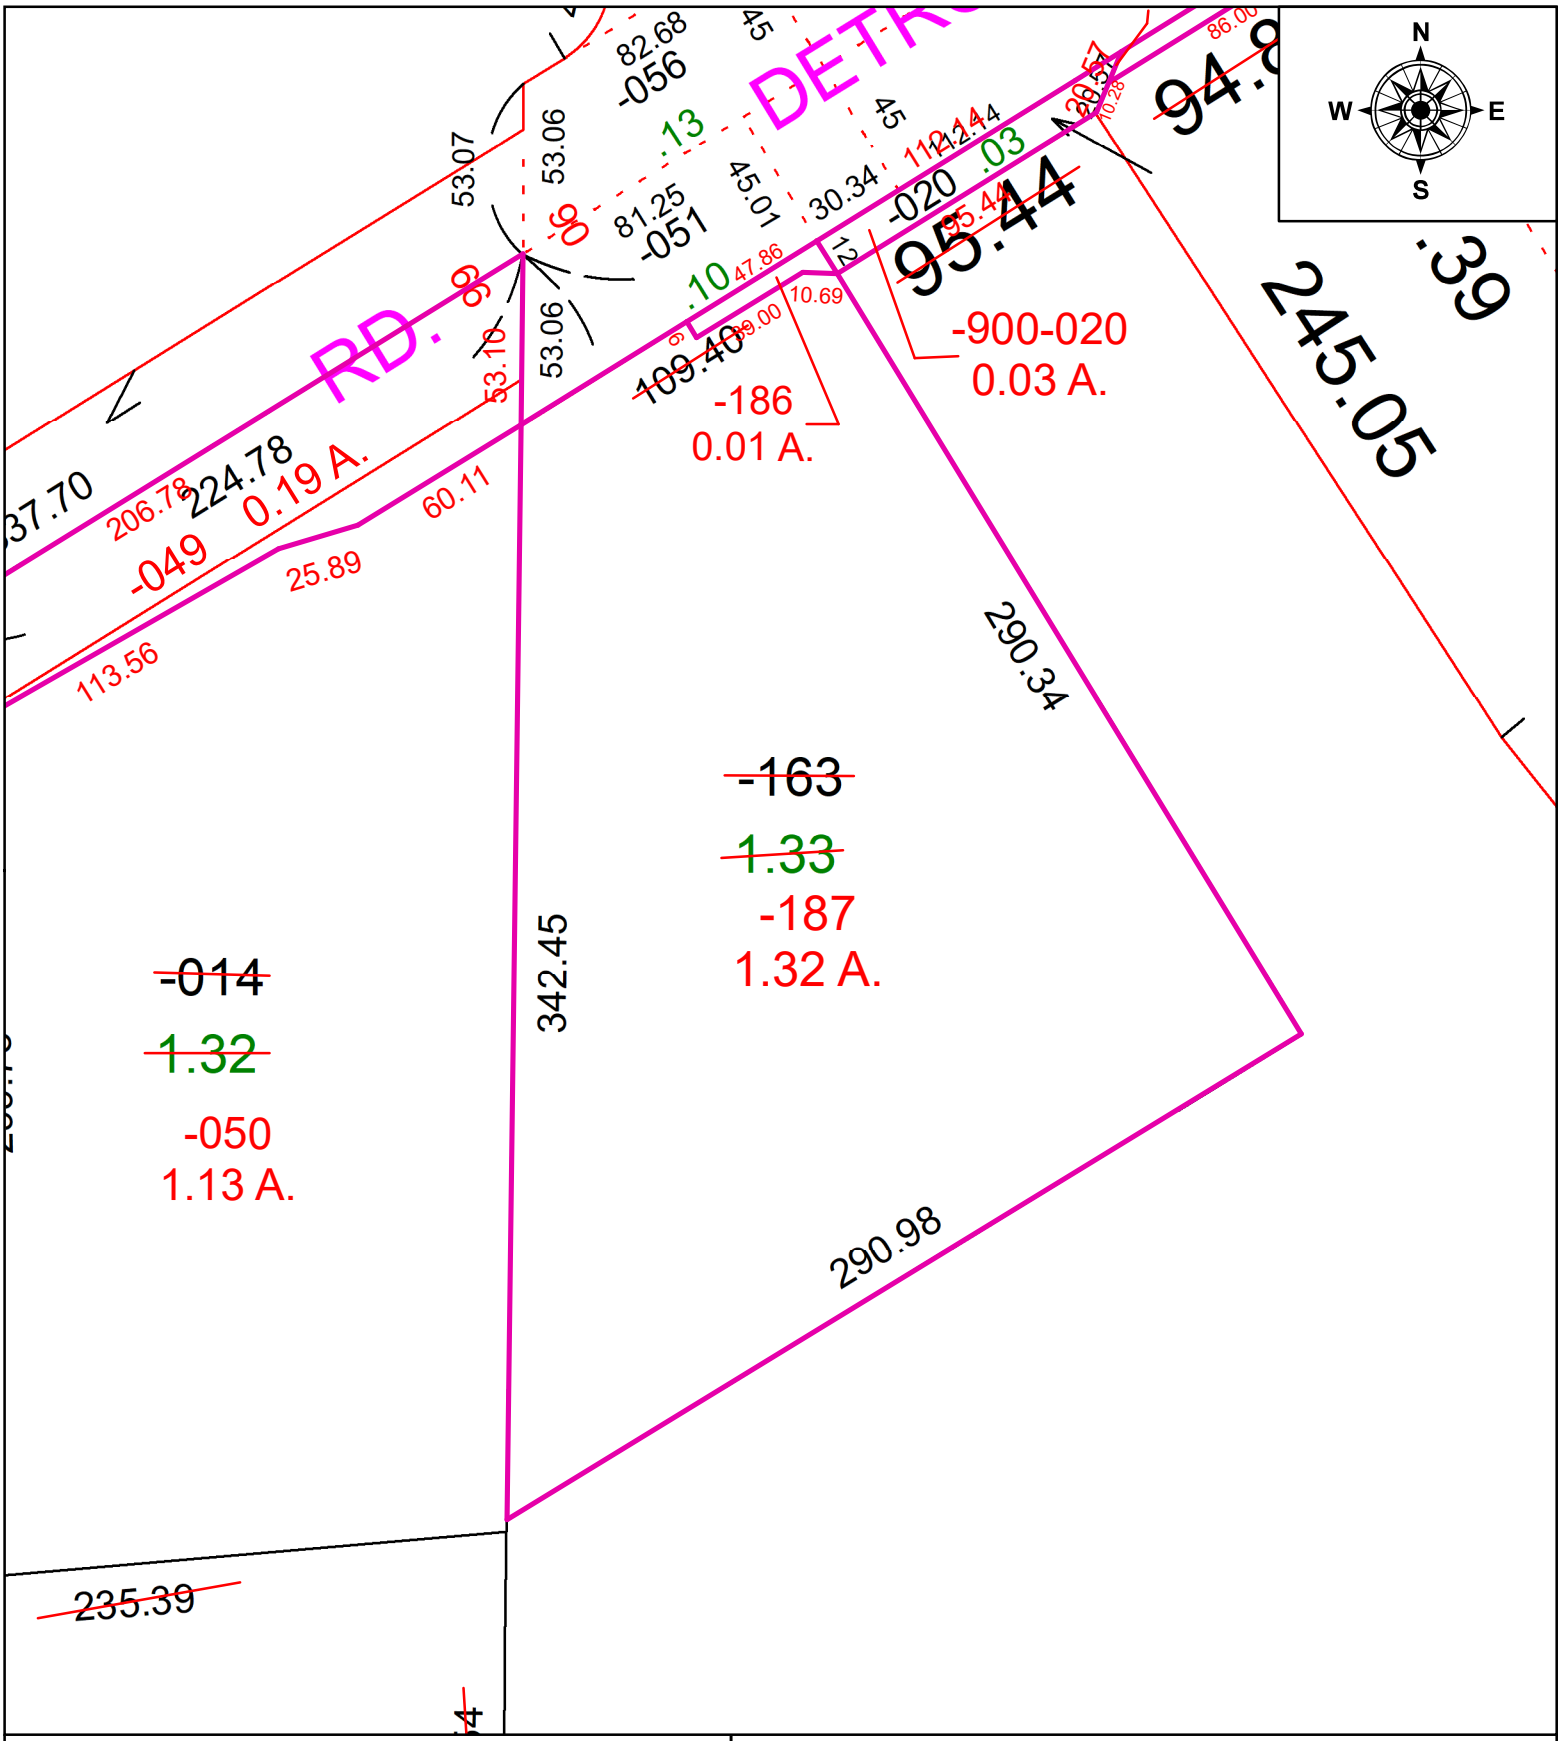

SPLITS/DEEDS PROCESSED

LORAIN COUNTY TAX MAP DEPARTMENT
226 MIDDLE AVE. ELYRIA, OH

SURVEYED BY: DONALD SHEEHY
CLOSURE: 1:53524
MAP PAGE(S): 4-00-015
APPOVED BY: TJS **DATE:** 3/10/2025
SCALE: 1" = 60' **PRIOR INSTRUMENT:** 2008-0242282 & 3