PARENT PARCEL: 04-00-015-110-283

CHILD PARCEL: 04-00-015-110-323 & -324 36-WD LOR-SR 254-05.66 CL PV, 116 PG. 26

STARTING POINT: MAG. NAIL, CL OF DETROIT & STA 184+40.69

25-00835

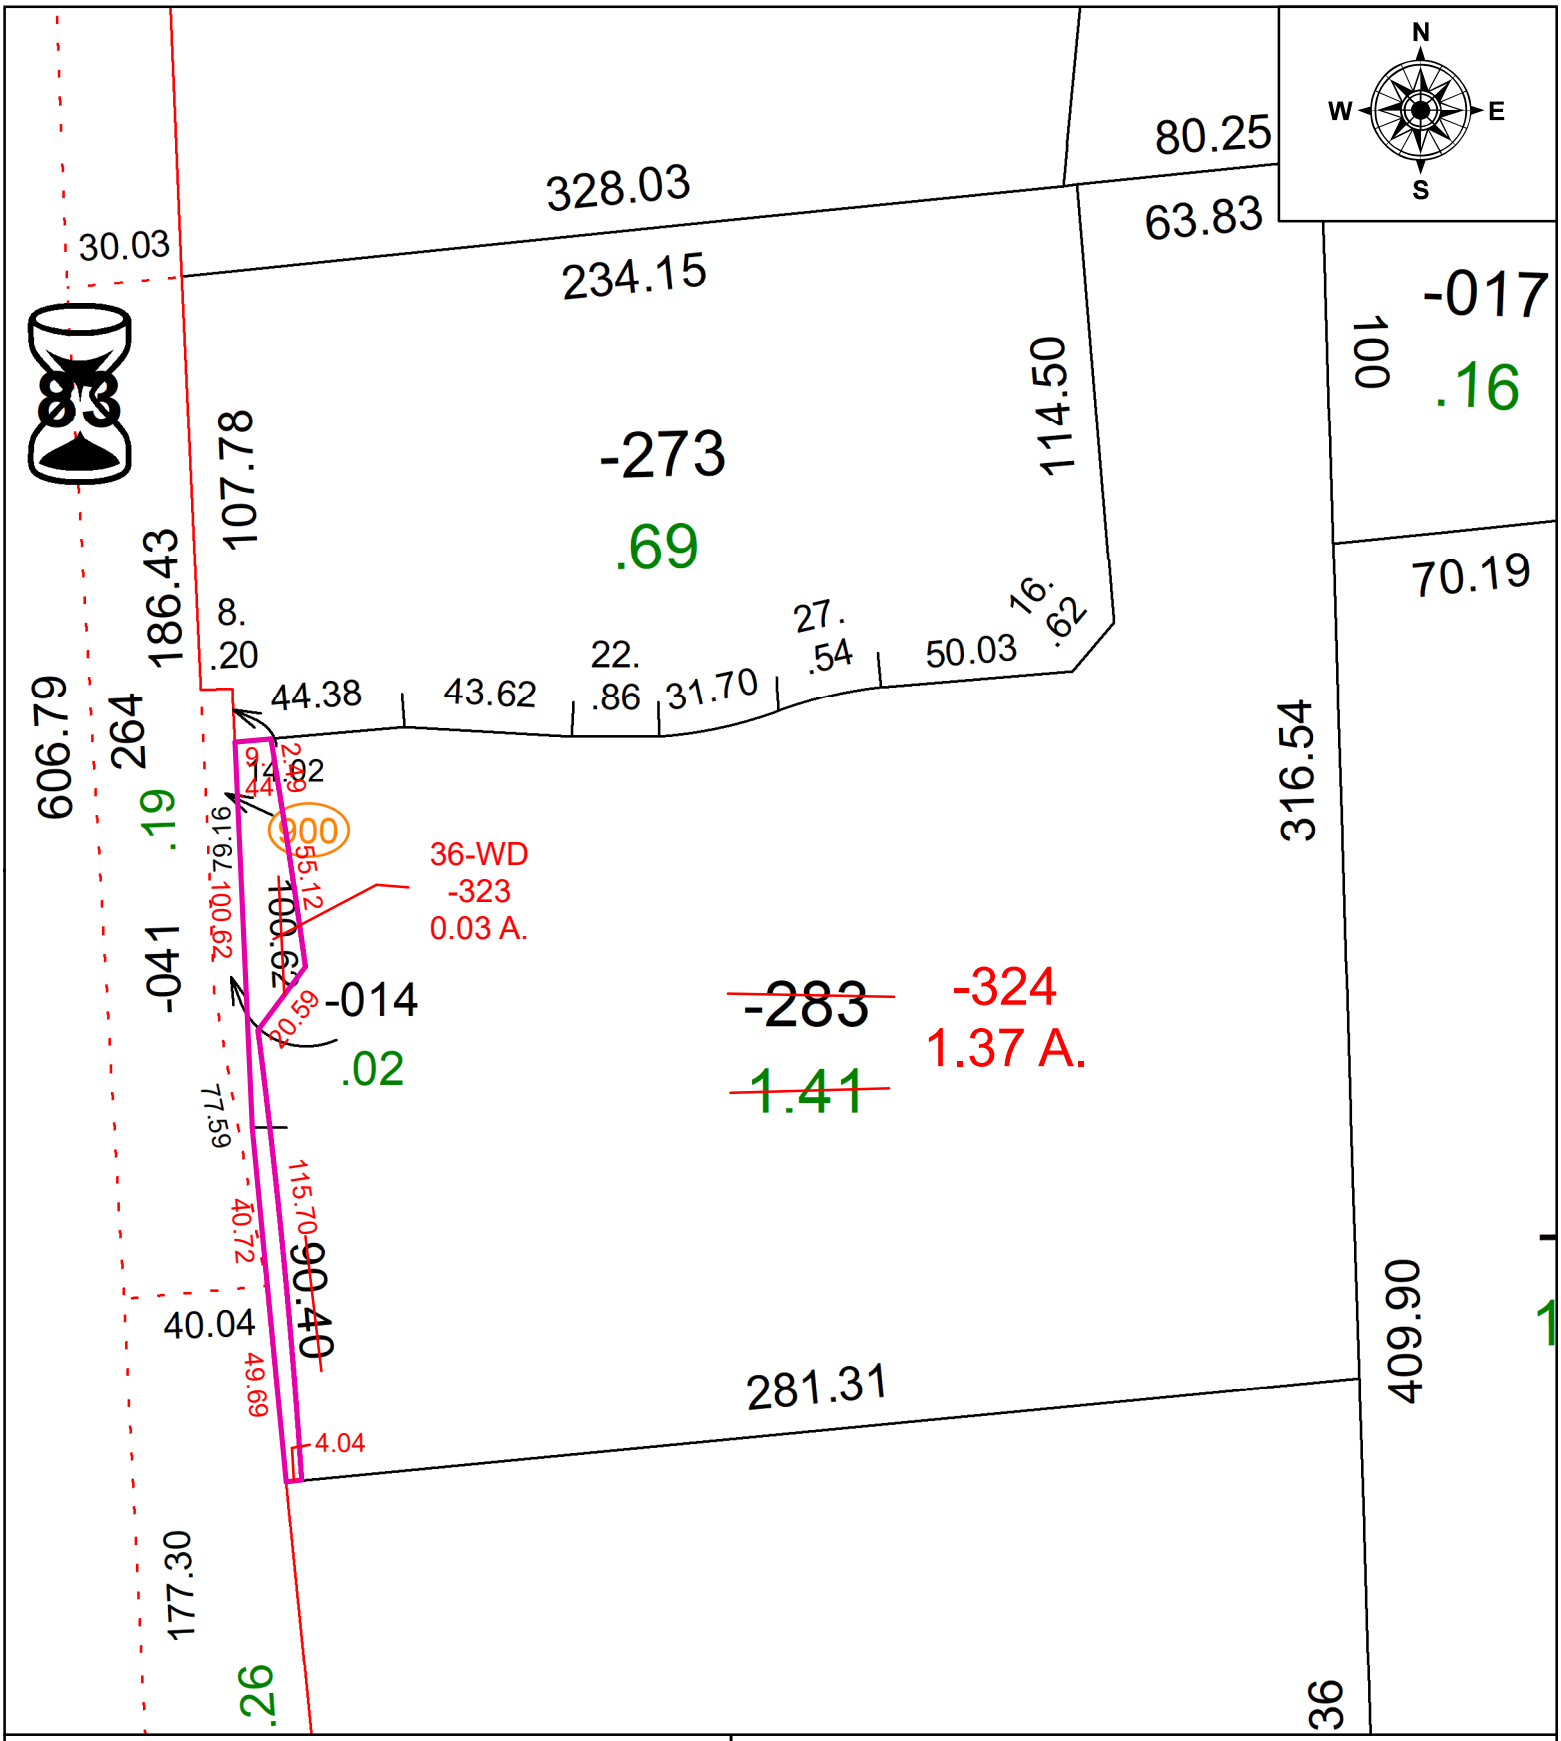

SPLITS/DEEDS PROCESSED

LORAIN COUNTY TAX MAP DEPARTMENT
226 MIDDLE AVE. ELYRIA, OH

SURVEYED BY: DONALD SHEEHY
CLOSURE: 1: INF
MAP PAGE(S): 04-00-015
APPOVED BY: TJS **DATE:** 3/27/2025
SCALE: 1" = 50' **PRIOR INSTRUMENT:** 2016-0610654