PARENT PARCEL: 03-00-038-101-048

CHILD PARCEL: 03-00-038-101-085 & -086 15-WD LOR-US-6-14.19

STARTING POINT: MAG. NAIL, CL OF LAKE RD. & CL OF HARRIS RD.

25-00838

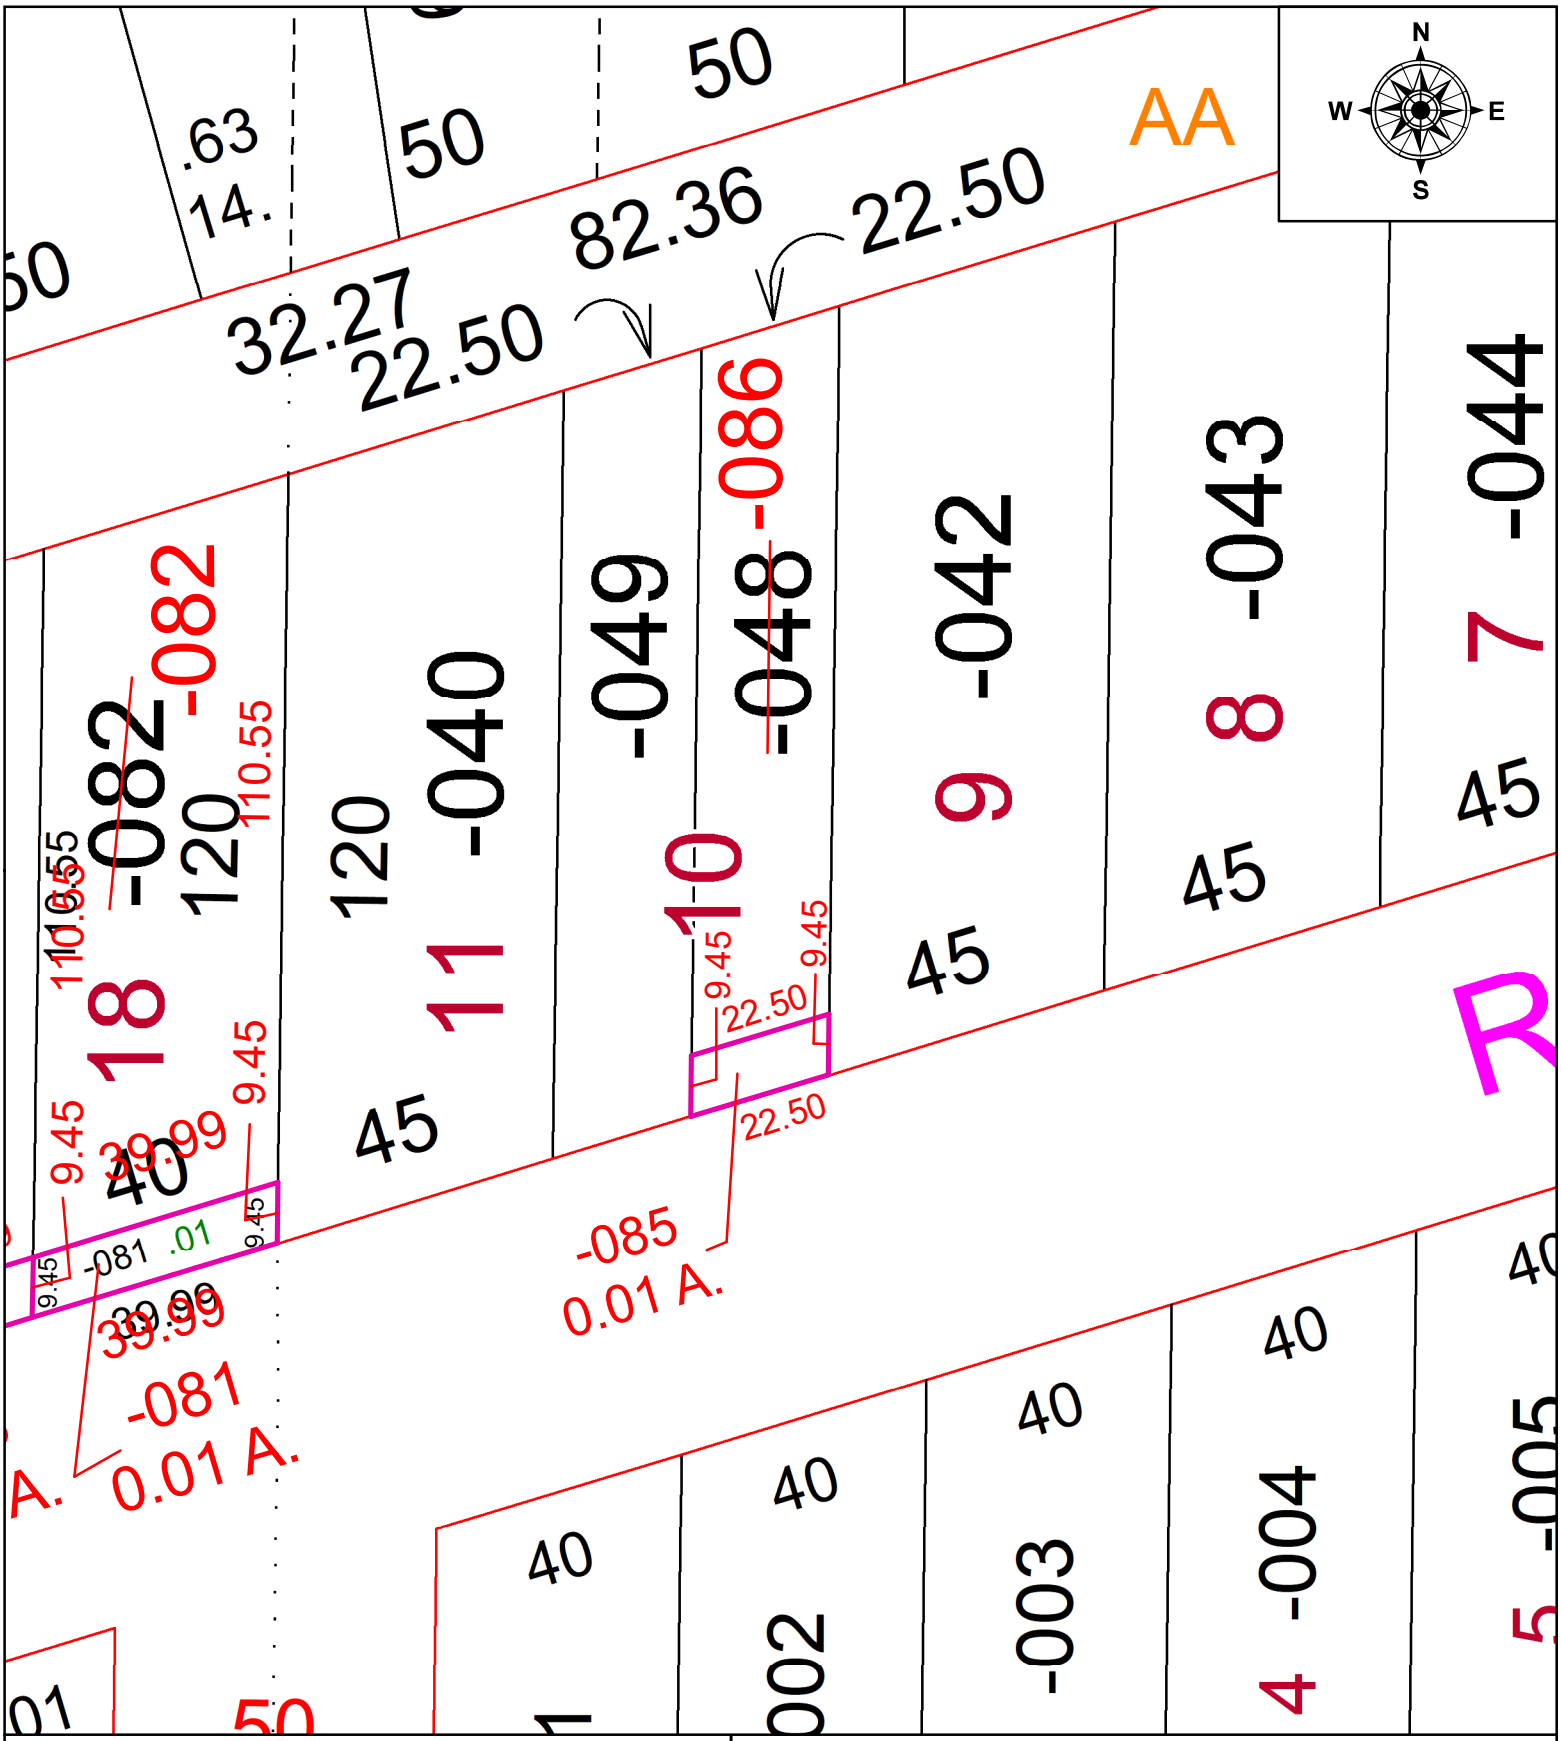

SPLITS/DEEDS PROCESSED

LORAIN COUNTY TAX MAP DEPARTMENT
226 MIDDLE AVE. ELYRIA, OH

SURVEYED BY: AMY KELLY
CLOSURE: 1: INF
MAP PAGE(S): 03-00-038
APPOVED BY: TJS **DATE:** 4/1/2025
SCALE: 1" = 30' **PRIOR INSTRUMENT:** 2017-0629720