PARENT PARCEL: 04-00-014-104-021

CHILD PARCEL: 04-00-014-104-094 & -095 22-WD LOR-83-1676

STARTING POINT: I.P. MON. BOX, EAST ROW OF CENER RD (S.R. 83) & CL WINDEMERE WAY

25-00849

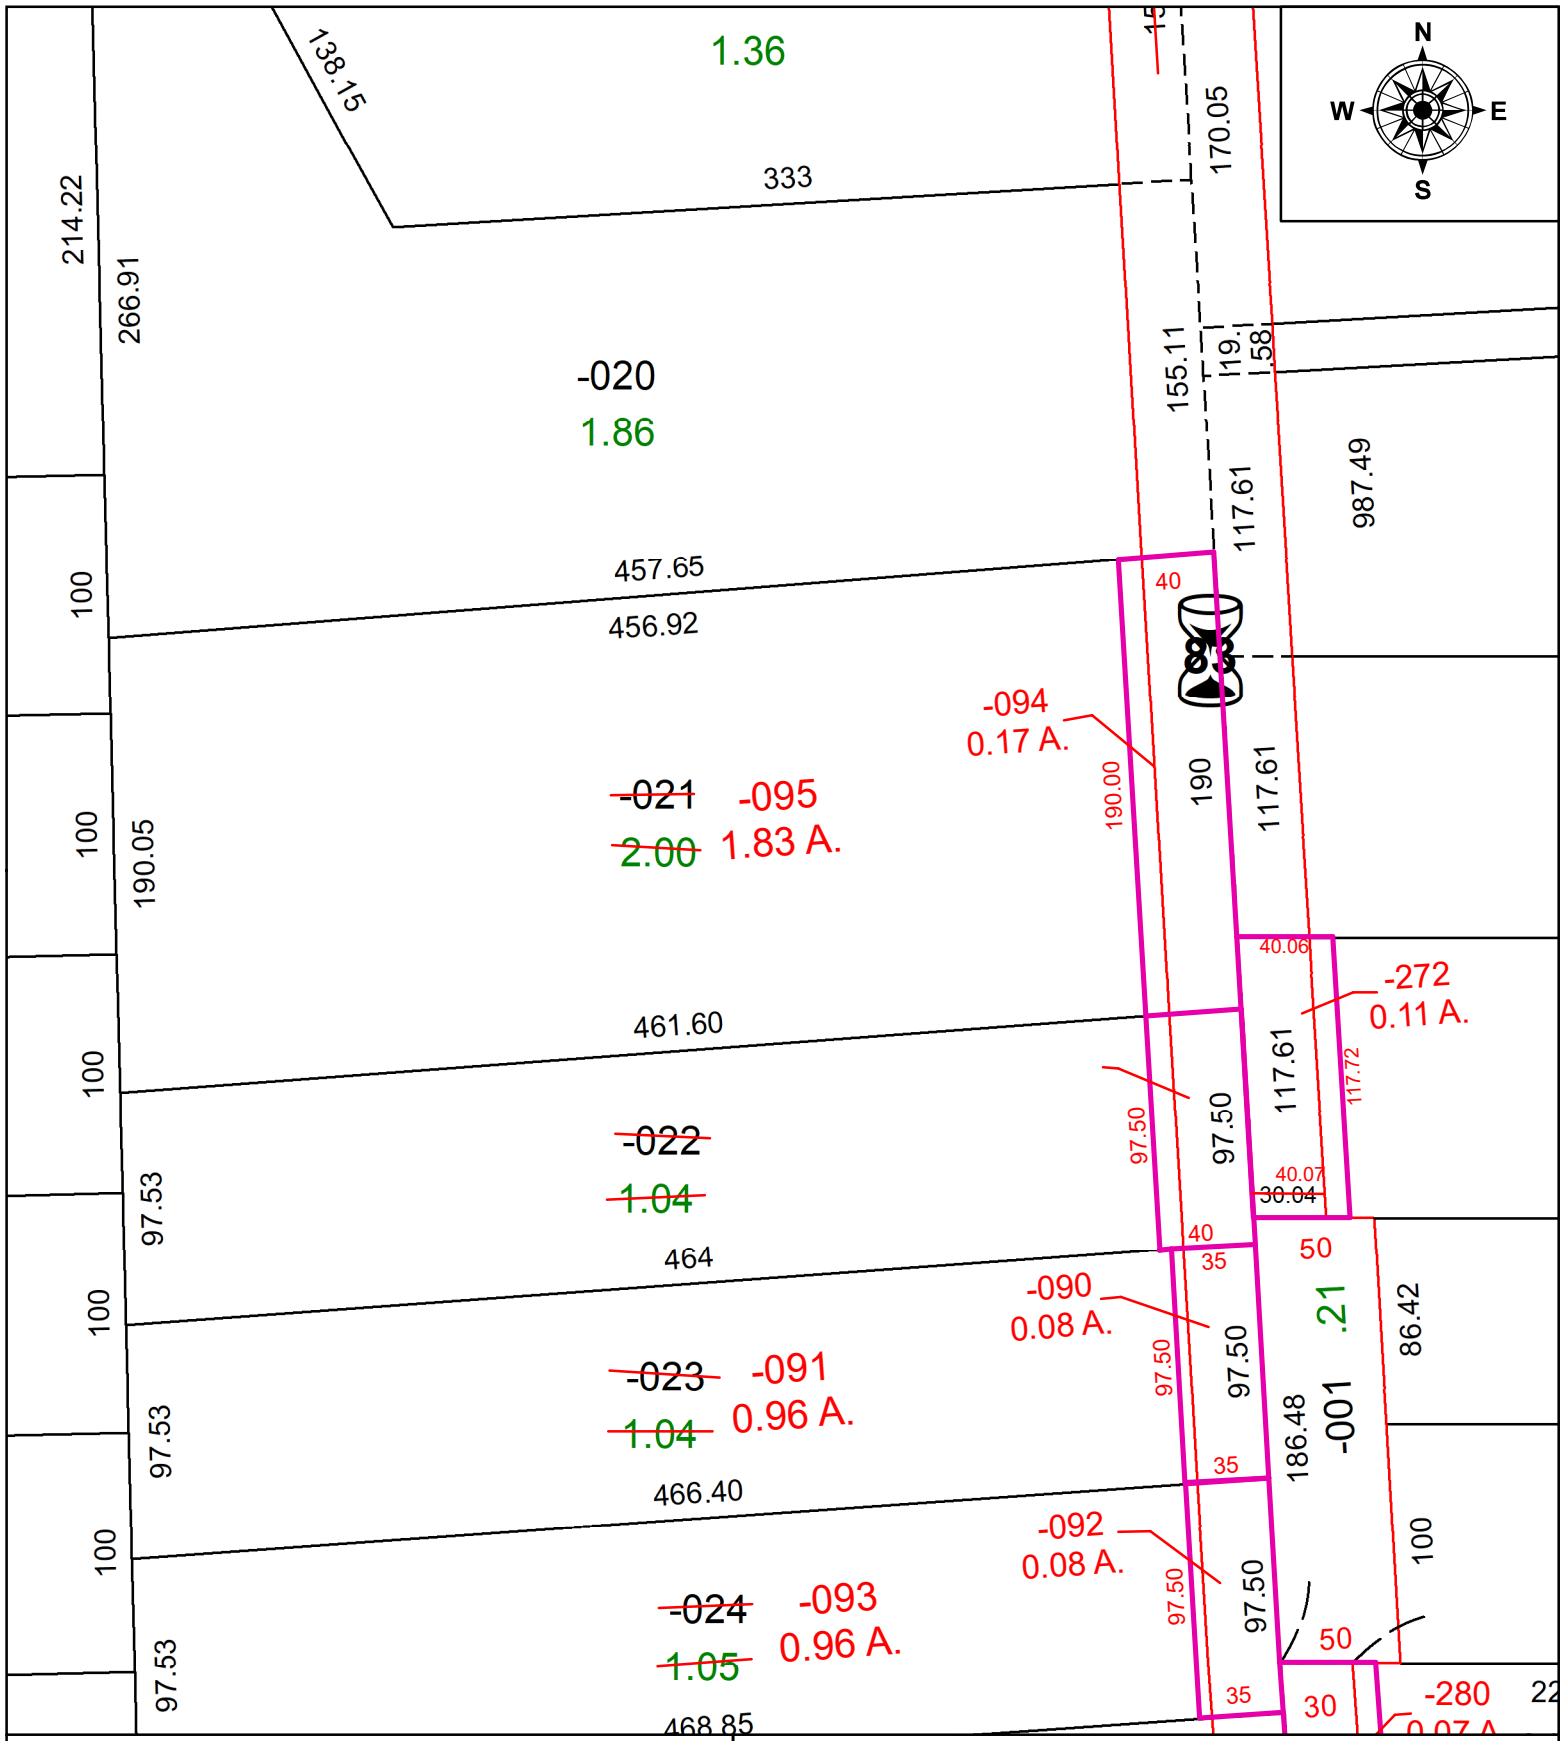

SPLITS/DEEDS PROCESSED

LORAIN COUNTY TAX MAP DEPARTMENT
226 MIDDLE AVE. ELYRIA, OH

SURVEYED BY: DONALD SHEEHY
CLOSURE: 1: INF
MAP PAGE(S): 04-00-014
APPOVED BY: TJS **DATE:** 4/11/2025
SCALE: 1" = 80' **PRIOR INSTRUMENT:** 2002-0804390